


Elywood N^o 1

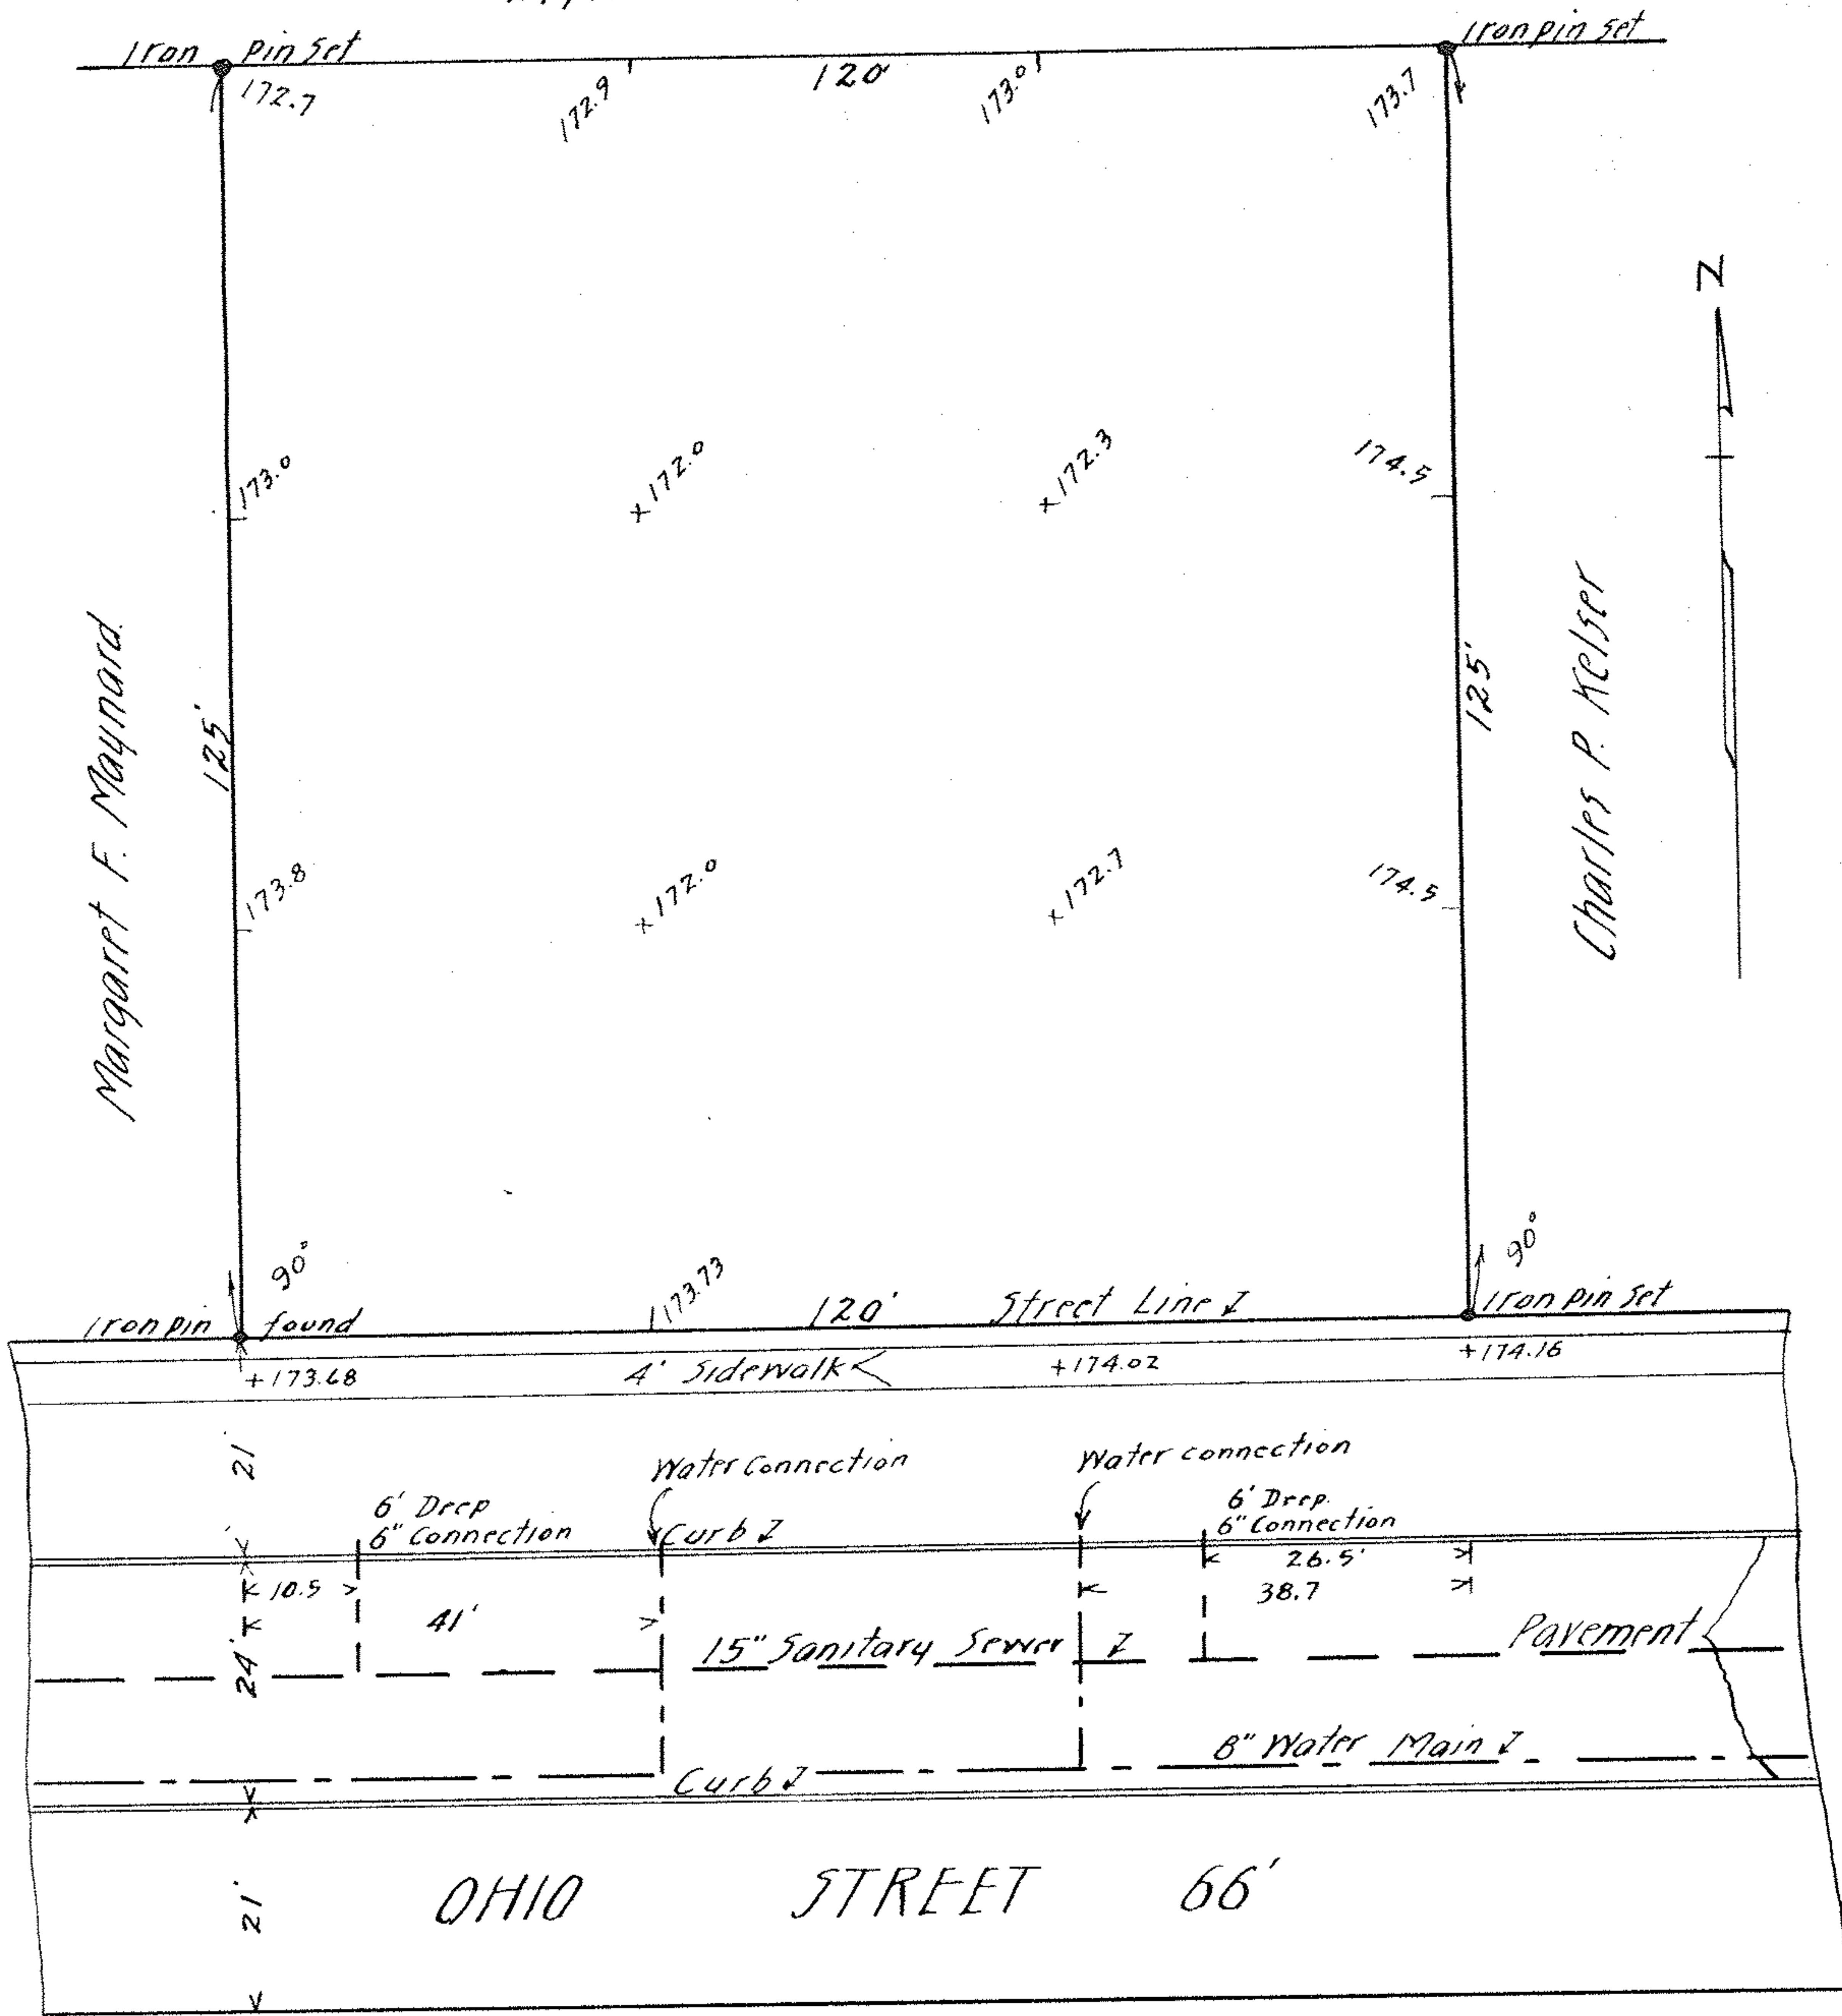

Survey for
 GLADYS P. CUSTAR
 D-Vol. 474 Pg 548 Oct. 19, 1949.
 OL 157 East of Black River
 Elyria Township Elyria City
 Lorain County Ohio.
 Scale 1" = 20' April 21, 1950
 J. W. Warden, Registered Surveyor.

P.P.N. 06-25-157-000

MAP PG. 06-102