


4

157105

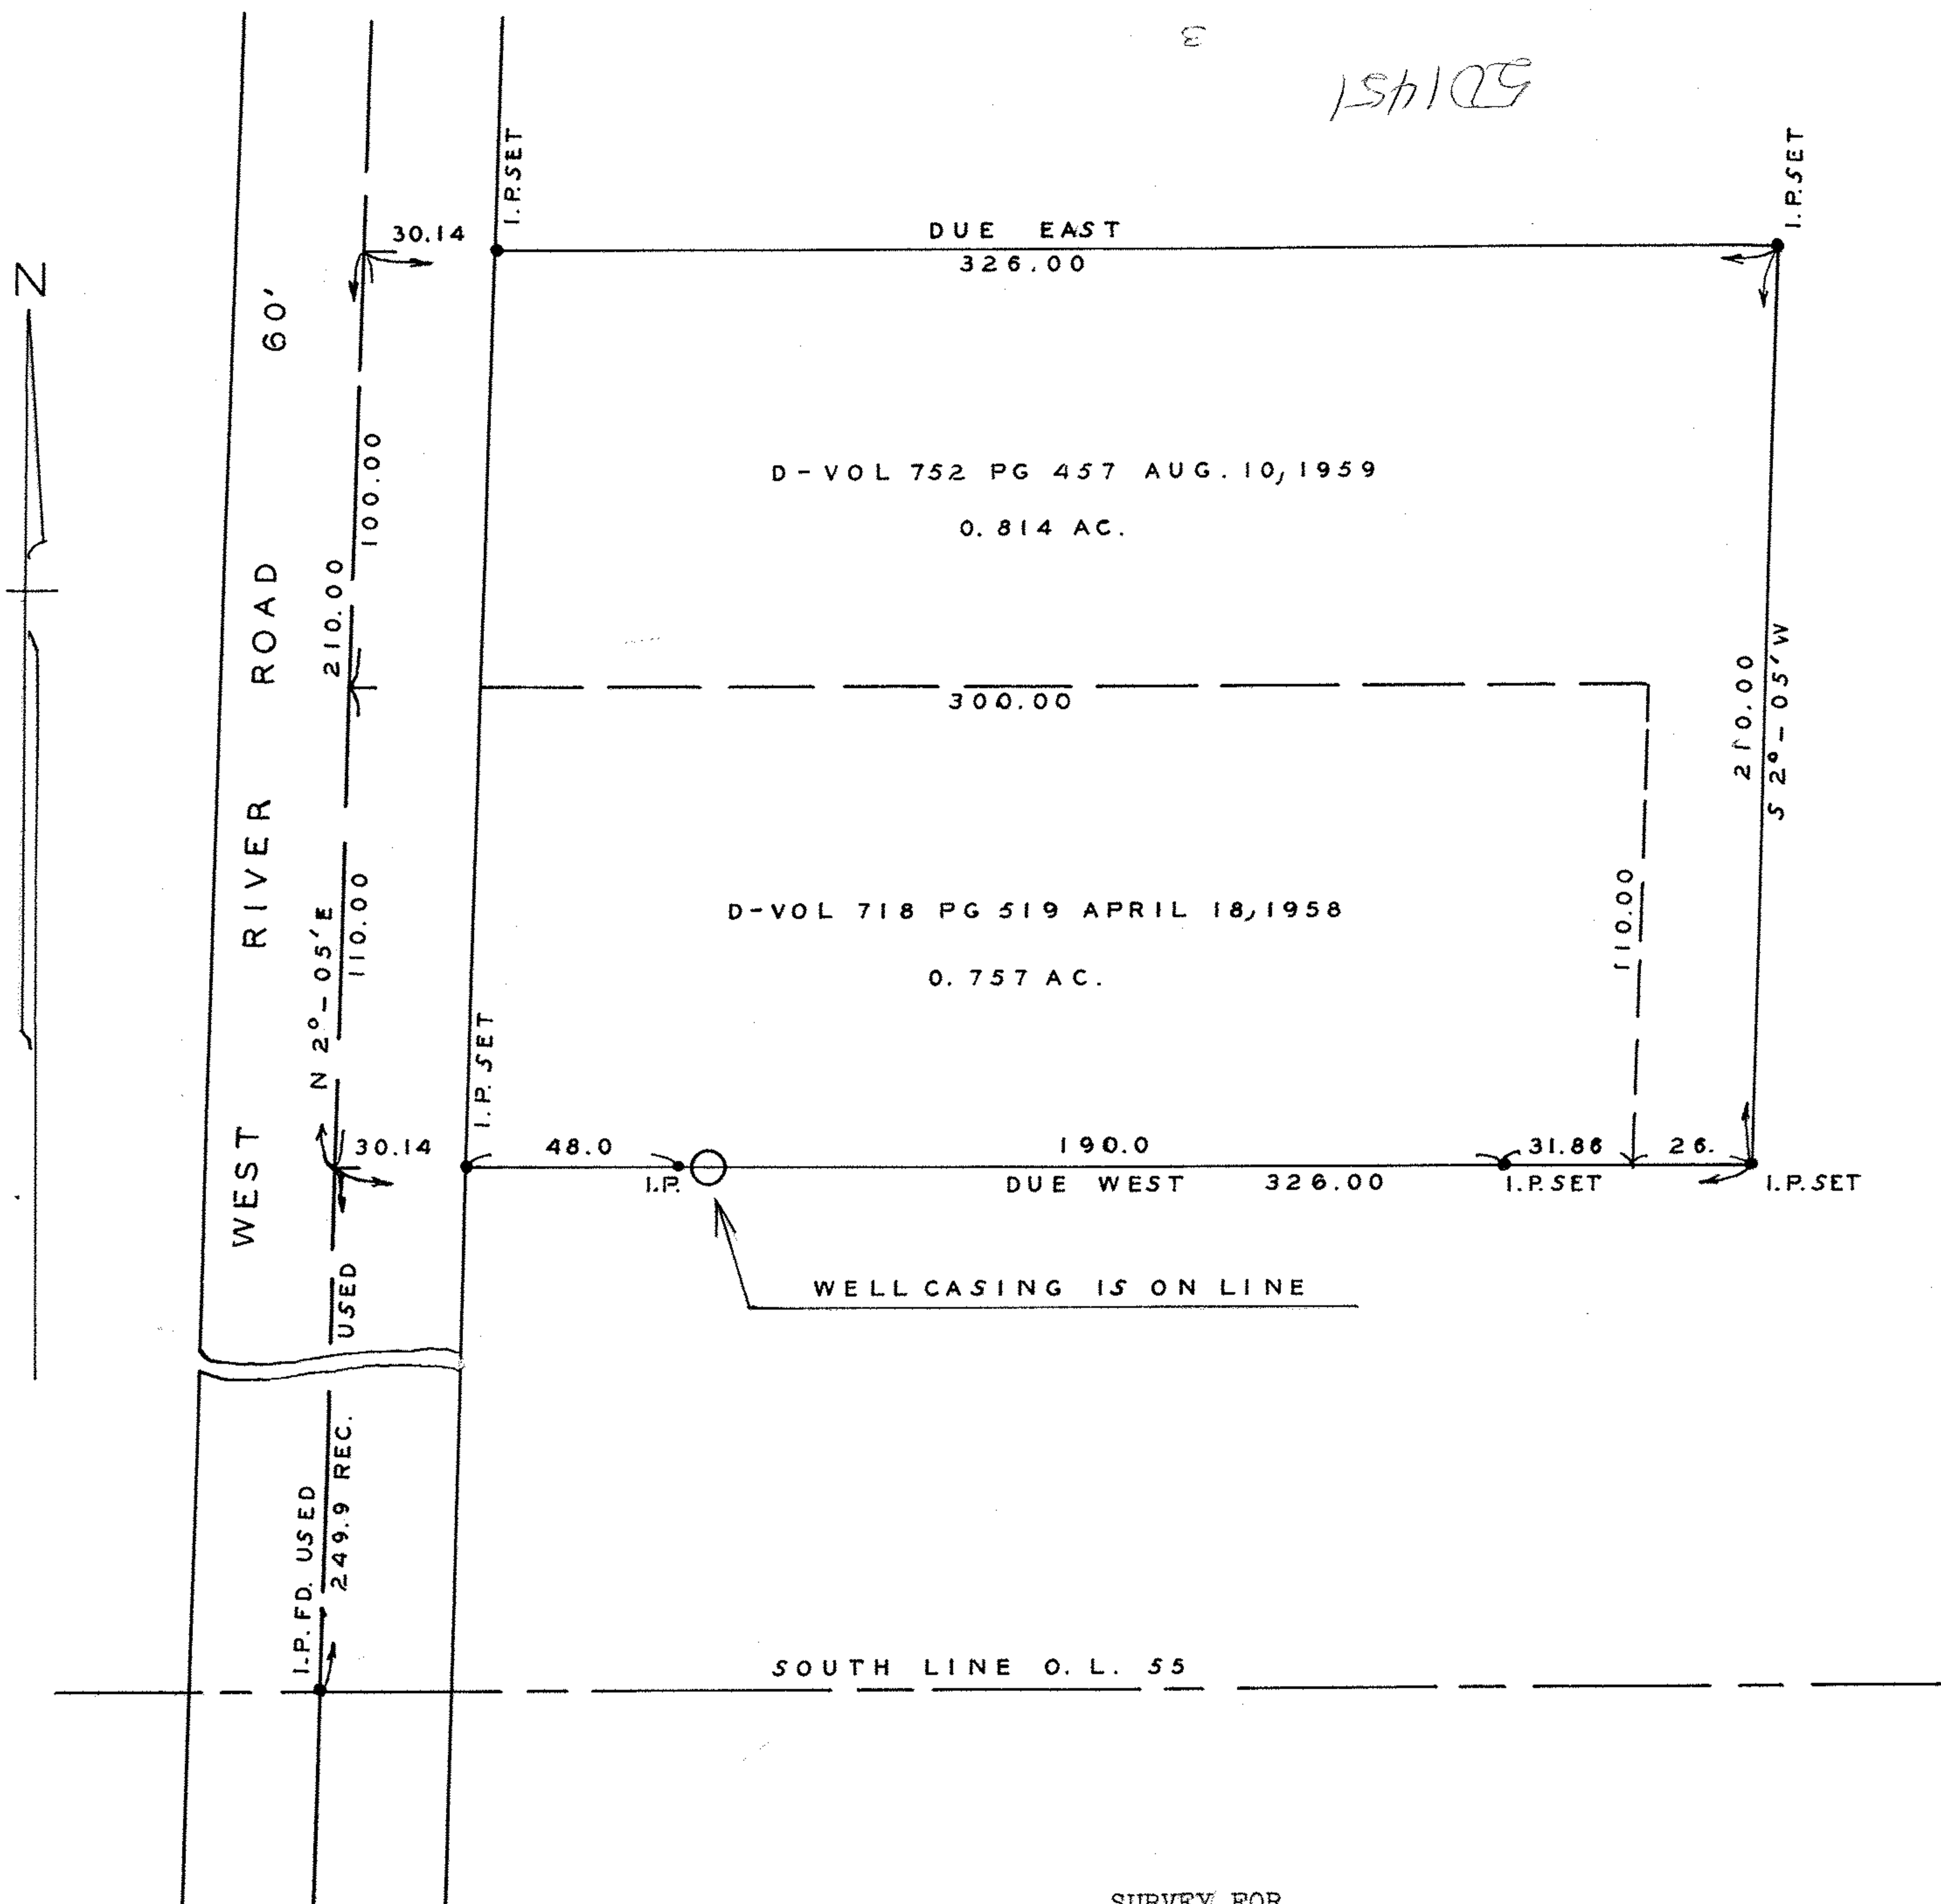

SURVEY FOR
 FRANCIS A. AND M. E. KOCAK
 O. L. 55 COLUMBIA TOWNSHIP
 LORAIN COUNTY, OHIO
 SCALE 1" = 40' SEPT 14, 1964
 J. W. WARDEN AND ASSOCIATES
 REG SURVEYORS

P.P.N.: 12-00-055-102-009
 -010

MAP PG: 12-00-055-B