

MAP OF SURVEY MADE FOR

R S Silsbee, Architect

Part of Lot 128 Block 63 Orig Vill, Plat
Elyria City

Lorain County, Ohio


Distances are given in feet and decimal parts

Scale, 1 in. 20 Feet
Elyria, O.,
Order No.,
F. B. 4 Pg. 19-21

Warden & Laundon, C. E.
403 ELYRIA BLOCK
9-25-24

Broad St 99'

MAP FOR 06-120

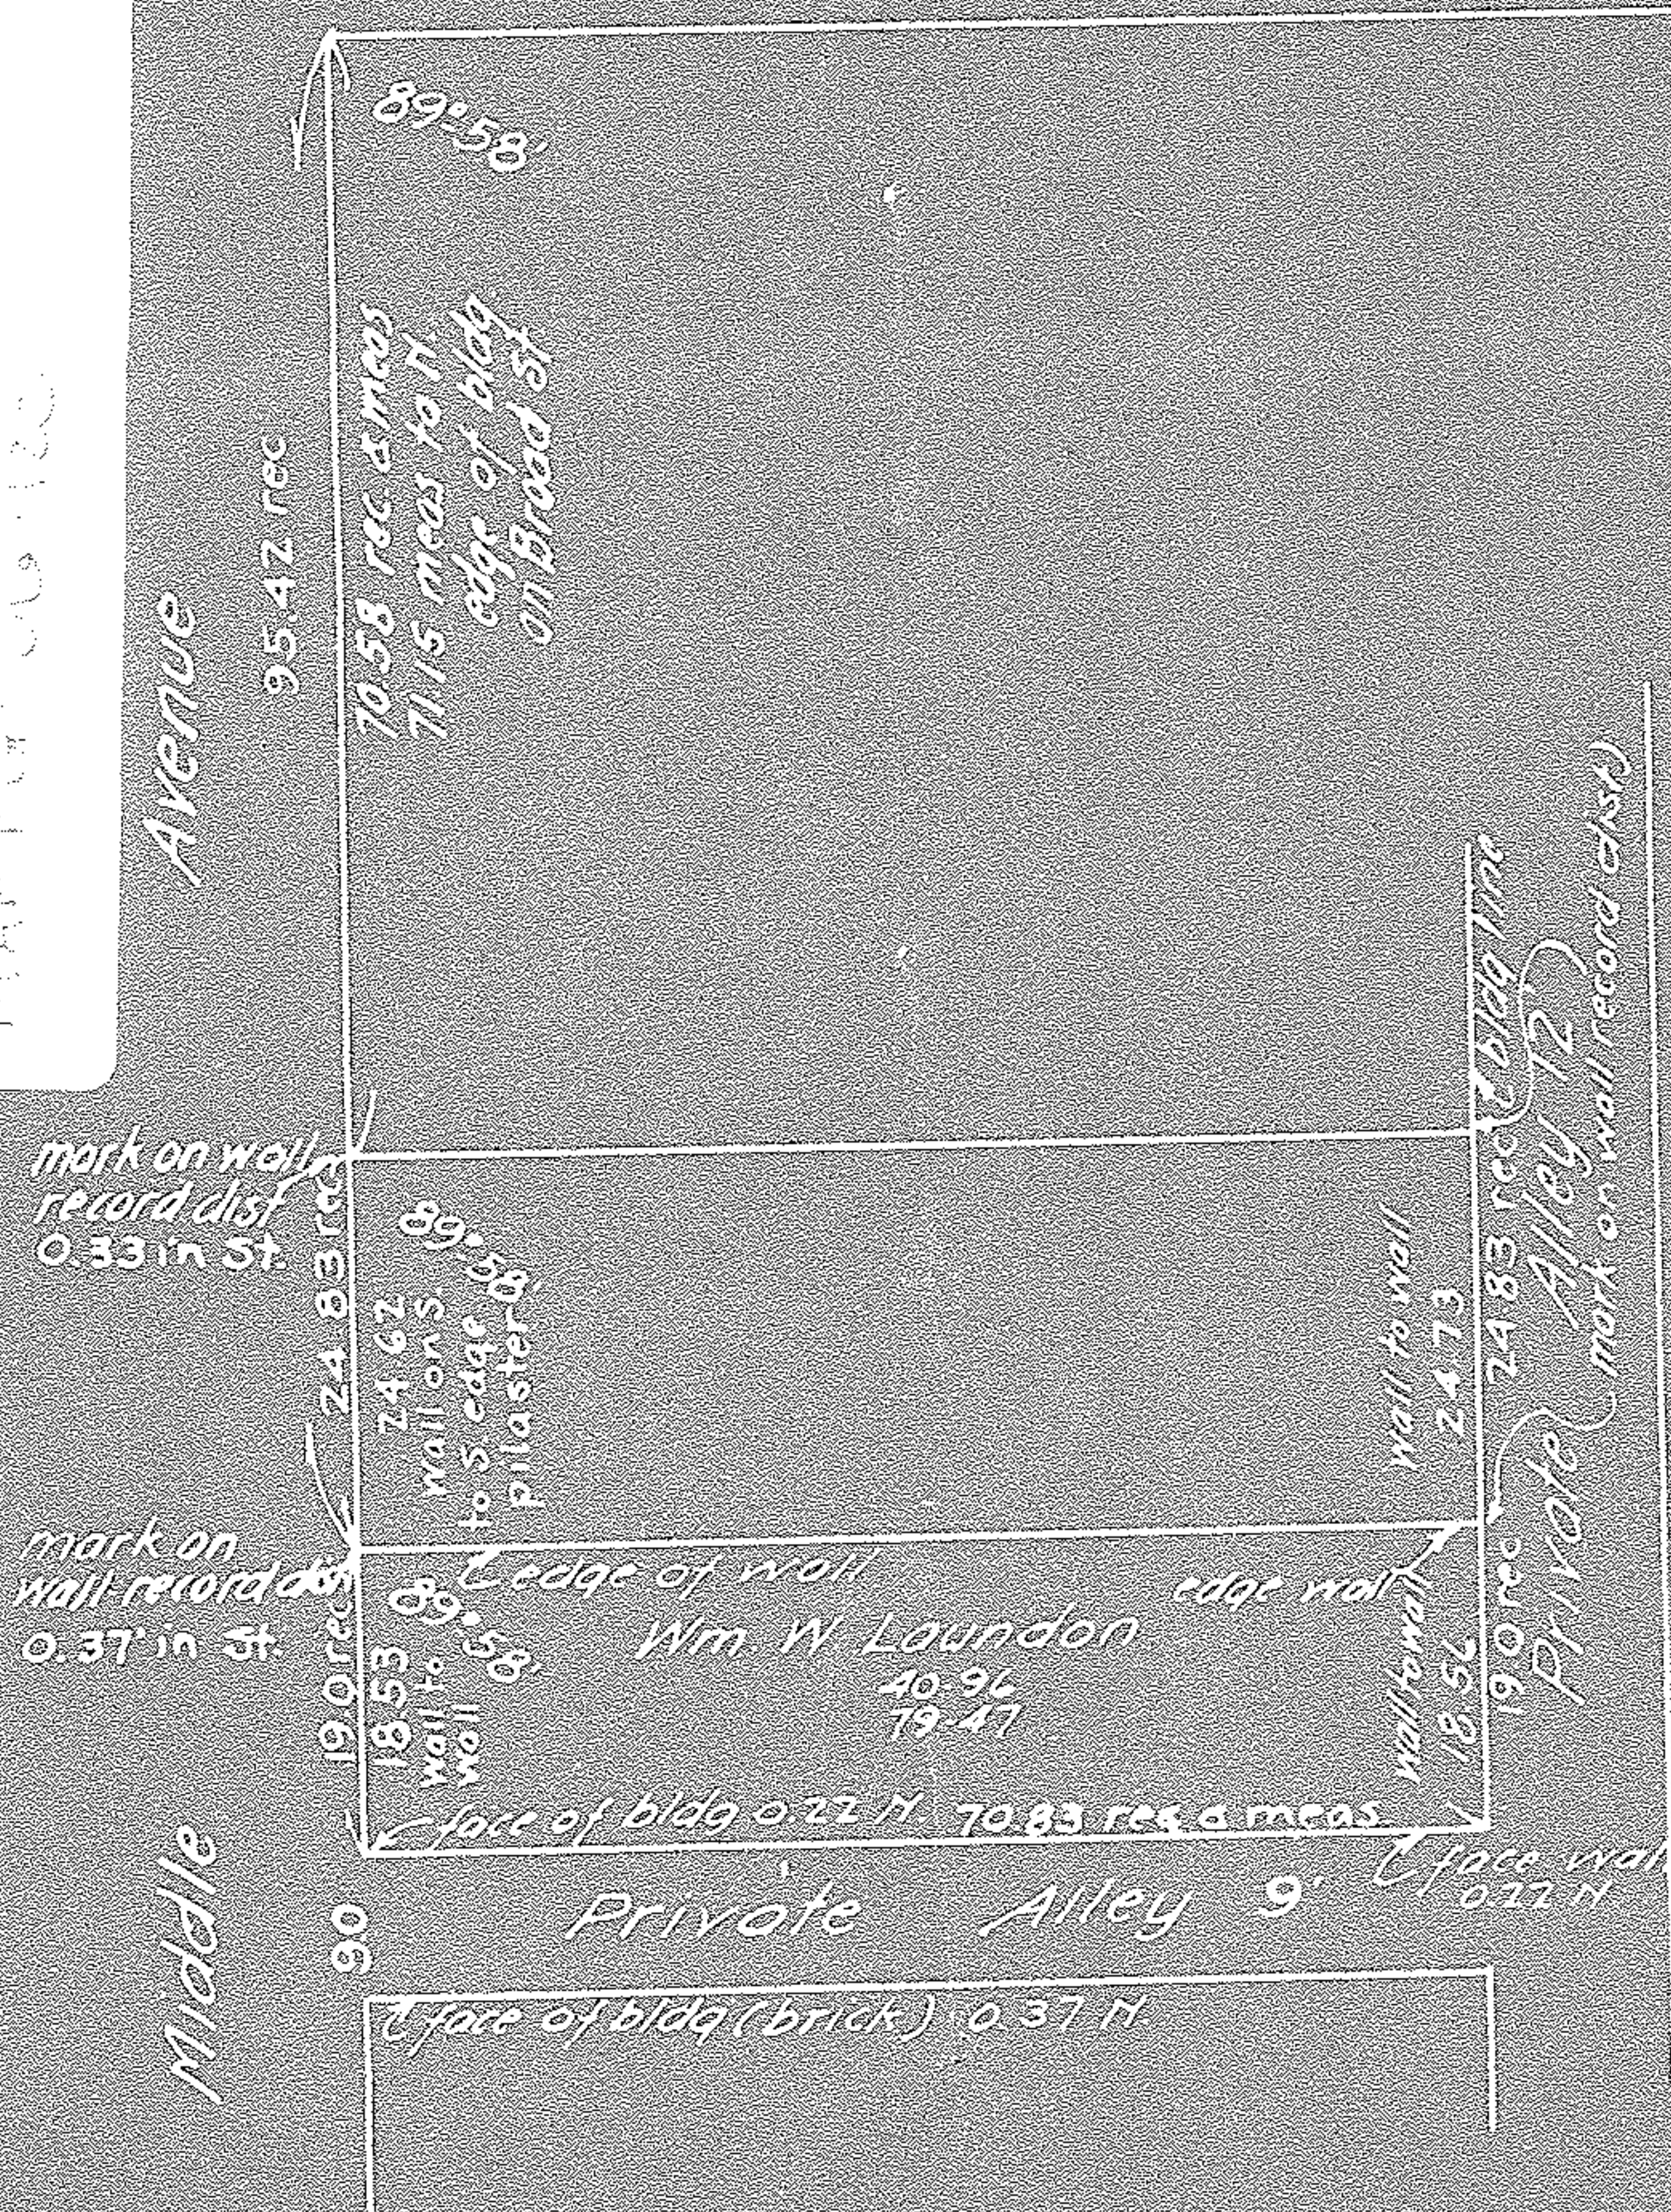

Occupation
Note - Using line of bldg on North side of 9' Alley as occupied and measuring North 19.0 (record dist) puts line 0.47' N of South edge of wall, and from this point North 24.83 (record dist) puts line 0.68 North of South edge of wall, or E of wall.
Back of bldg - Using line of bldg on N side of 9' Alley & measuring North 19.0 (record dist) puts line 0.44' N of S edge of wall, and from this point North 24.83 (rec dist) puts line 0.54' N of S edge wall (should be 0.67 for occupation)