


Survey of
DUSENDONG FARM.
Lots 44-45. Ridgerville Twp.,
Lorain Co., Ohio.
Scale 1 inch = 200 feet. July 30, 1920.
Wardens & Saunders
Engineers.

3-73

PPN 07-00-044-102-019
 - 020
 - 021

07-00-045-101-002
 001

MAP PG 07-00-045-A, 044-C

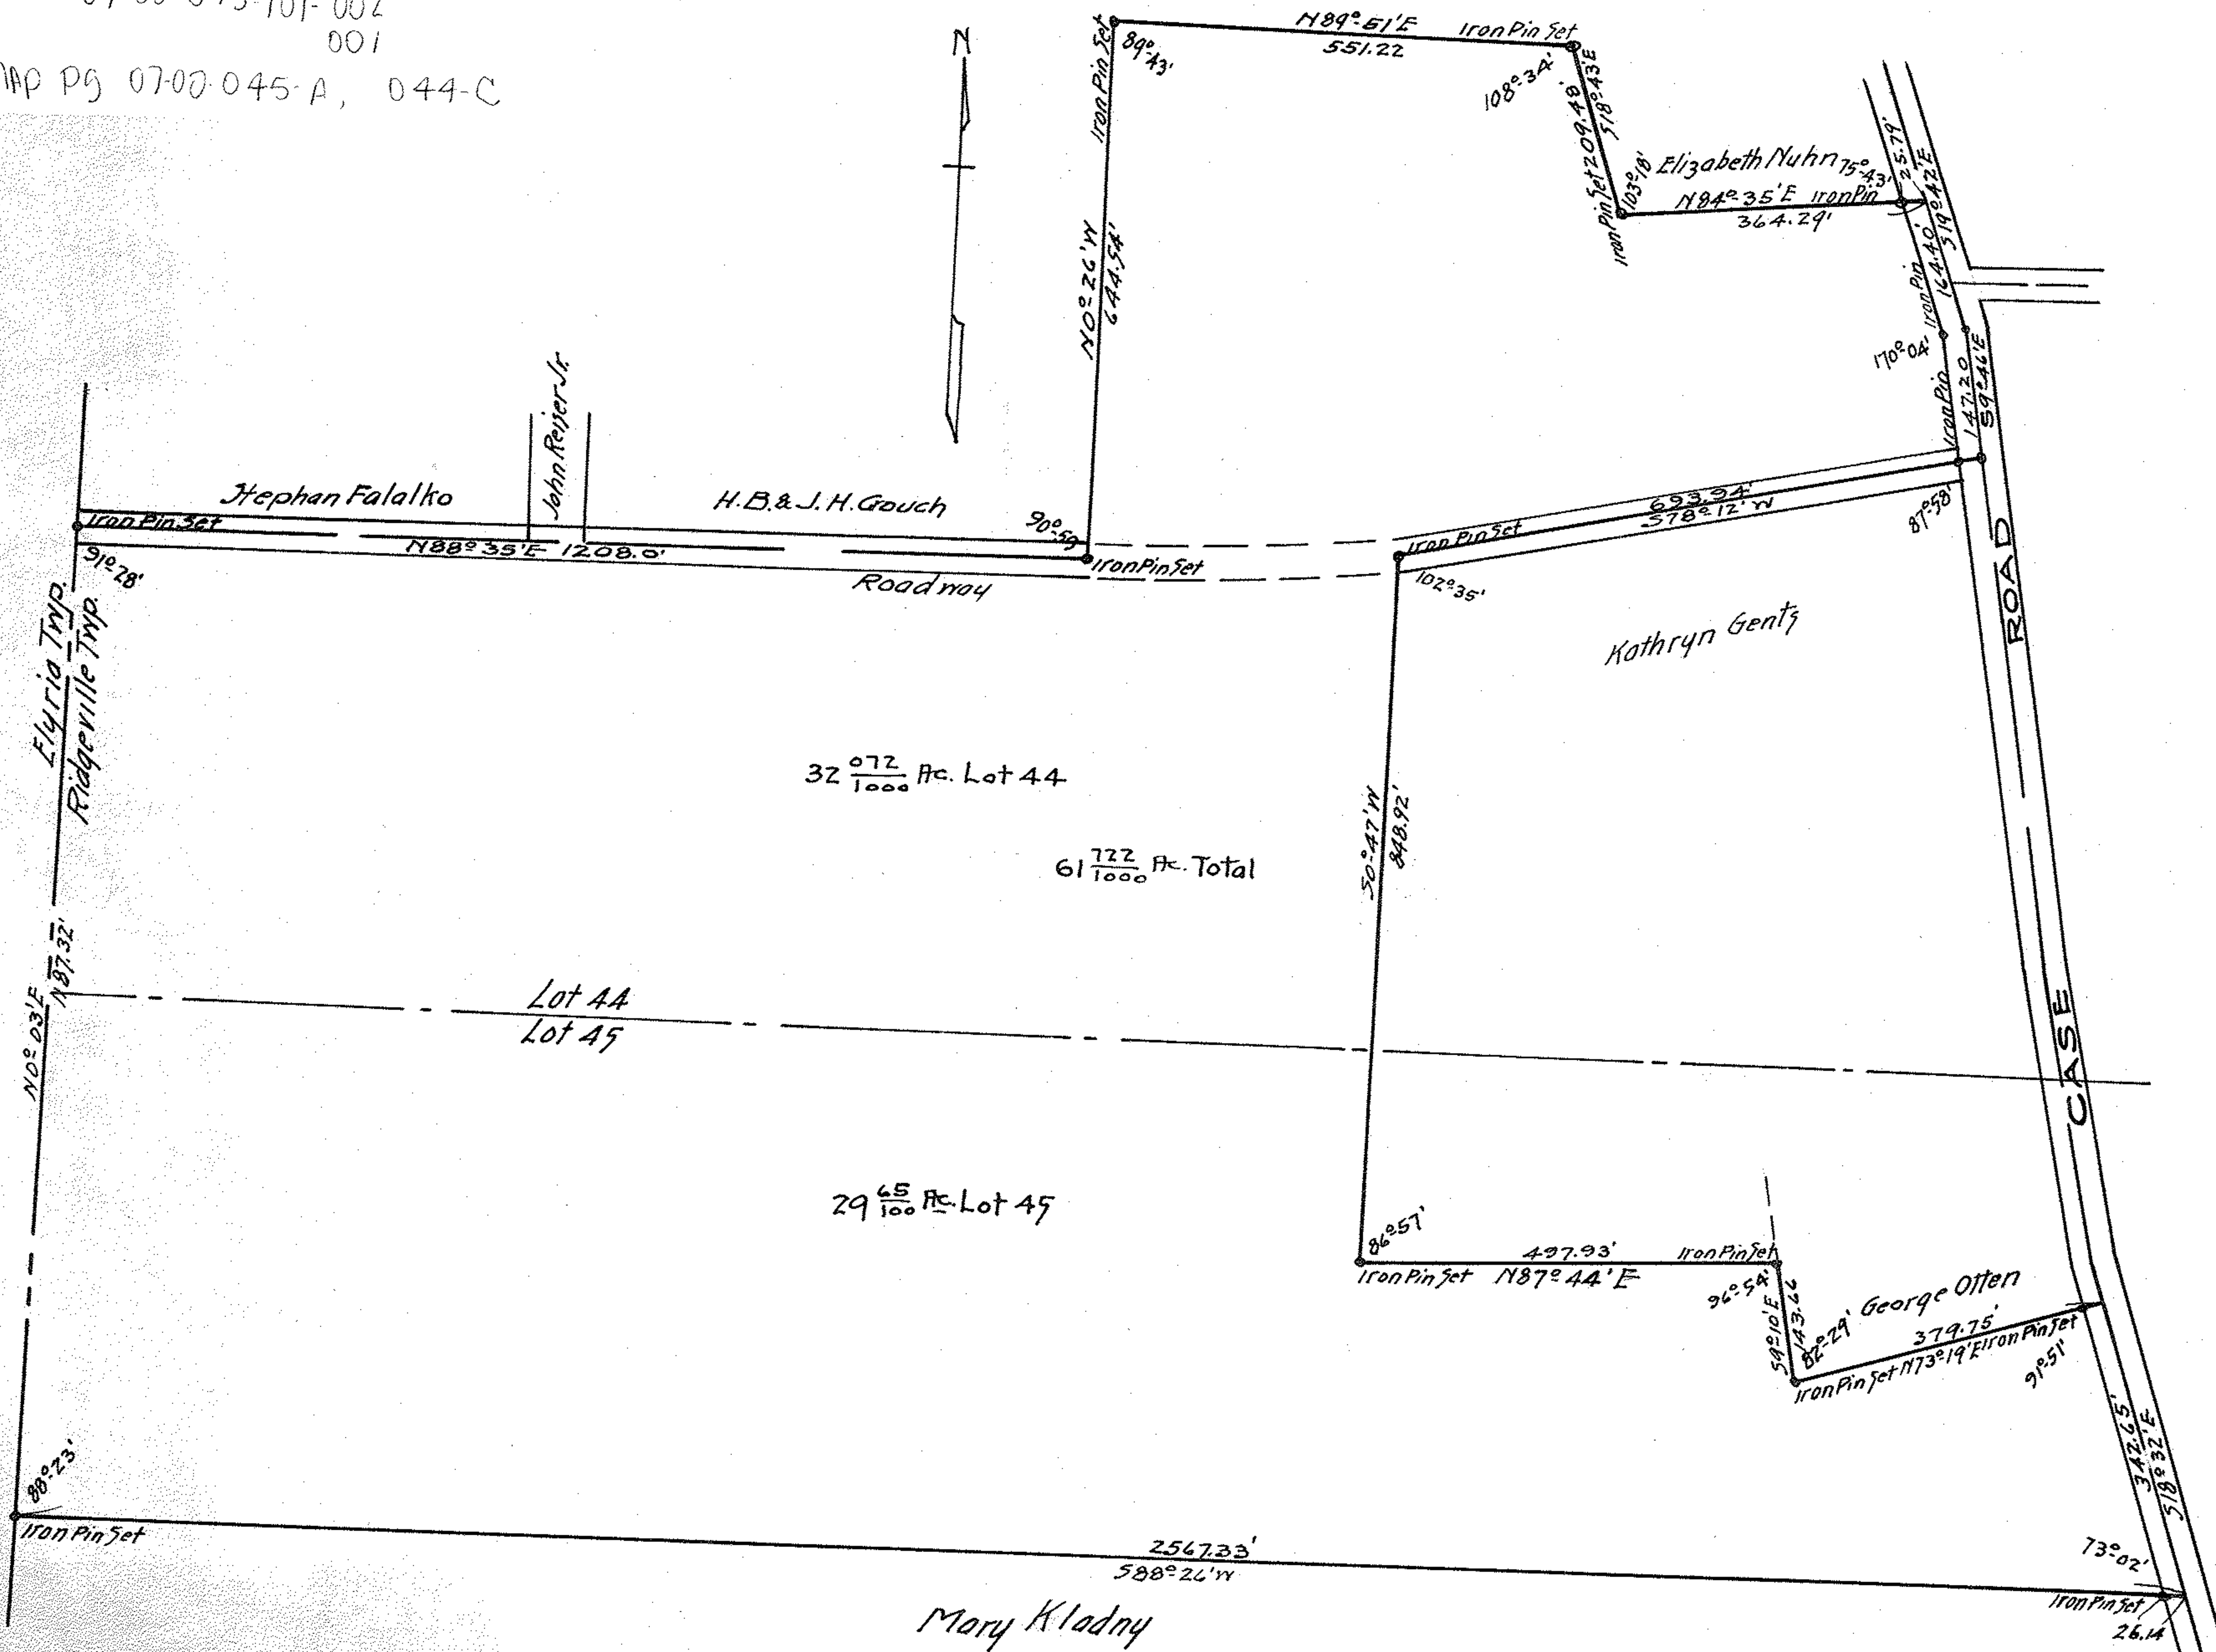

300043A