


Survey for G.A. Resek & B.F. Koch
 Part of Original Lot 68, East of Black River
 Elyria City, Lorain Co. Ohio
 March 5, 1918. Scale 1 in = 50 ft
 Warden & Laundon
 Surveyors

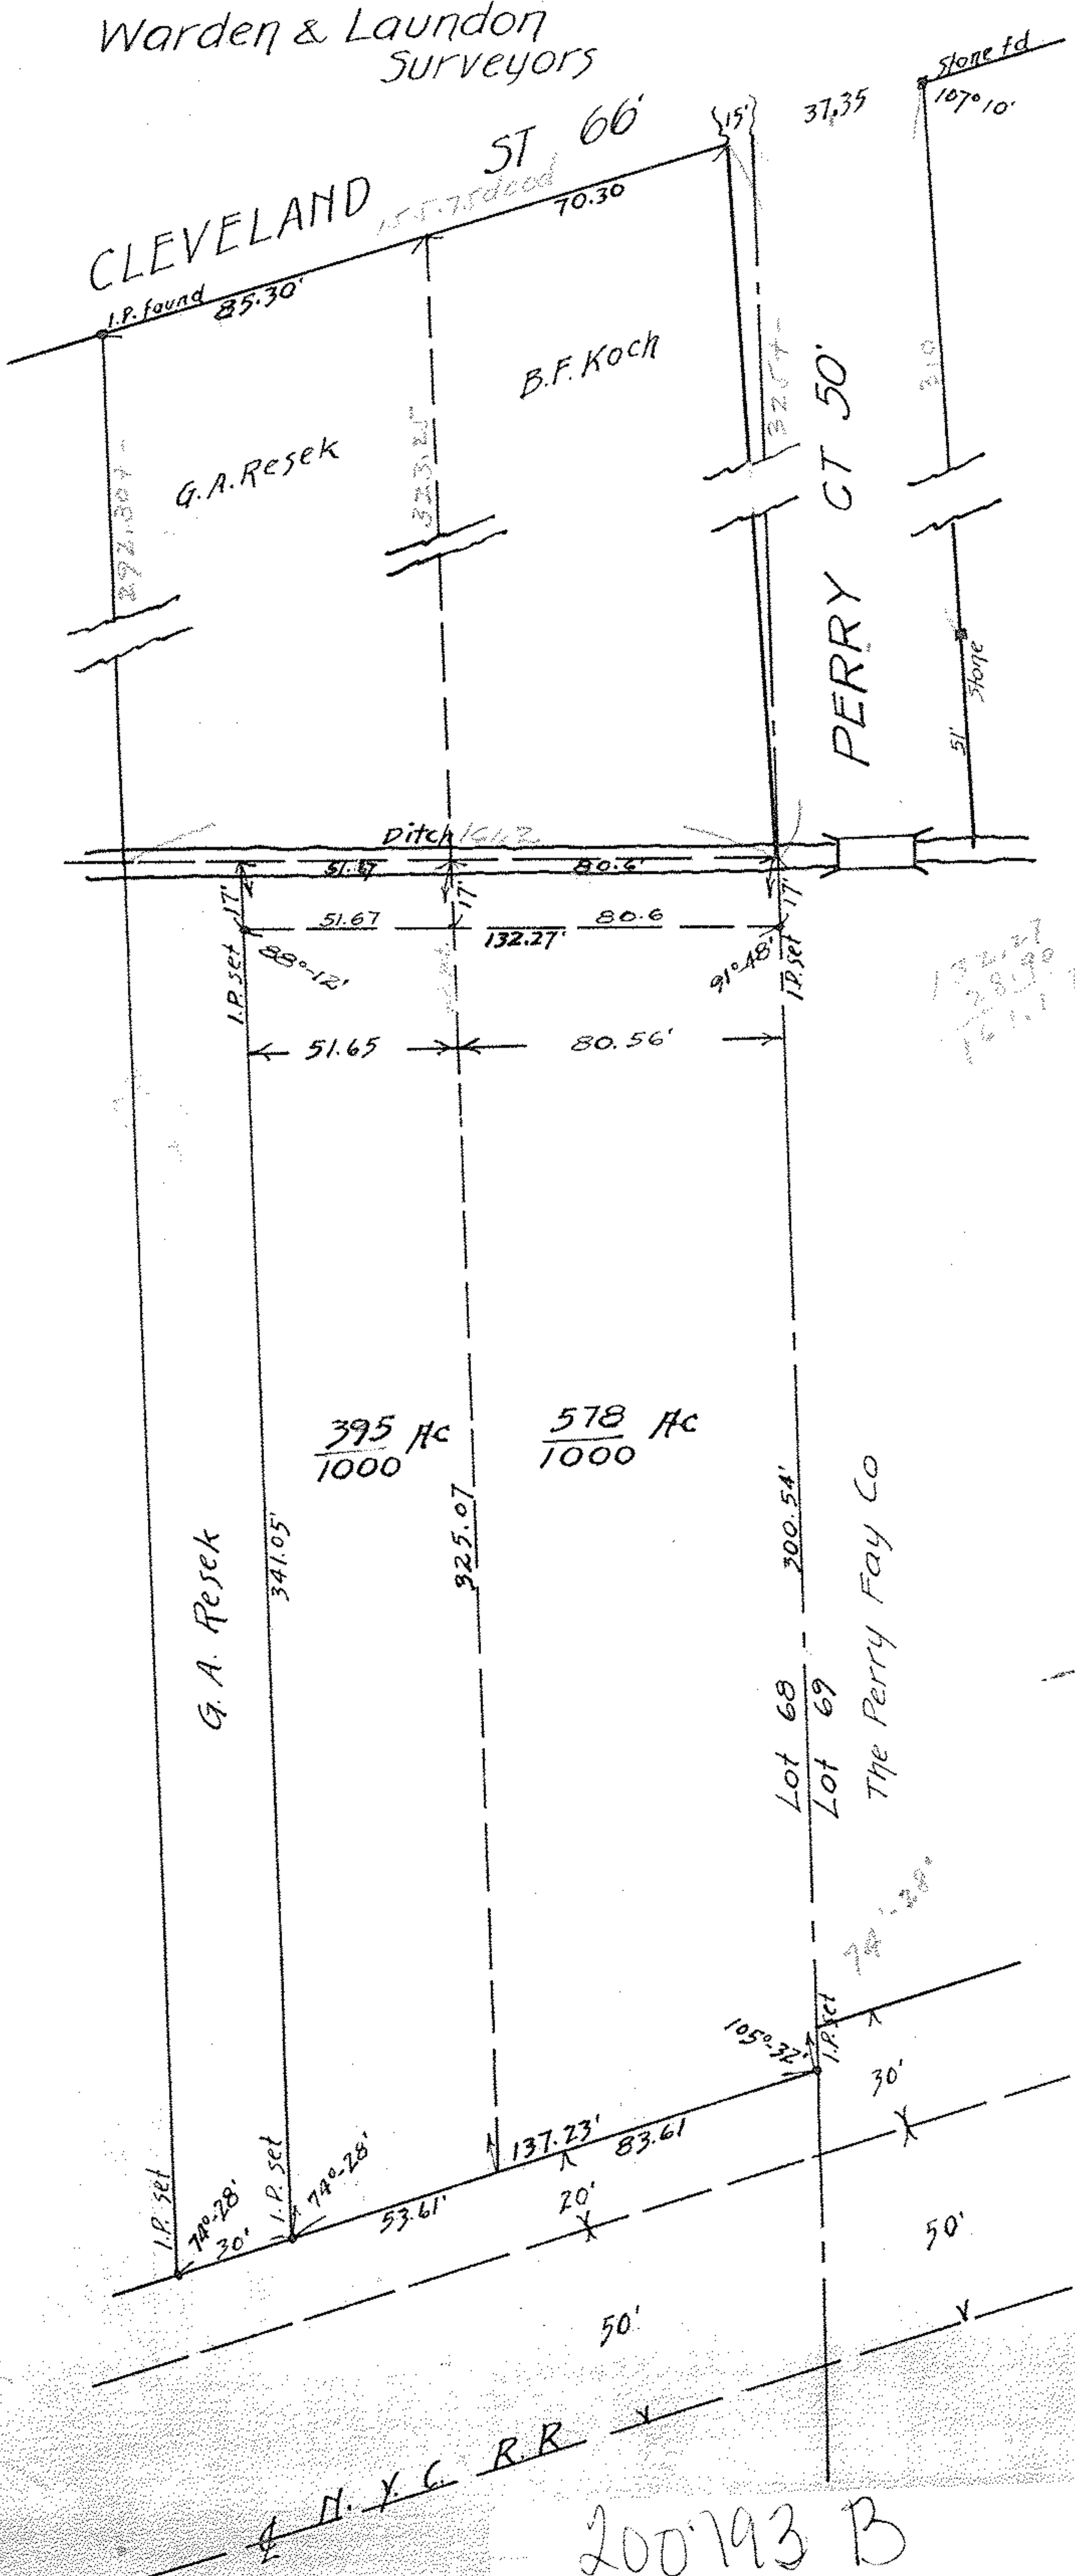

200793 B