


200085 A

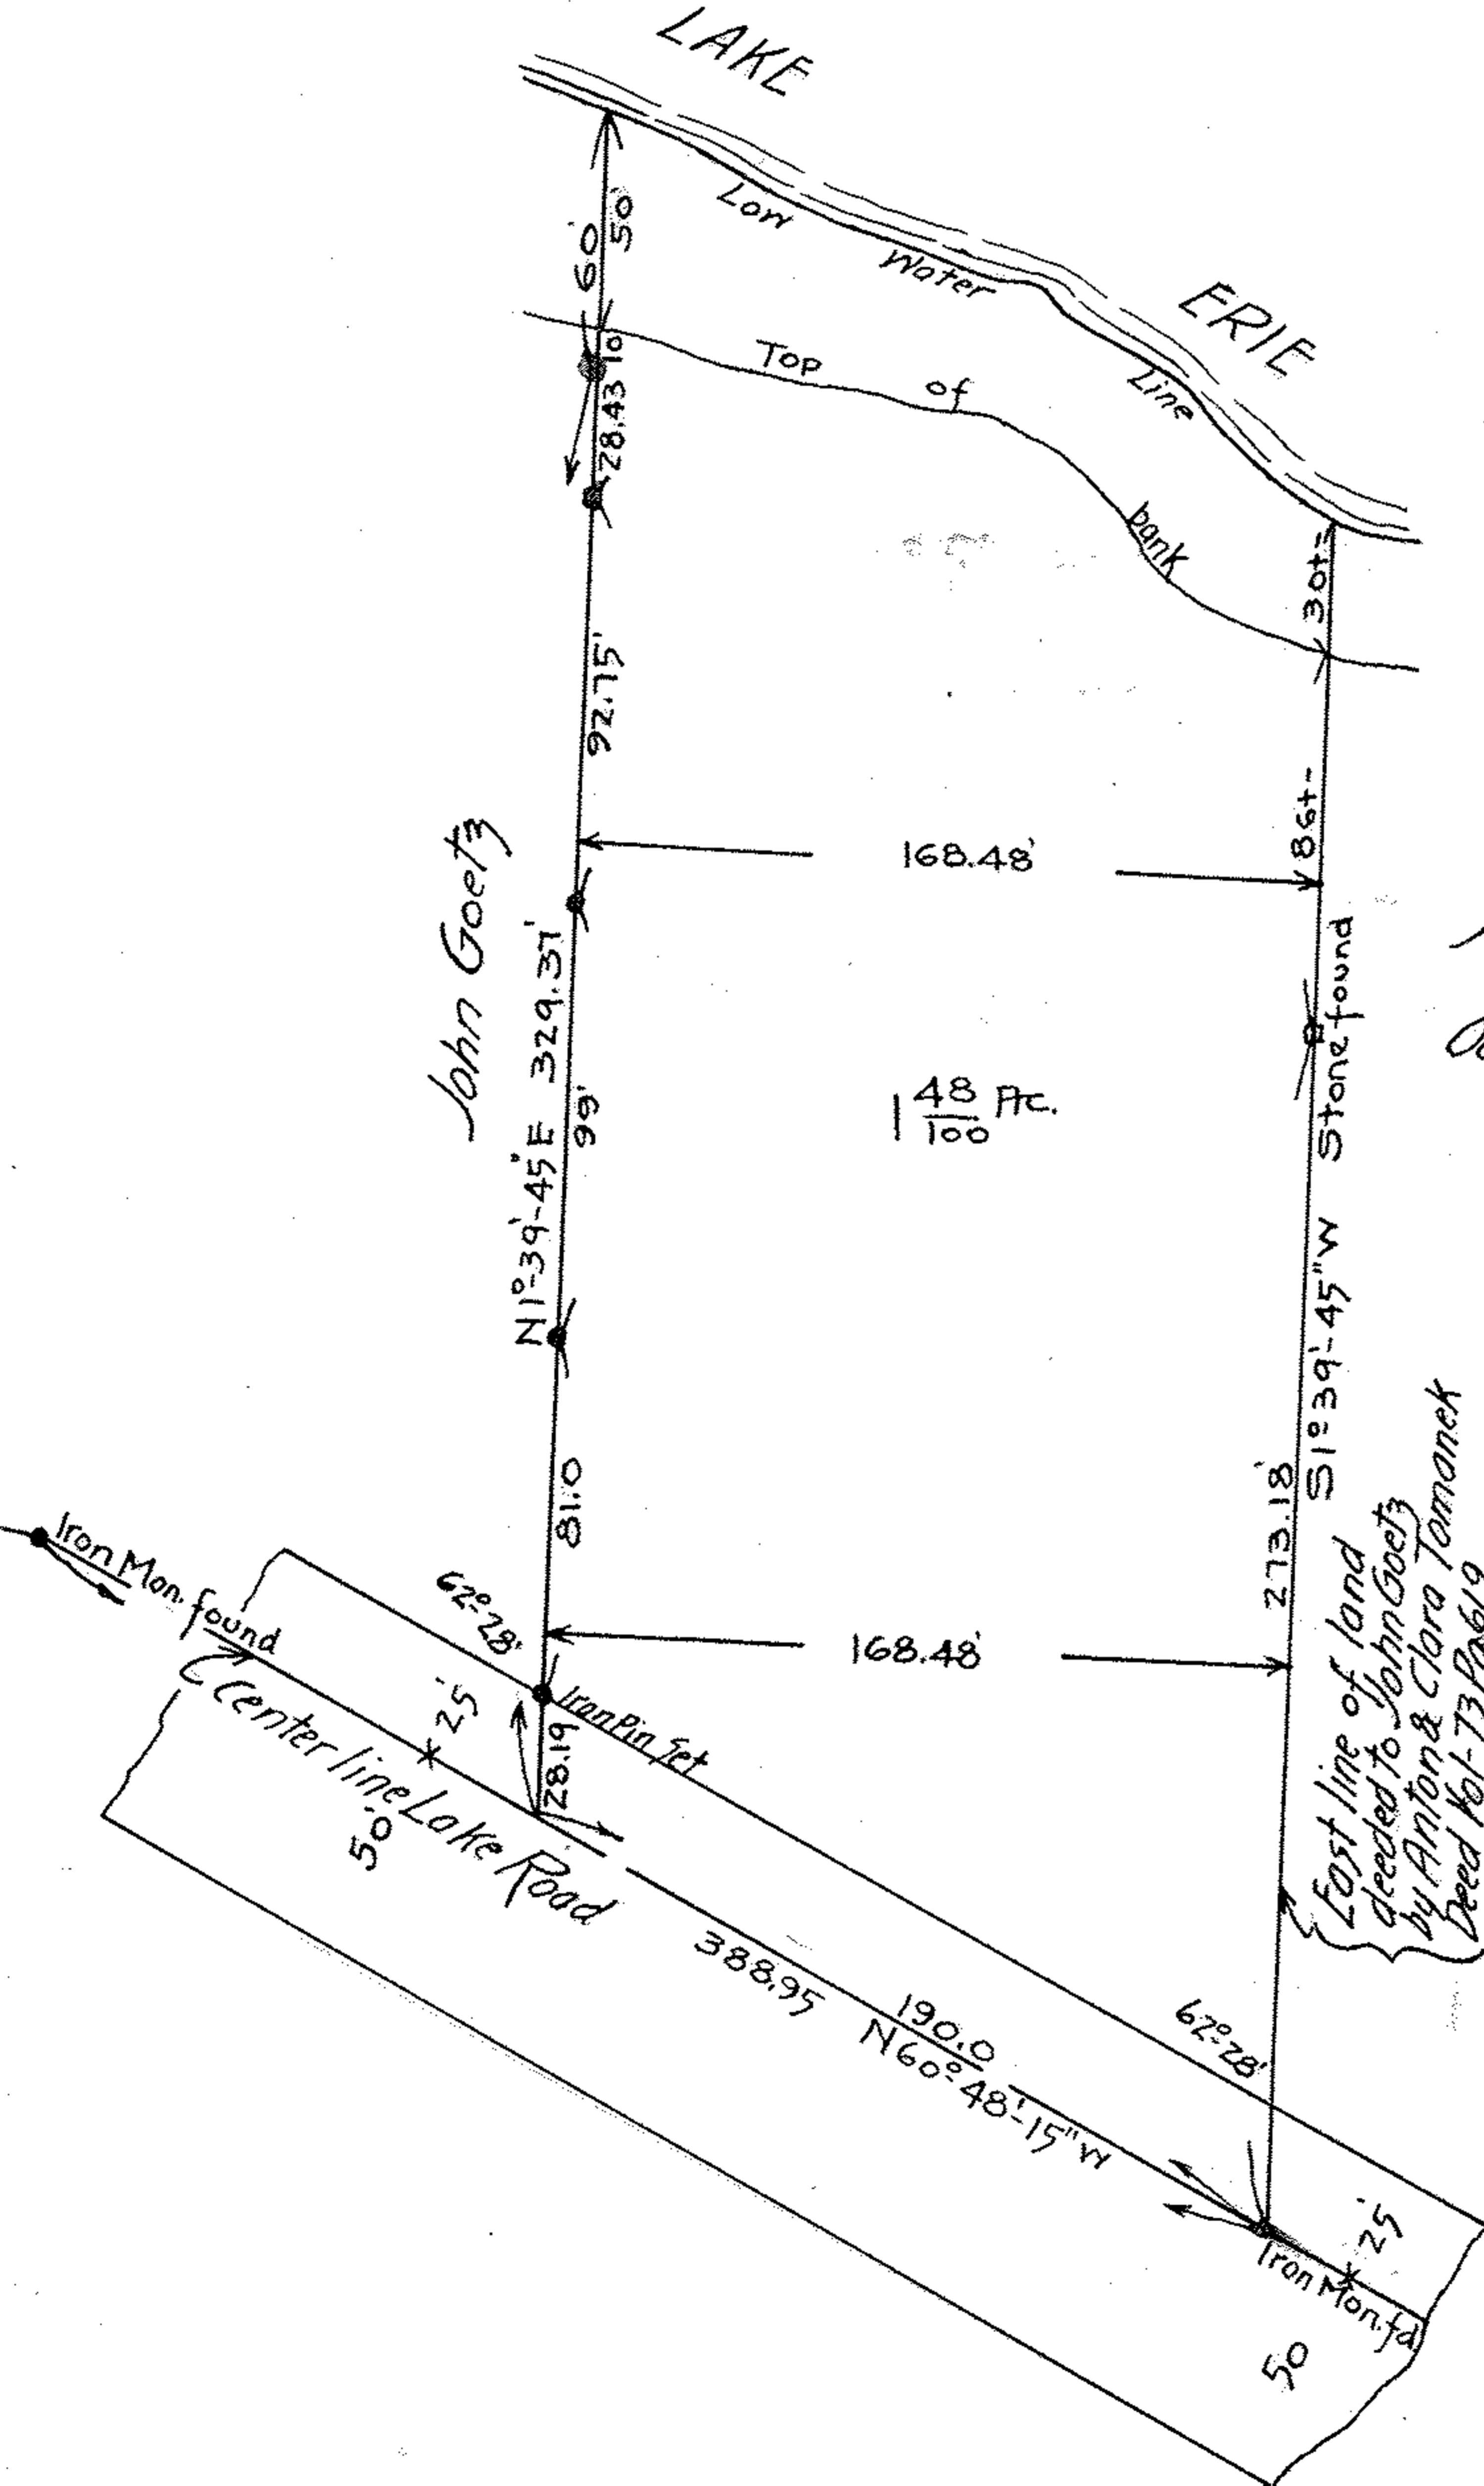

Survey for  
C.F. Schuster.  
Section 30. Avon Lake Village,  
Lorain Co., Ohio.  
Oct. 4, 1923. Scale 1 inch = 60 ft.  
Wardens Landow.  
Civil Engineers.

MAP P9 04-00-030-B

PPN 04-00-030-103-772