


10-0644 H

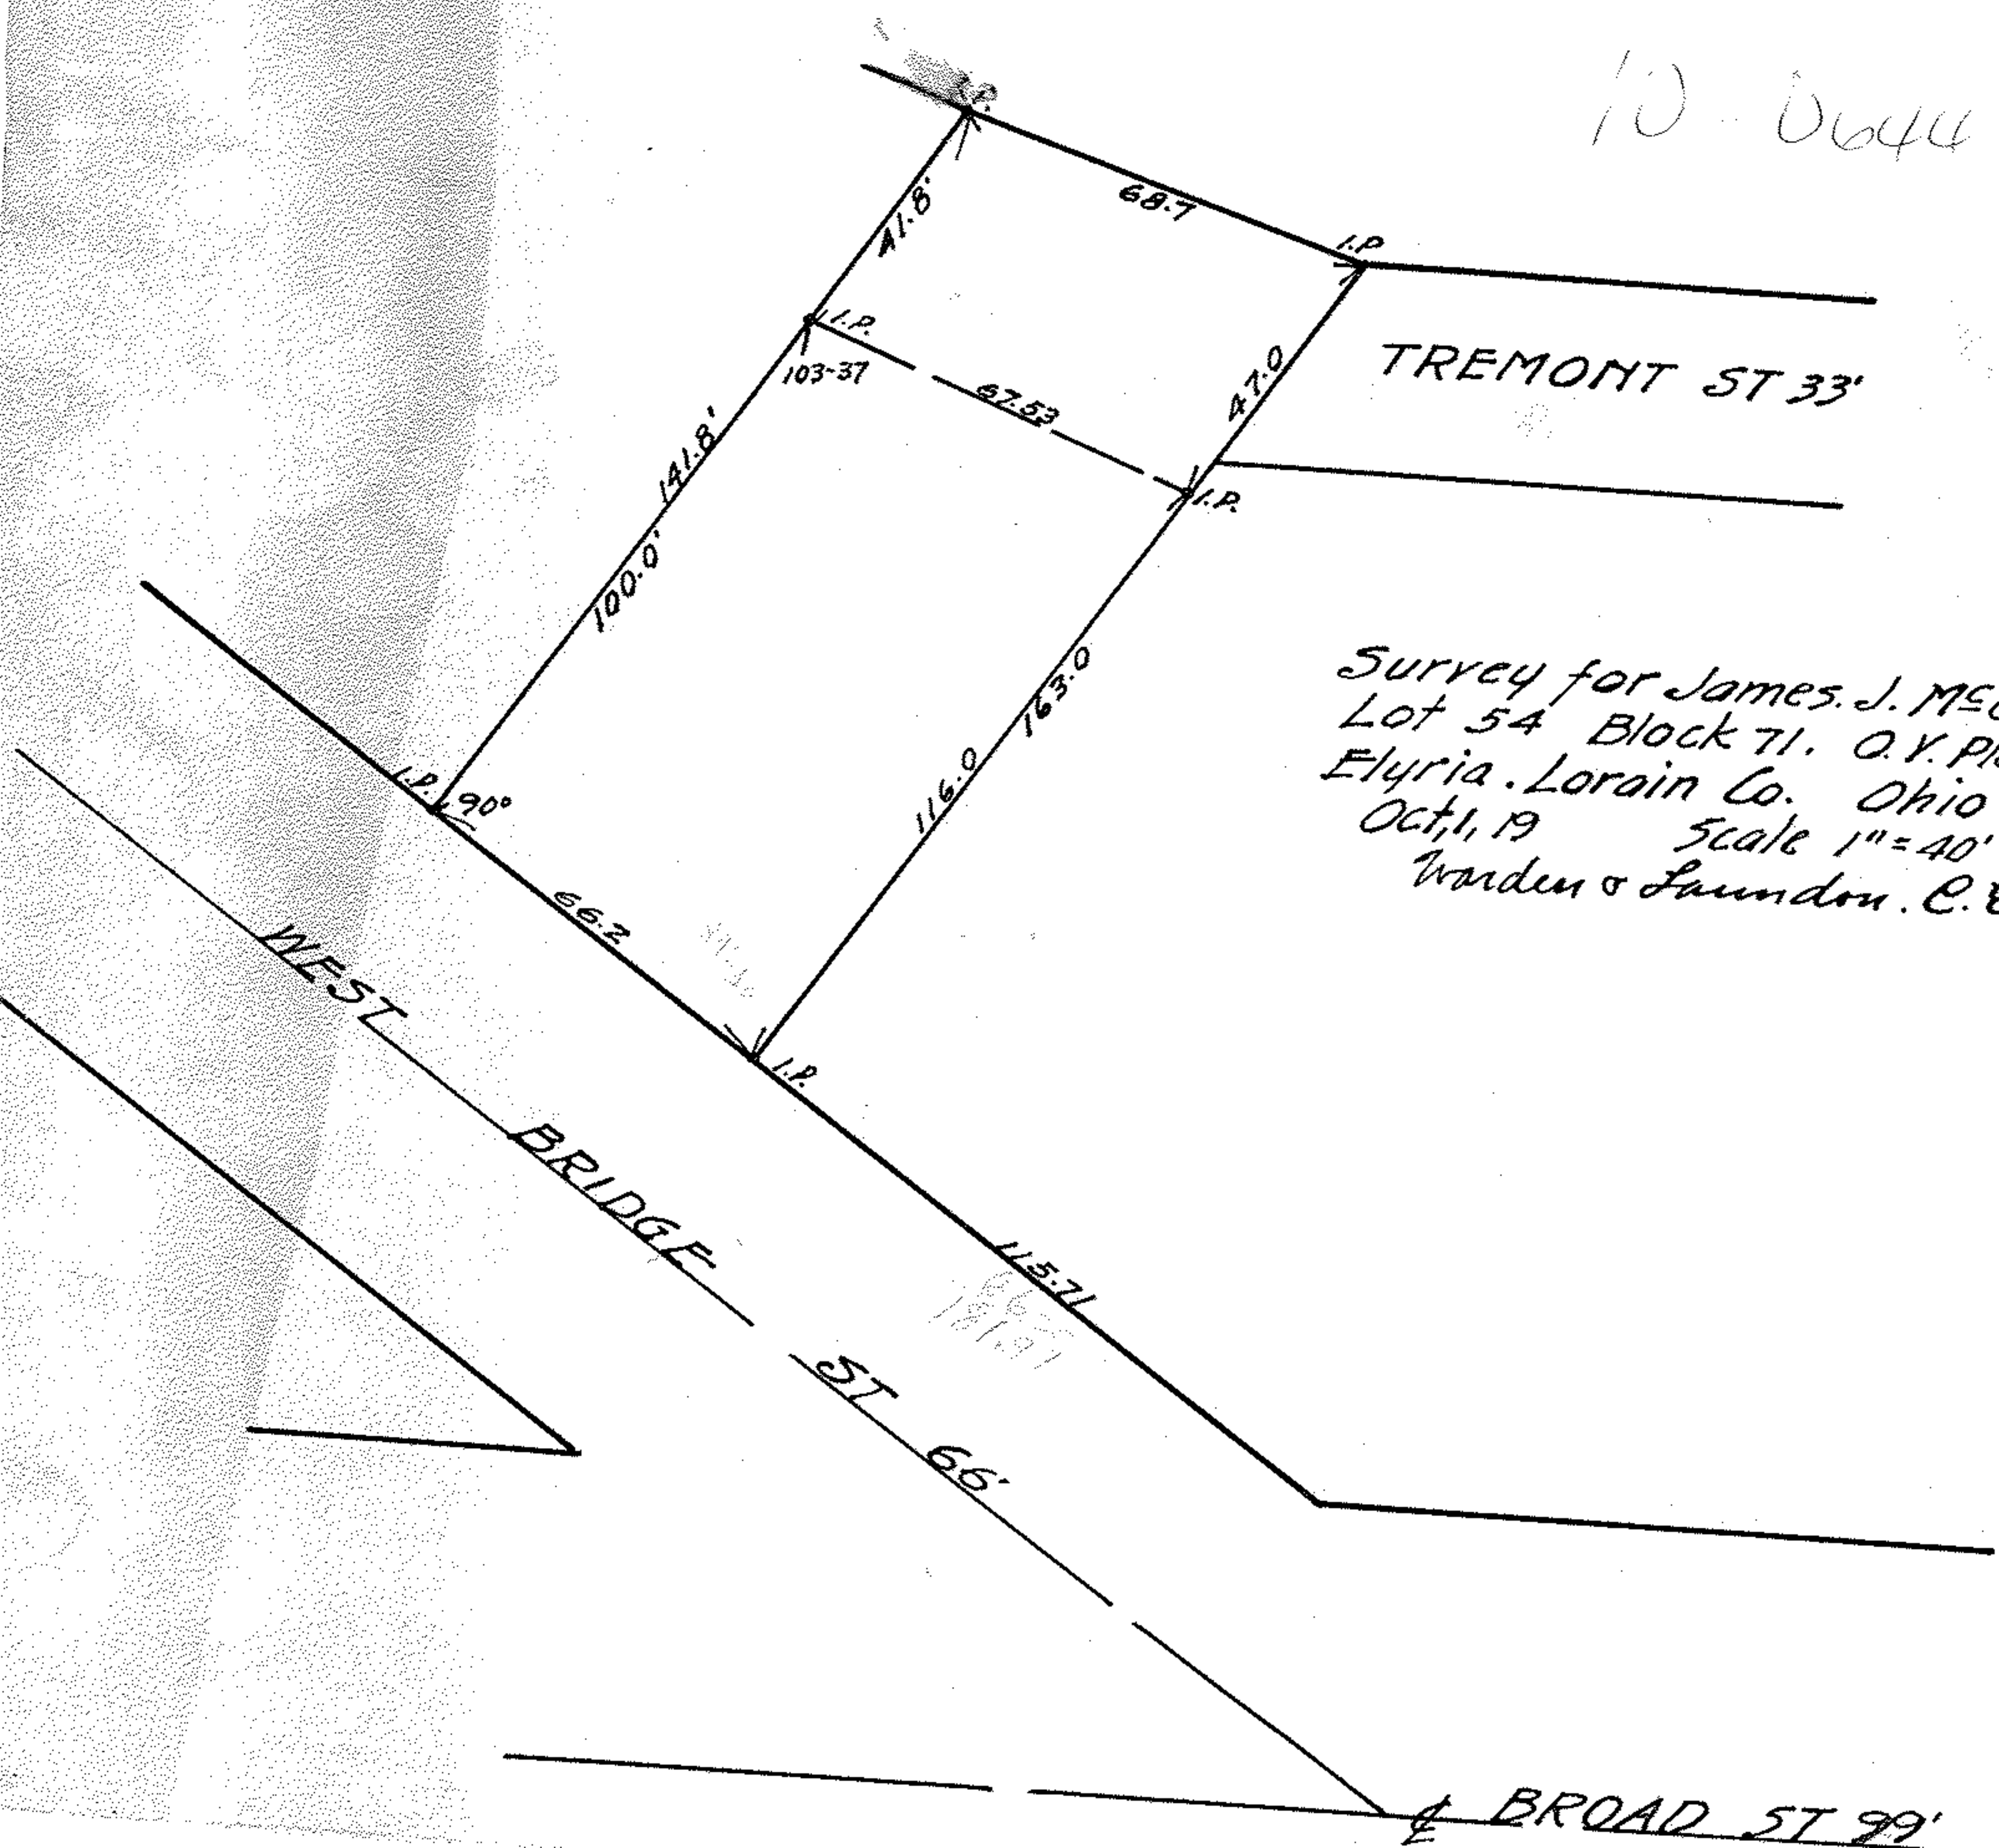

Survey for James J. McGuire
Lot 54 Block 71. O.V. Plot.
Elyria. Lorain Co. Ohio
Oct 1, 19 Scale 1" = 40'
Warden & Saunders. C. Es.

115.71
66.2
103.37

BROAD ST 99'