

POWDERMAKER ROAD

60'

N 63° - 43' E
666.70

S 80° - 30' W
1026.30

S 88° - 45' W

1468.10

210' ○ EXISTING GAS WELL

10.0 AC.

N 2° - 45' E
631.15

699.58
S 2° - 45' W

660.00
S 89° - 36' W

852.59

SURVEY FOR
AVON OIL COMPANY
SEC 28 AVON TWP. AVON CITY
LORAIN COUNTY, OHIO
SCALE 1" = 100' OCT 5, 1965
D. D. ANDRUS AND ASSOCIATES
REG SURVEYORS


Berea Quadrangle

41° - 27' - 52" 81° - 58' - 52"

SEC 28

2360.00

SEC 28

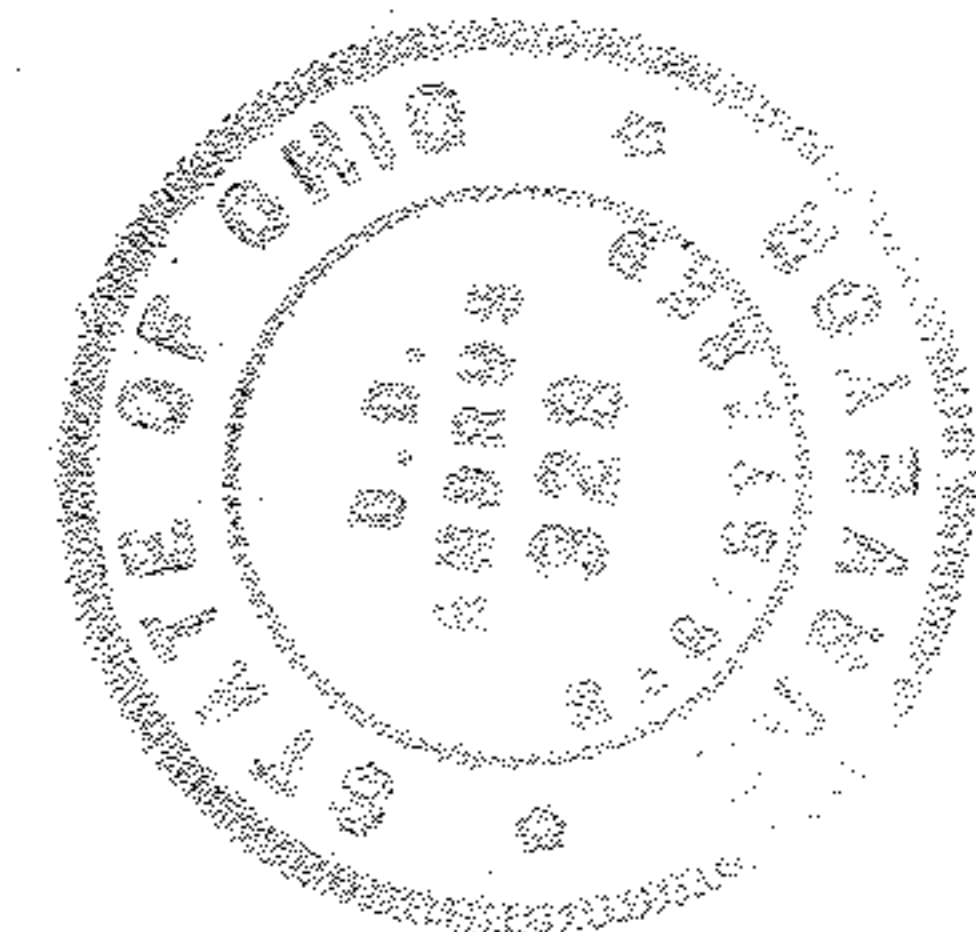

I, the undersigned, hereby certify that the measurements and information contained herein are true and correct as required by the General Code of Ohio.

I hereby certify that there are no producing oil wells within 460 feet and no roads or dwellings within 150 feet of this location

D. D. Andrus

D. D. Andrus reg. surveyor No. 328

State of Ohio: Before me, a Notary Public, in and for said State, personally came D. D. Andrus, who did acknowledge the signing of the above.

Joseph Q. Petro
Joseph Q. Petro
Notary public

My commission expires *not*.

LORAIN COUNTY
CUYAHOGA COUNTY

SEC 28 AVON TWP

PPN 04-00-028-101-???

MAP P9 04-00-028-B

- 201482 E