


5-1482

I THE UNDER SIGNED HEREBY CERTIFY THAT THE MEASUREMENTS AND INFORMATION CONTAINED HEREIN ARE TRUE AND CORRECT AS REQUIRED BY THE GENERAL CODE OF OHIO. I D.D. ANDRUS HEREBY CERTIFY THAT THERE ARE NO PRODUCING WELLS WITHIN 460 FEET AND NO ROADS OR DWELLINGS WITHIN 150 FEET OF THIS LOCATION.
D.D. Andrus Reg. Surveyor No 328

STATE OF OHIO: BEFORE ME A NOTARY PUBLIC IN FOR SAID COUNTY AND STATE PERSONALLY CAME D.D. ANDRUS WHO DID ACKNOWLEDGE THE SIGNING OF THE ABOVE
 NOTARY PUBLIC

MAP OF ALOYS J. NAGEL ESTATE
 D-VOL. 841 PG. 271
 SECTION 26 AVON TOWNSHIP 7, RANGE 16
 CITY OF AVON, LORAIN COUNTY, OHIO
 MAP COMPILED FROM FORMER SURVEYS AND DEEDS
 SCALE 1" = 100' MAY 17, 1965
 BY D.D. ANDRUS REG. SURVEYOR
 405 ELYRIA BLOCK ELYRIA, O.

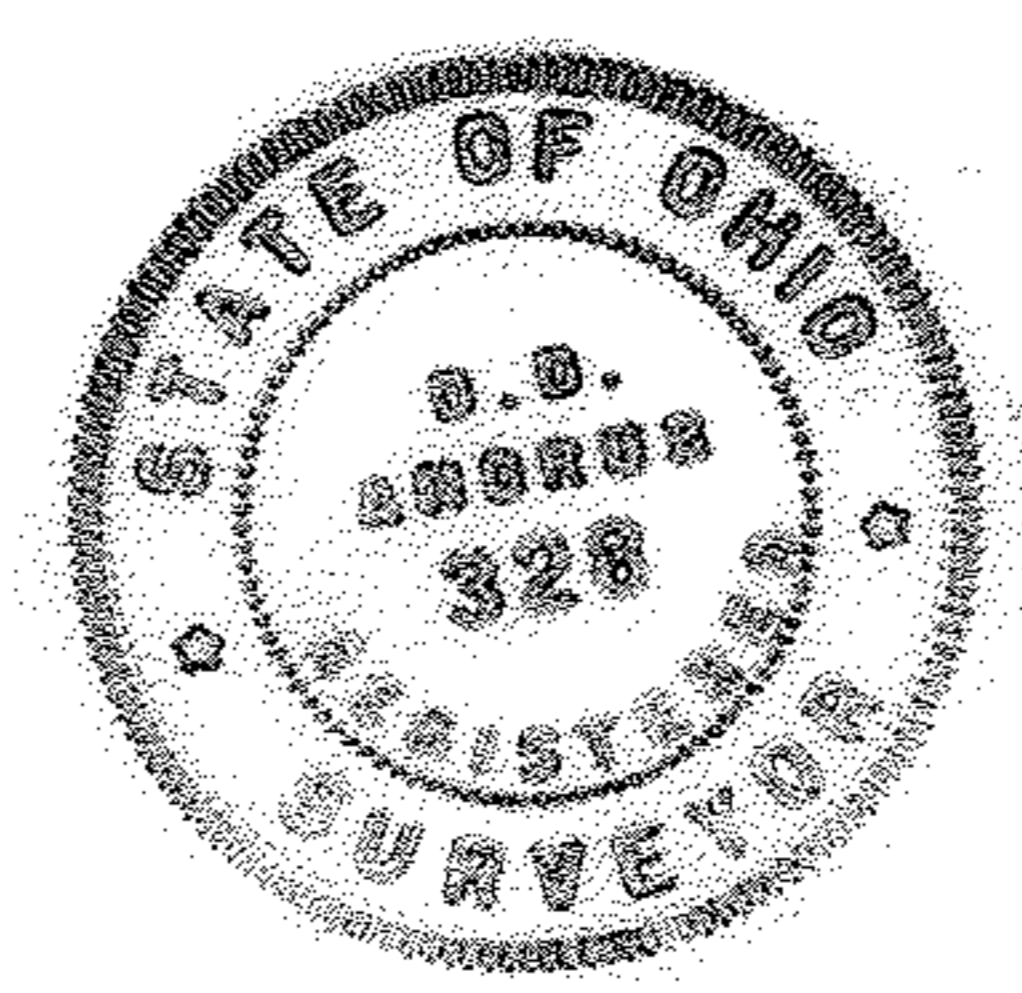

BEREA QUADRANGLE
 41°-27'-30" 81°-58'-30"
 PPN 04-00-026-108-040
 MAP Pp 04-00-026-B

201482 B