

J. W. WARDEN & ASSOCIATES


CIVIL ENGINEERS AND SURVEYORS

D. D. ANDRUS, PRESIDENT
405 ELYRIA BLOCK
ELYRIA, OHIO

TELEPHONES 3211
42871

M. W. JACKSON
SECRETARY

STATE OF OHIO
REGISTERED { PROFESSIONAL ENG.
SURVEYOR

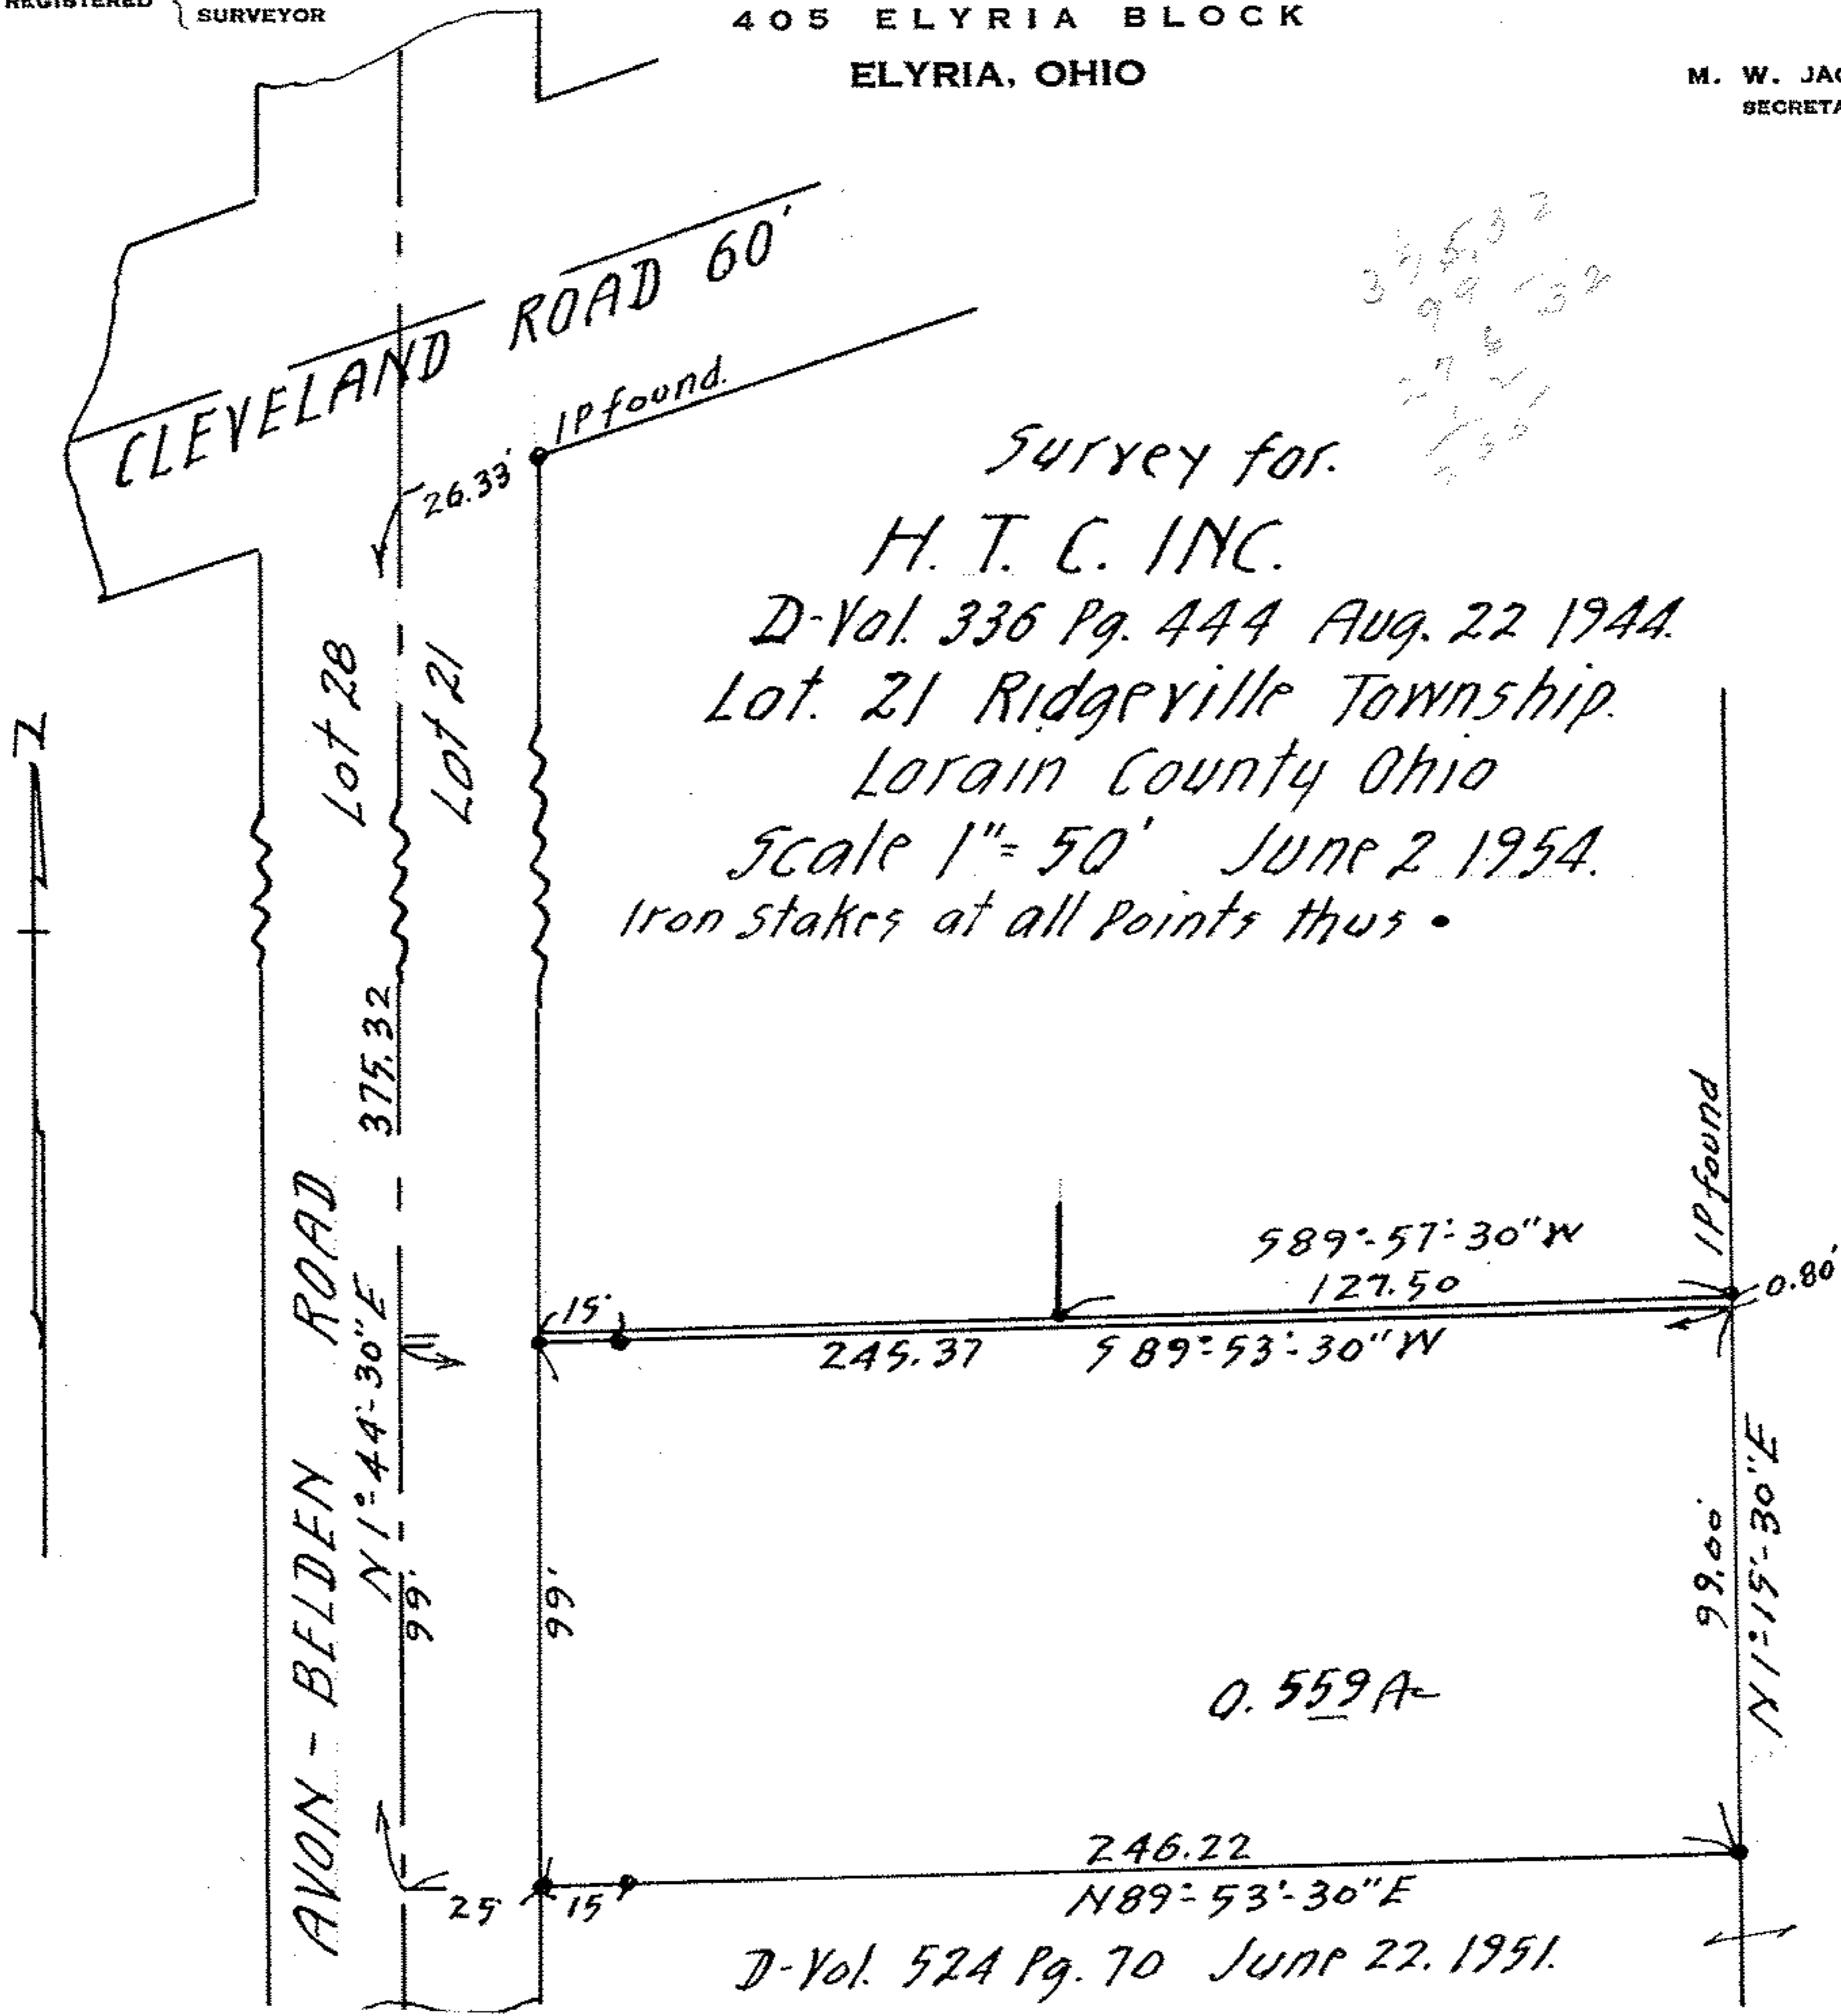

Board of Education of Ridgville Twp.
D-Vol. 196 Pg. 414 July 18. 1923.

PPN 07-00-021-117-???

900236 D

MAP Pg 07-00-021-C