


19-1104

DURKEE ROAD 60'

GUSTAF AND AUGUSTA BRAUER
D-VOL. 336 PG. 278 JULY 13 1944

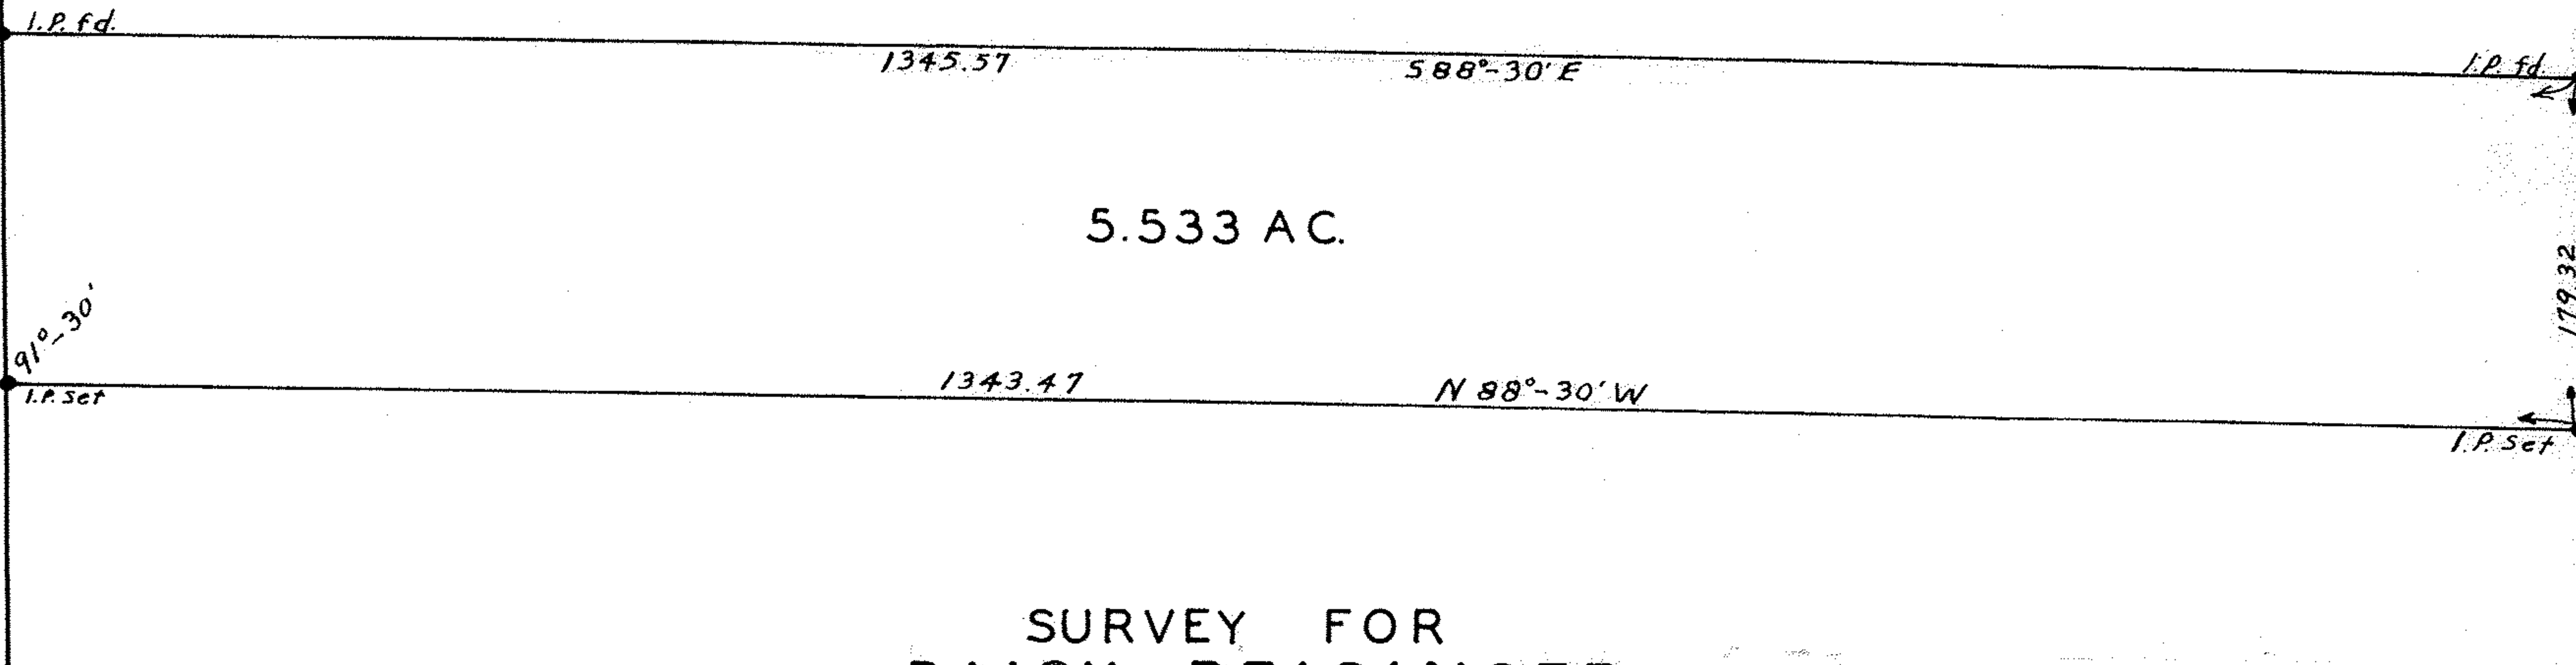

5.533 AC.



SURVEY FOR
DAISY REISINGER
 D-VOL. 336 PG. 293 JUNE 24, 1944
 ORIGINAL LOT 76 EATON TWP.
 LORAIN COUNTY, OHIO
 SCALE 1"=100' APRIL 1, 1953

J.W. WARDEN AND ASSOCIATES REG. SURVEYOR'S

PPN 11-00-076-000-???

MAP pg 11-00-076-A

121159