


PPN 04-00-004-102-222

MAP P9 04-00-004-E

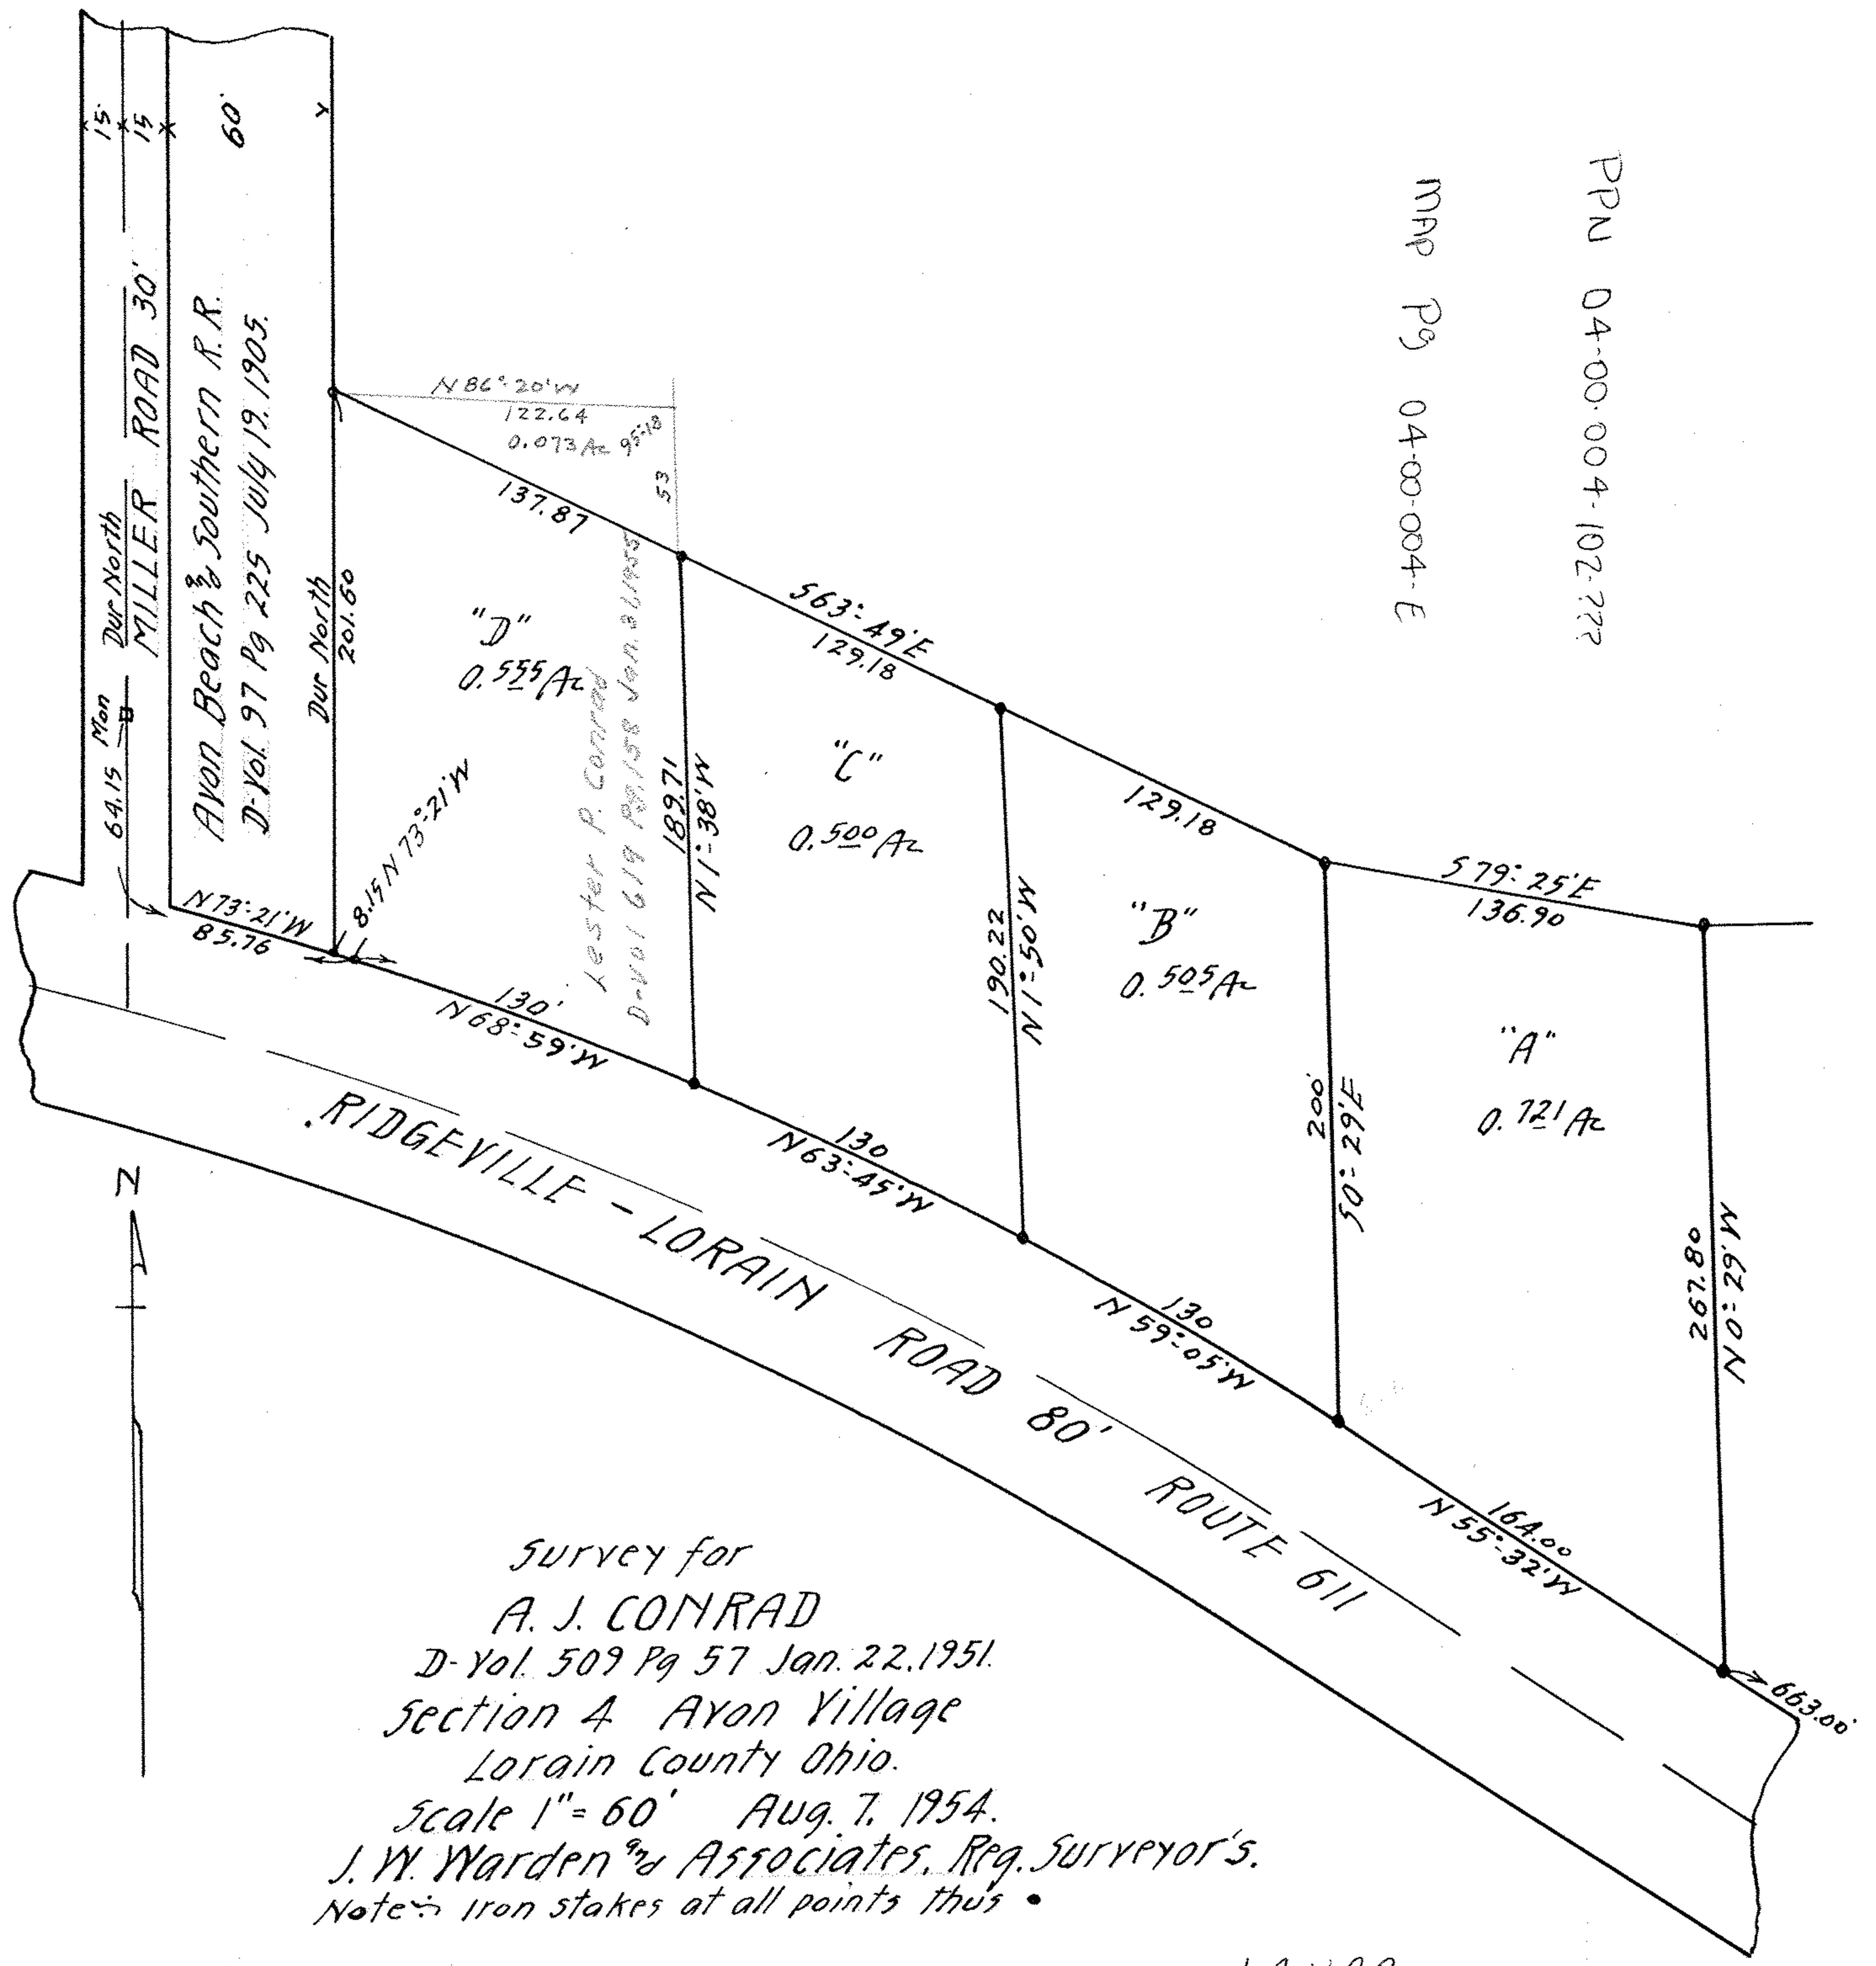

Survey for  
 A. J. CONRAD  
 D-Vol. 509 Pg 57 Jan. 22, 1951.  
 Section 4 Ayon Village  
 Lorain County Ohio.  
 Scale 1" = 60' Aug. 7, 1954.  
 J. W. Warden & Associates, Reg. Surveyor's.  
 Note: Iron stakes at all points this •

121199

1211-5