

# J. W. WARDEN & ASSOCIATES

CIVIL ENGINEERS AND SURVEYORS


D. D. ANDRUS, PRESIDENT  
405 ELYRIA BLOCK  
ELYRIA, OHIO

15-1183

TELEPHONES 3211  
42871

STATE OF OHIO  
REGISTERED } PROFESSIONAL ENG.  
SURVEYOR

M. W. JACKSON  
SECRETARY

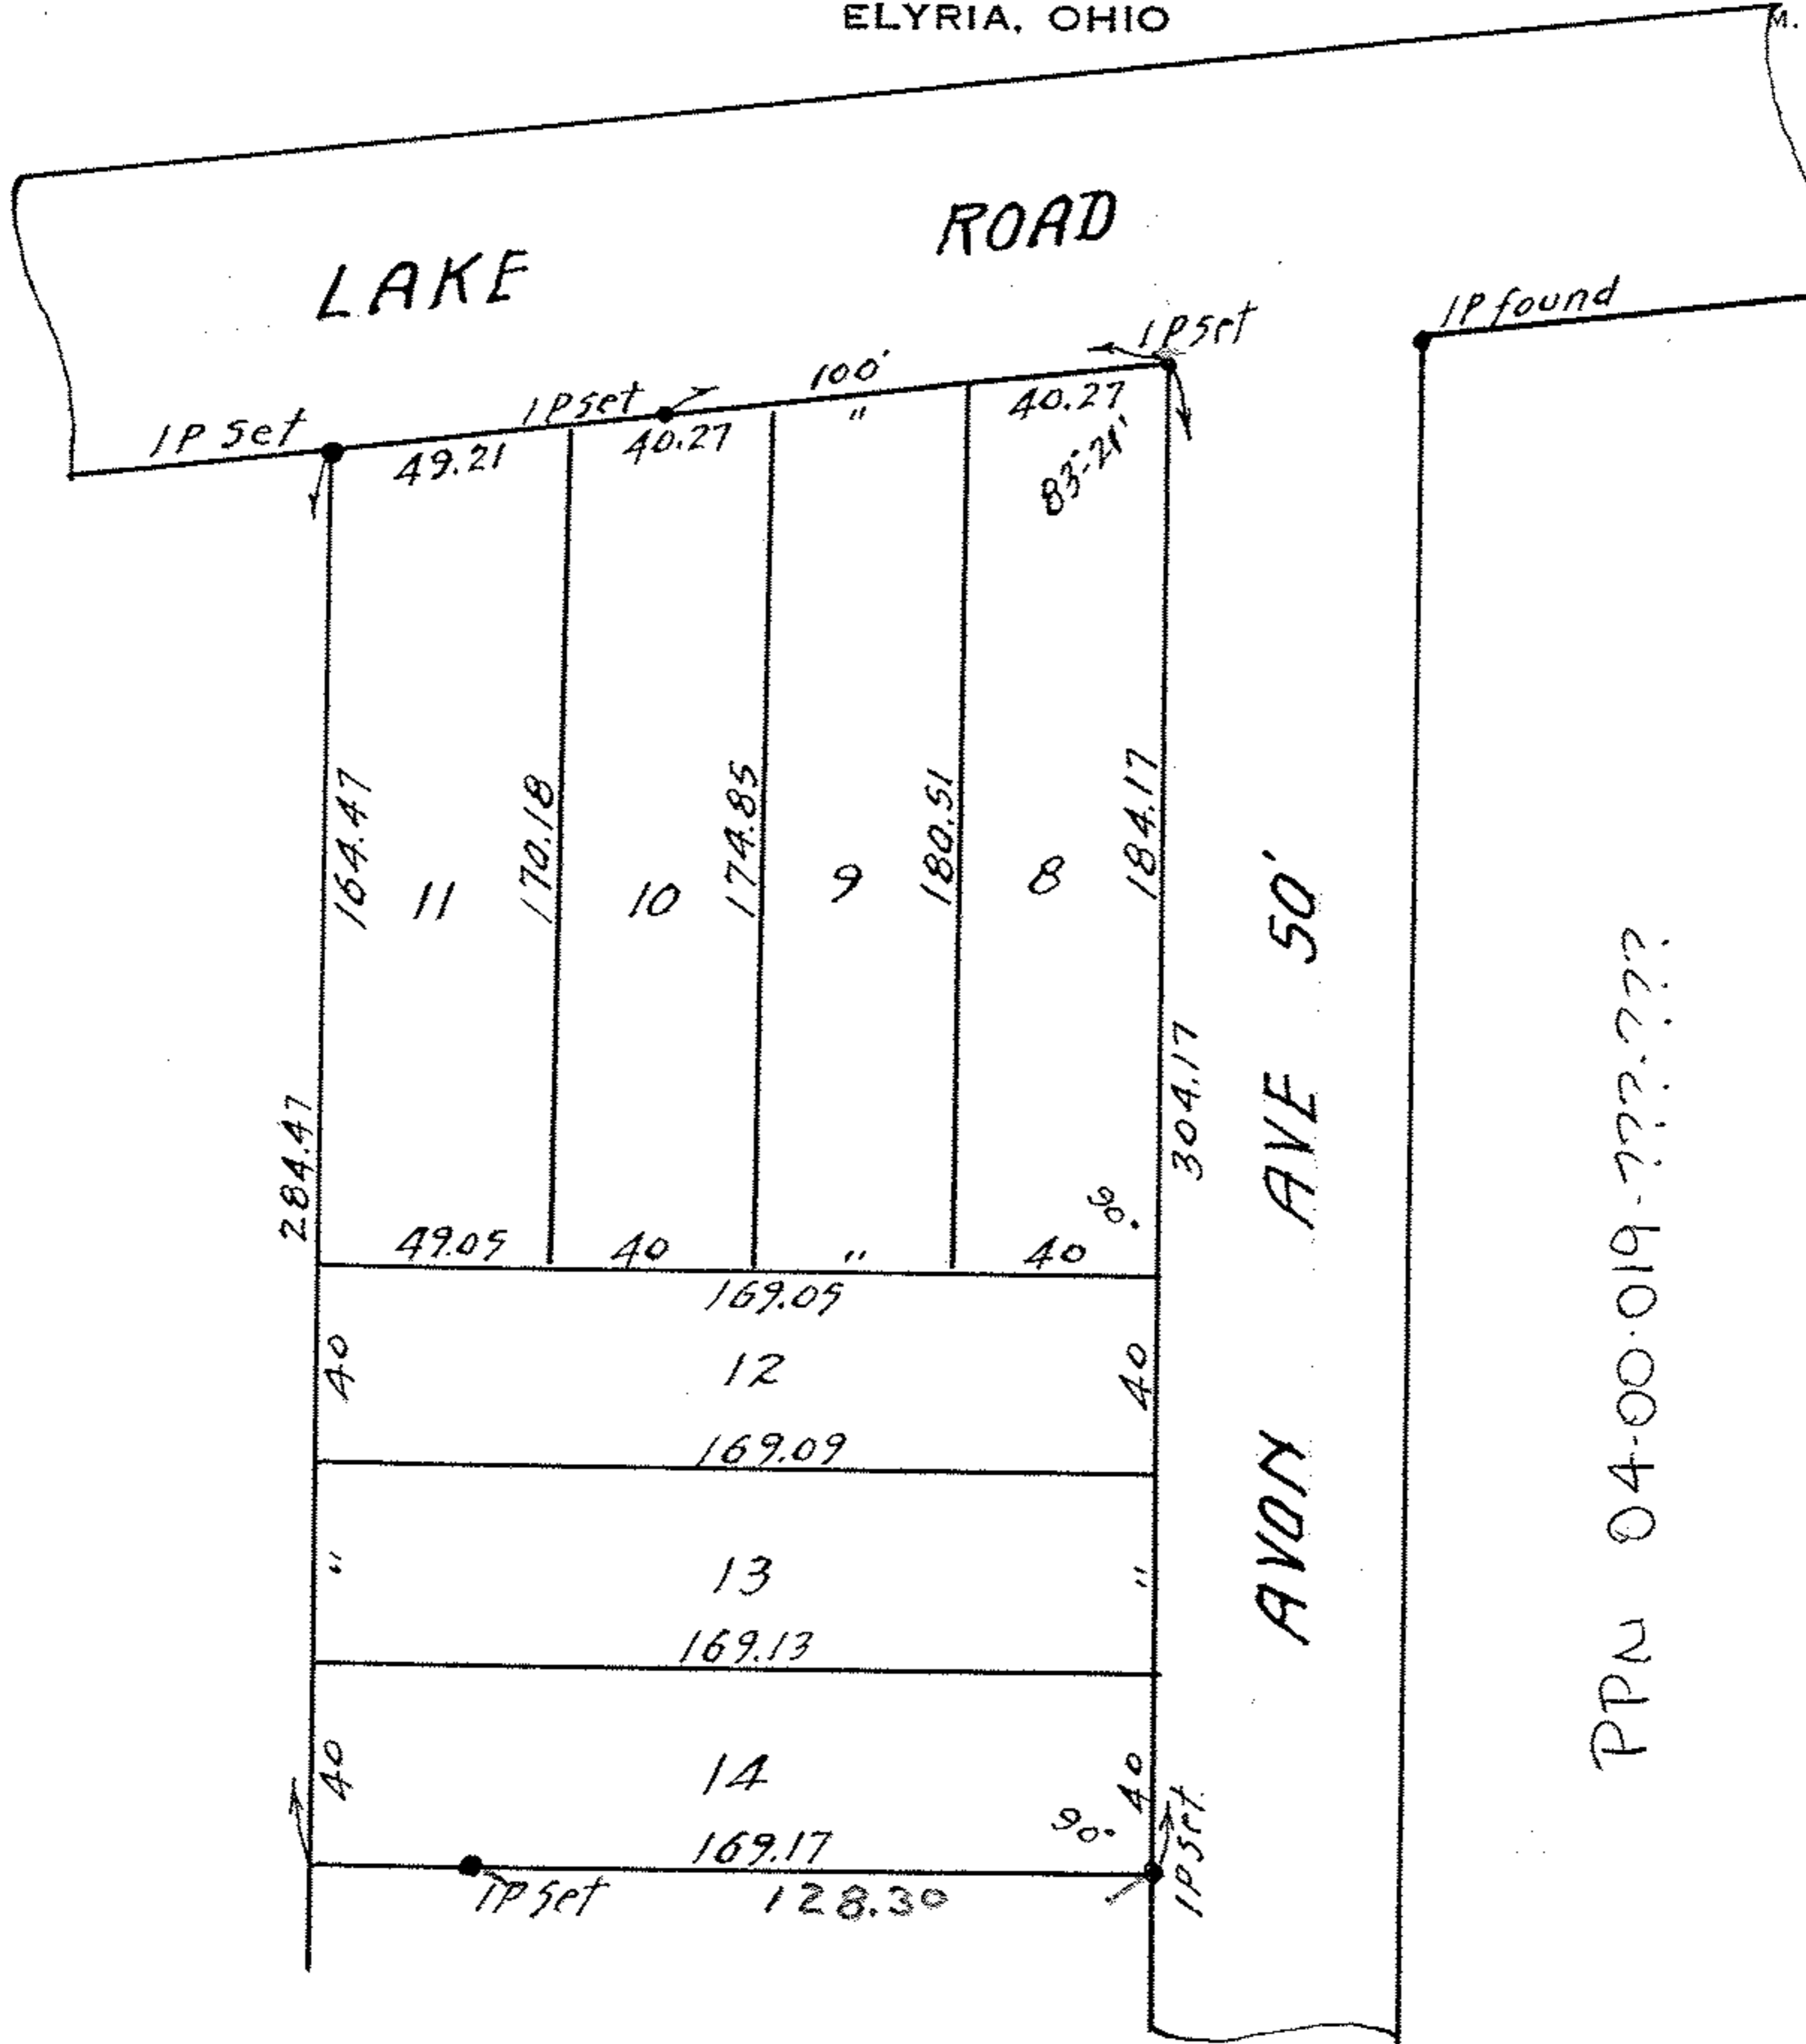

PPN 04-00-019-1111.111

MAP Pg 04-00-019-B

SURVEY FOR  
STEPHEN'S MARKET  
SECTION 19 AVON LAKE VILLAGE  
LOTS 8-9-10-11-12-13-14  
AVON POINT ALLOTMENT MAP VOL. 7 PG. 15  
LORAIN COUNTY, OHIO  
SCALE 1" = 60' DEC. 1, 1953

121183