

JOHN W. WARDEN

CIVIL ENGINEER AND SURVEYOR

405 ELYRIA BLOCK


ELYRIA, OHIO

STATE OF OHIO

REGISTERED } PROFESSIONAL ENG.
SURVEYOR

PHONES

BUSINESS 3211
RESIDENCE 38633

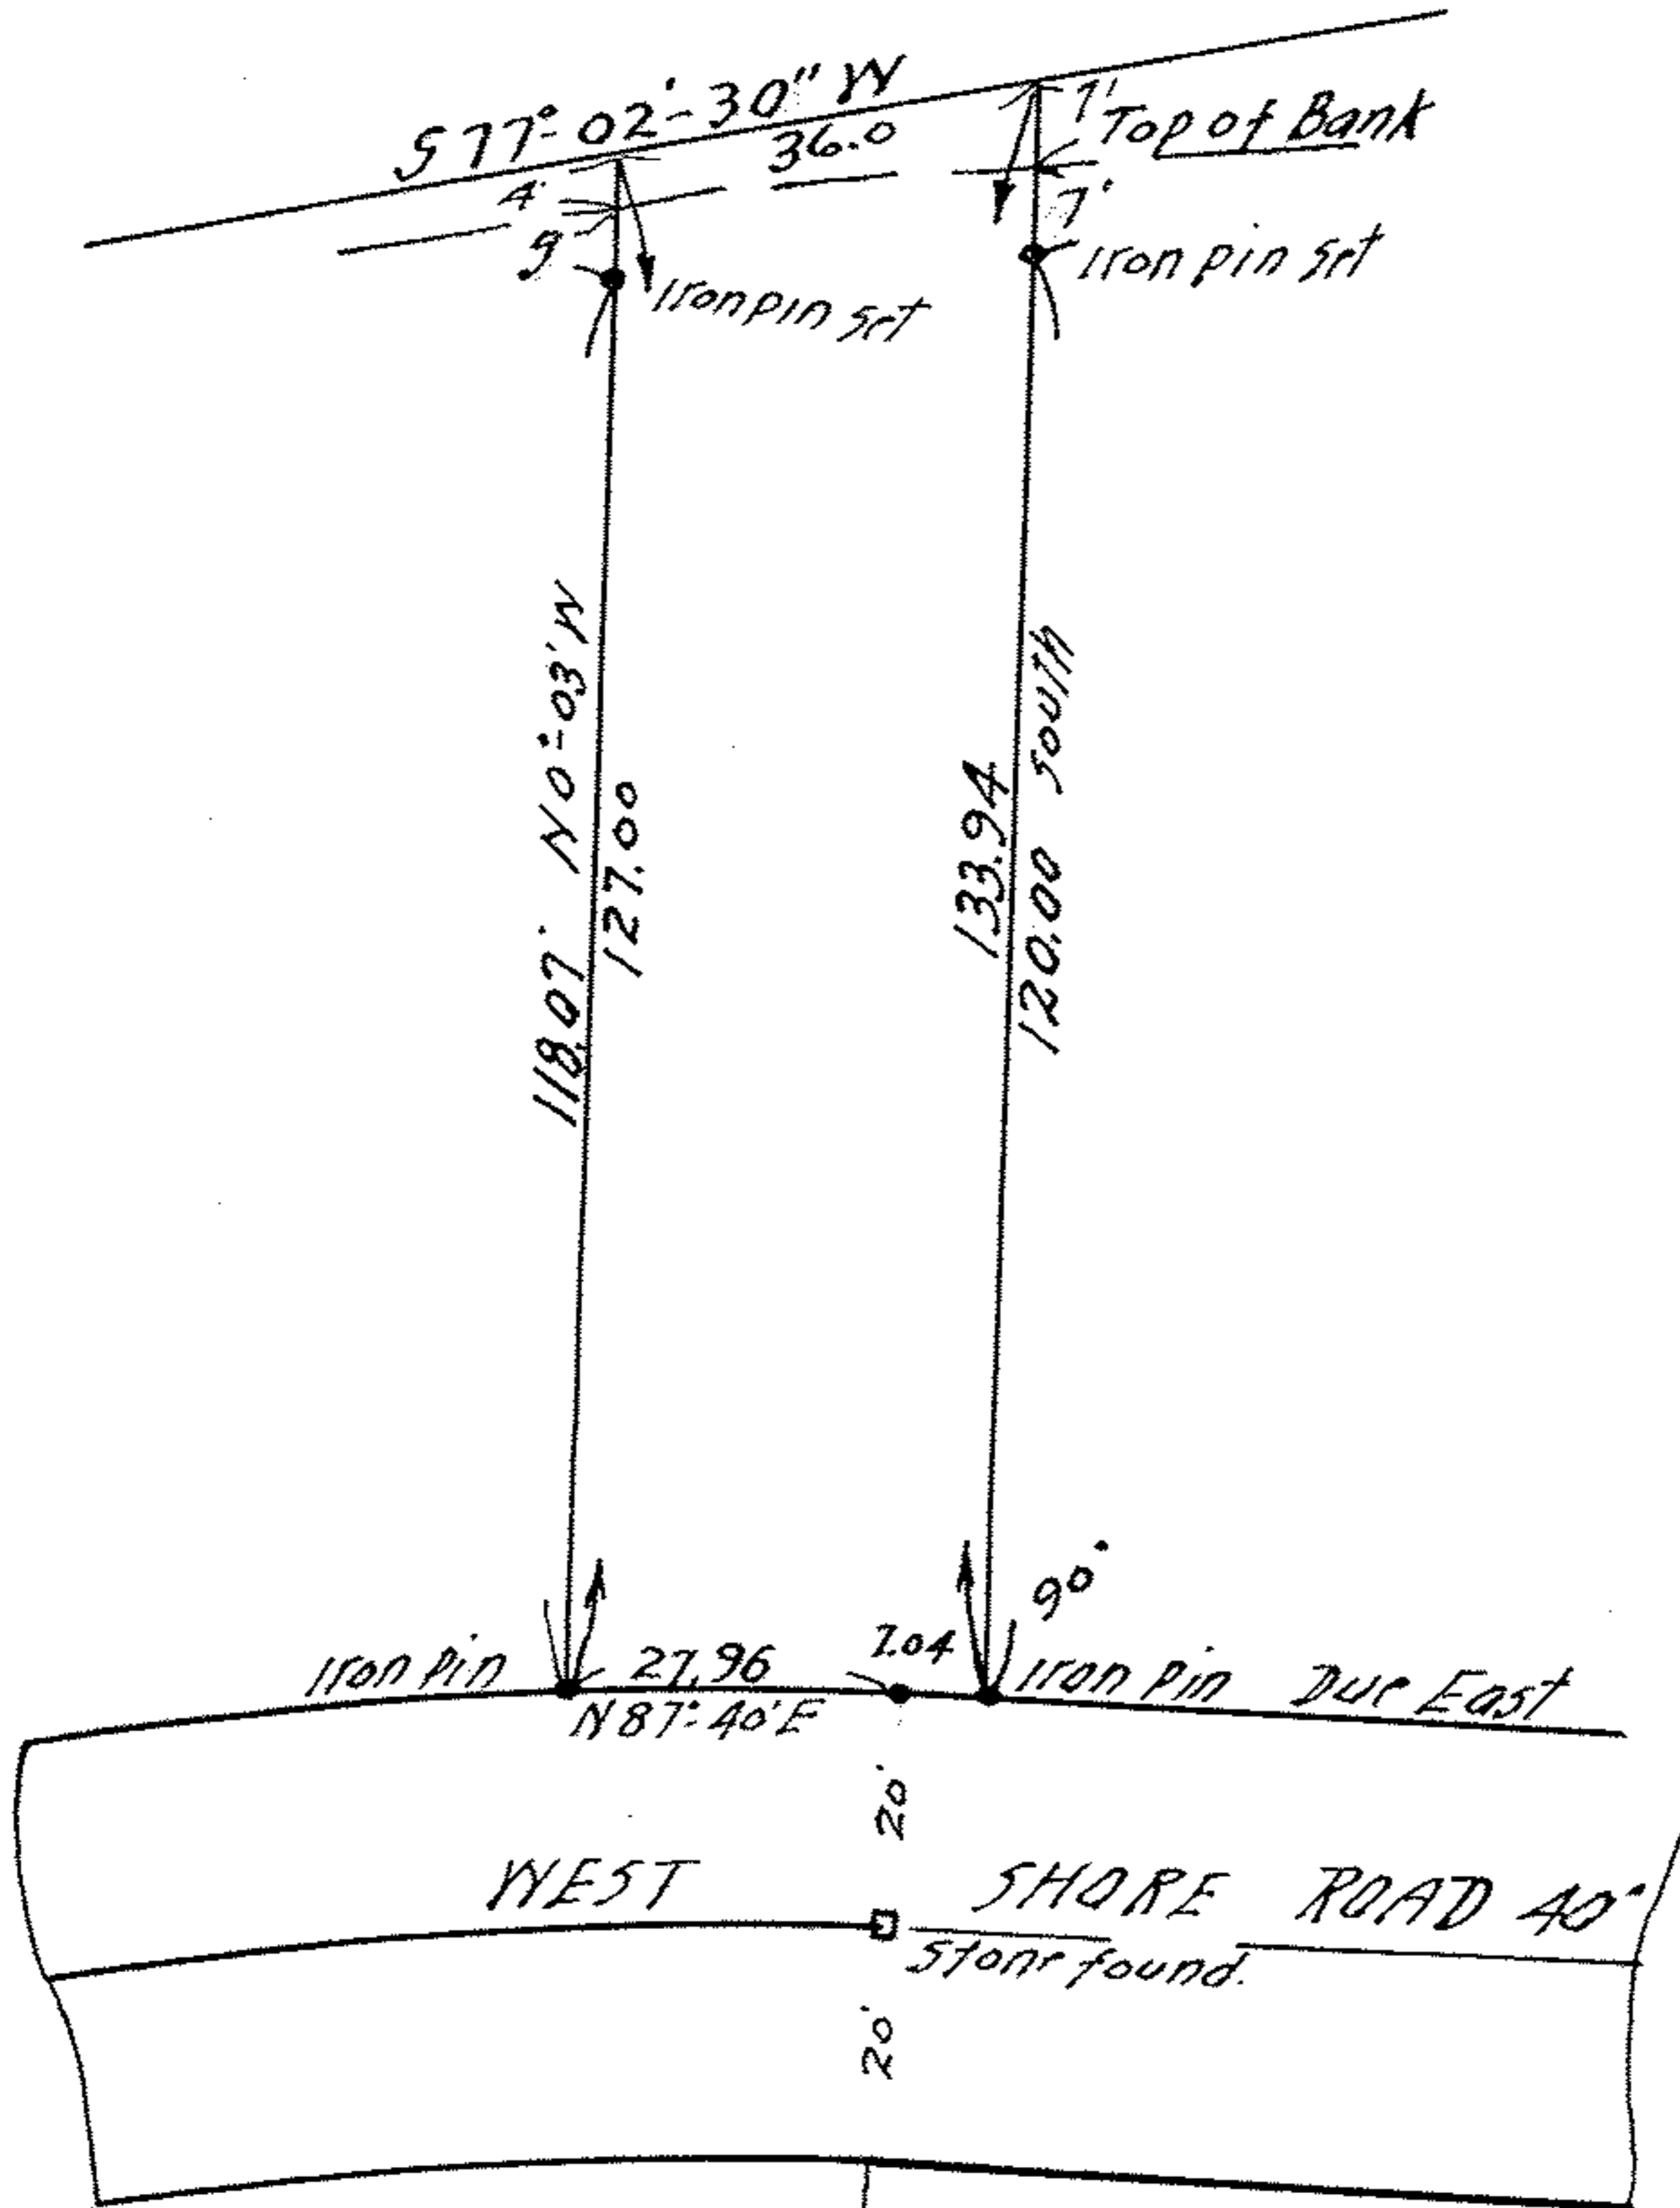

PL 51-261

MAP P3 4-00-006-D

PPN 04-00-006-101-222

Survey for
 JOSEPH A. ^{9th} PEARL M. TALABA
 Lot 20 Sandy Beach Subdivision Proposed.
 Section 6 Avon Lake Village, Lorain County Ohio.
 Scale 1" = 30' May. 7, 1949.

121019