


J88-51

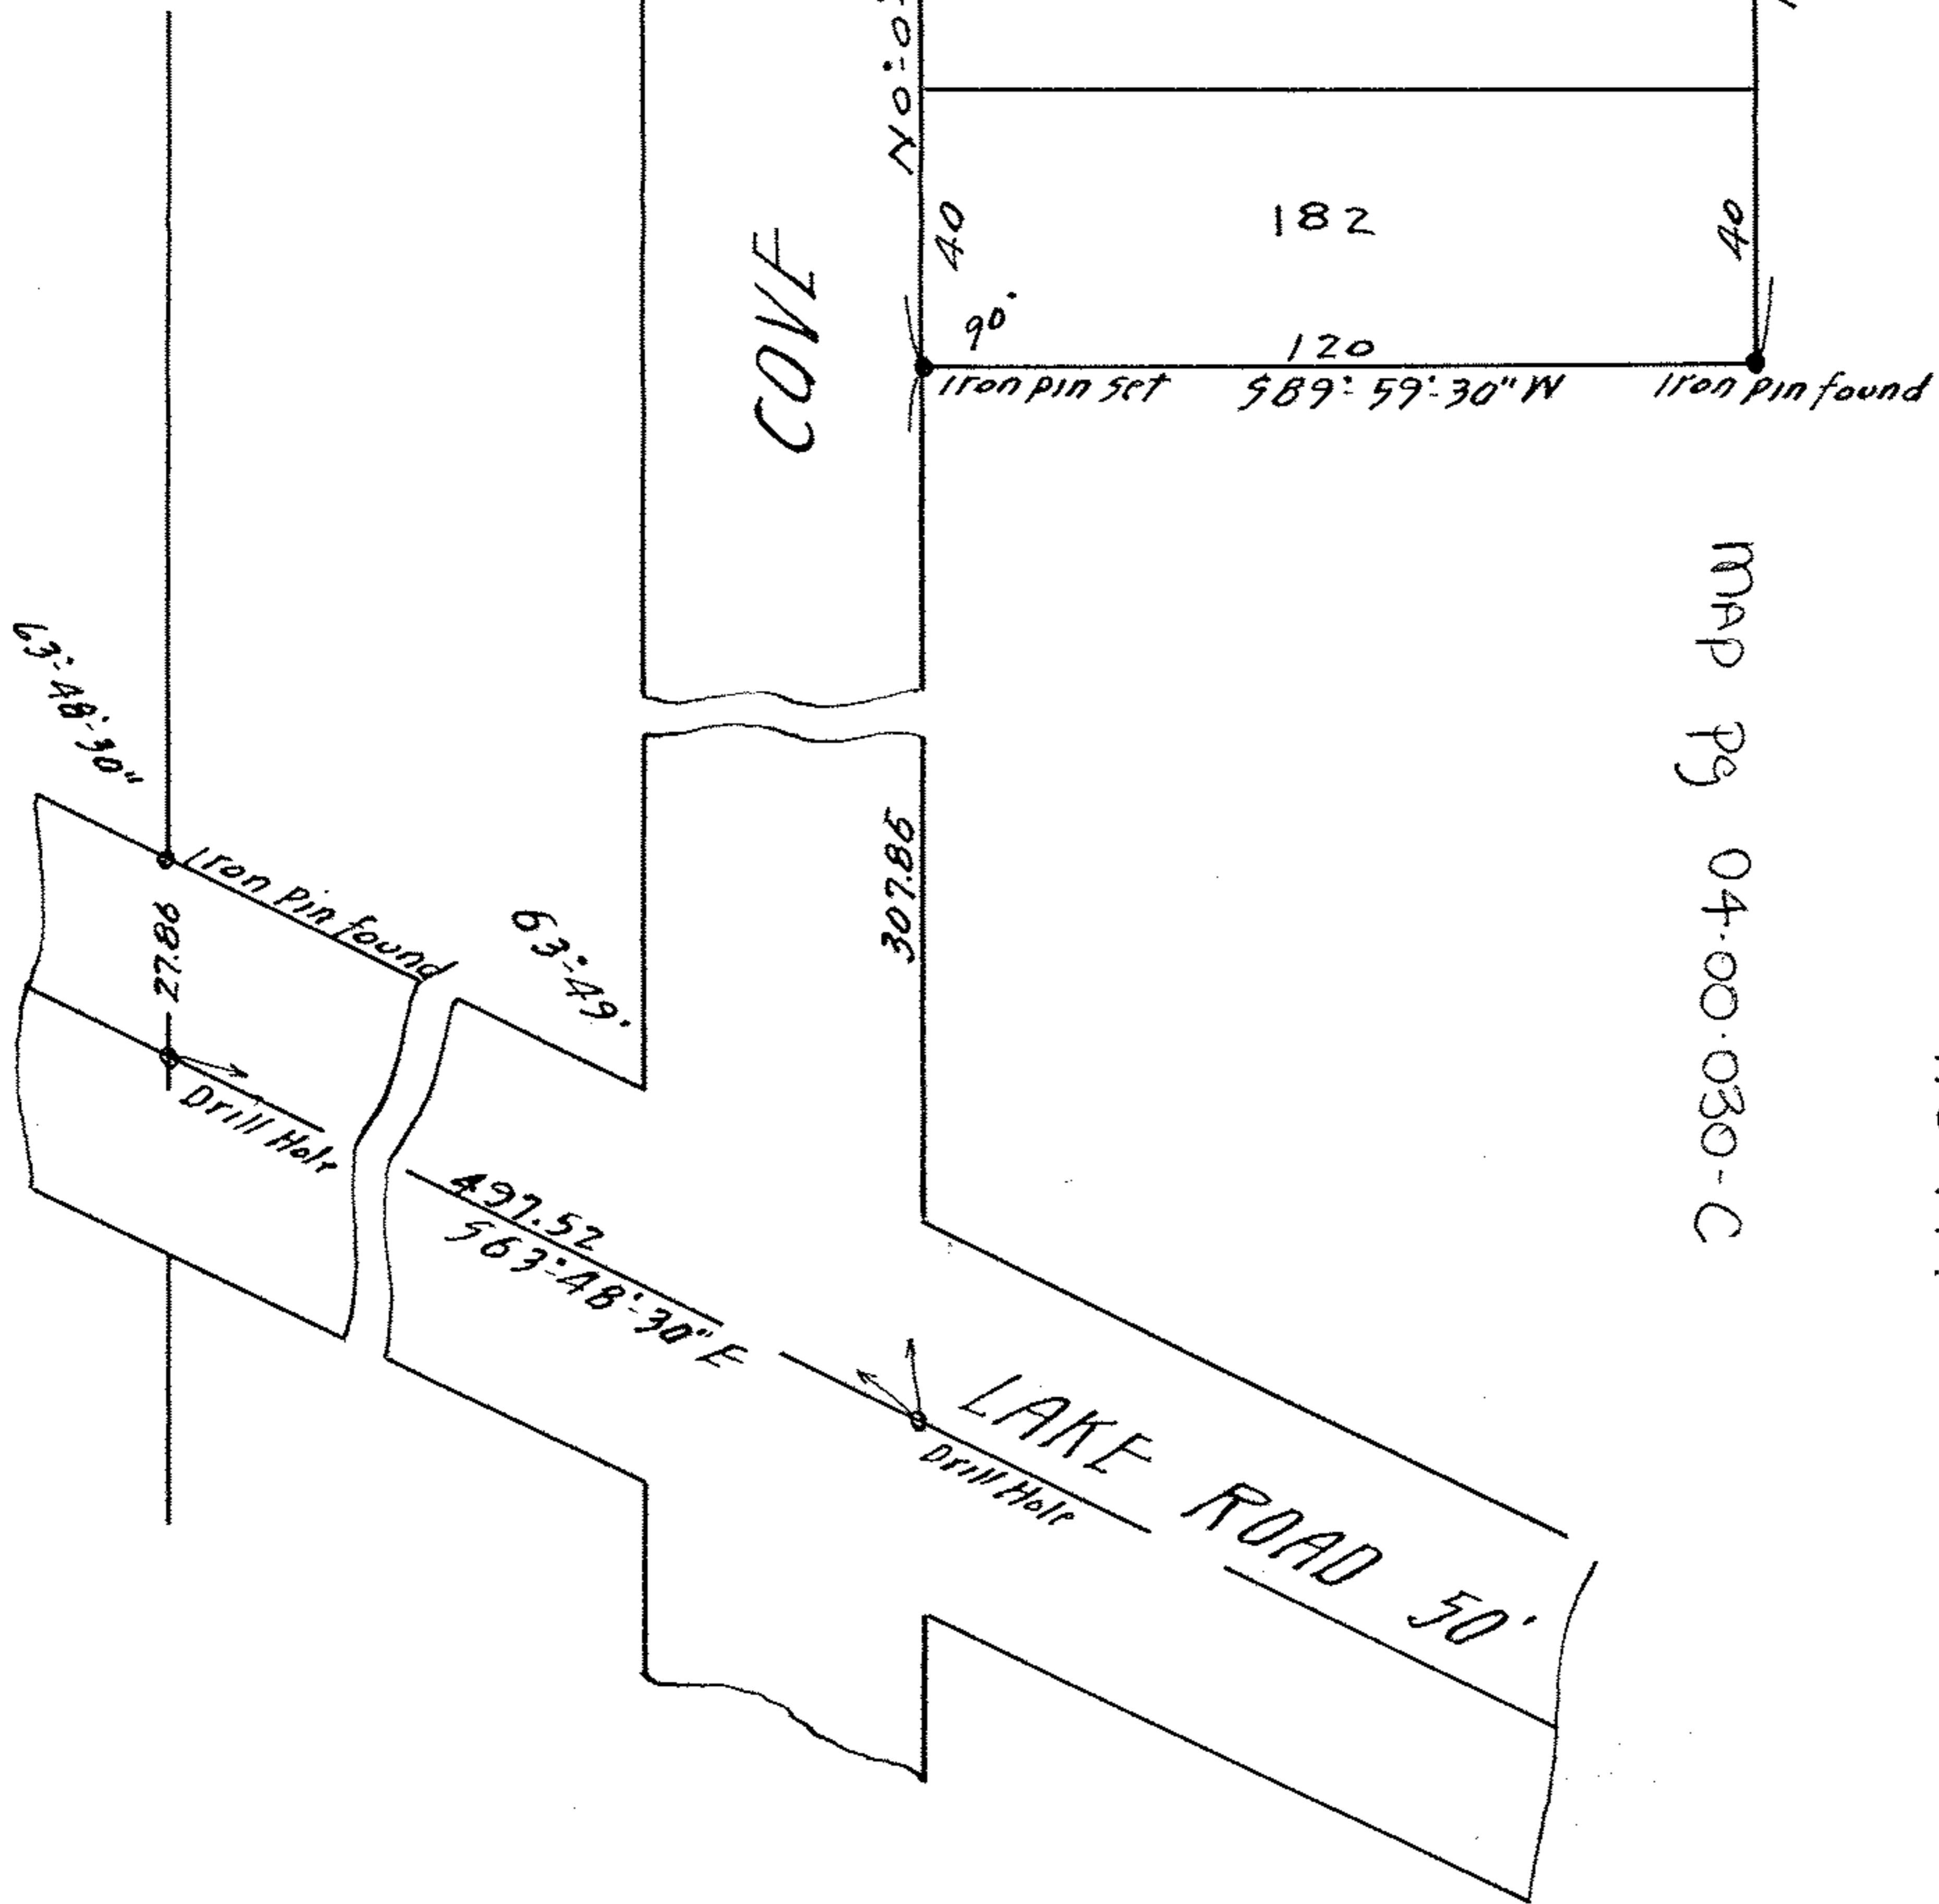

PPN 04-00-030-113-???

MAP pg 04-00-030-C

Survey for
 DELTA HARRIS DONALDSON
 Lots 179-180-181-182 Lake Breeze Allt. Vol. 7-Pg 33
 Avon Lake Village
 Lorain County Ohio
 Scale 1" = 40' Oct. 26, 1945.
 J. W. Warden. Registered Surveyor.

120886