


PPN 16-00-003-103-???

MAP PG 16-00-003 A, B

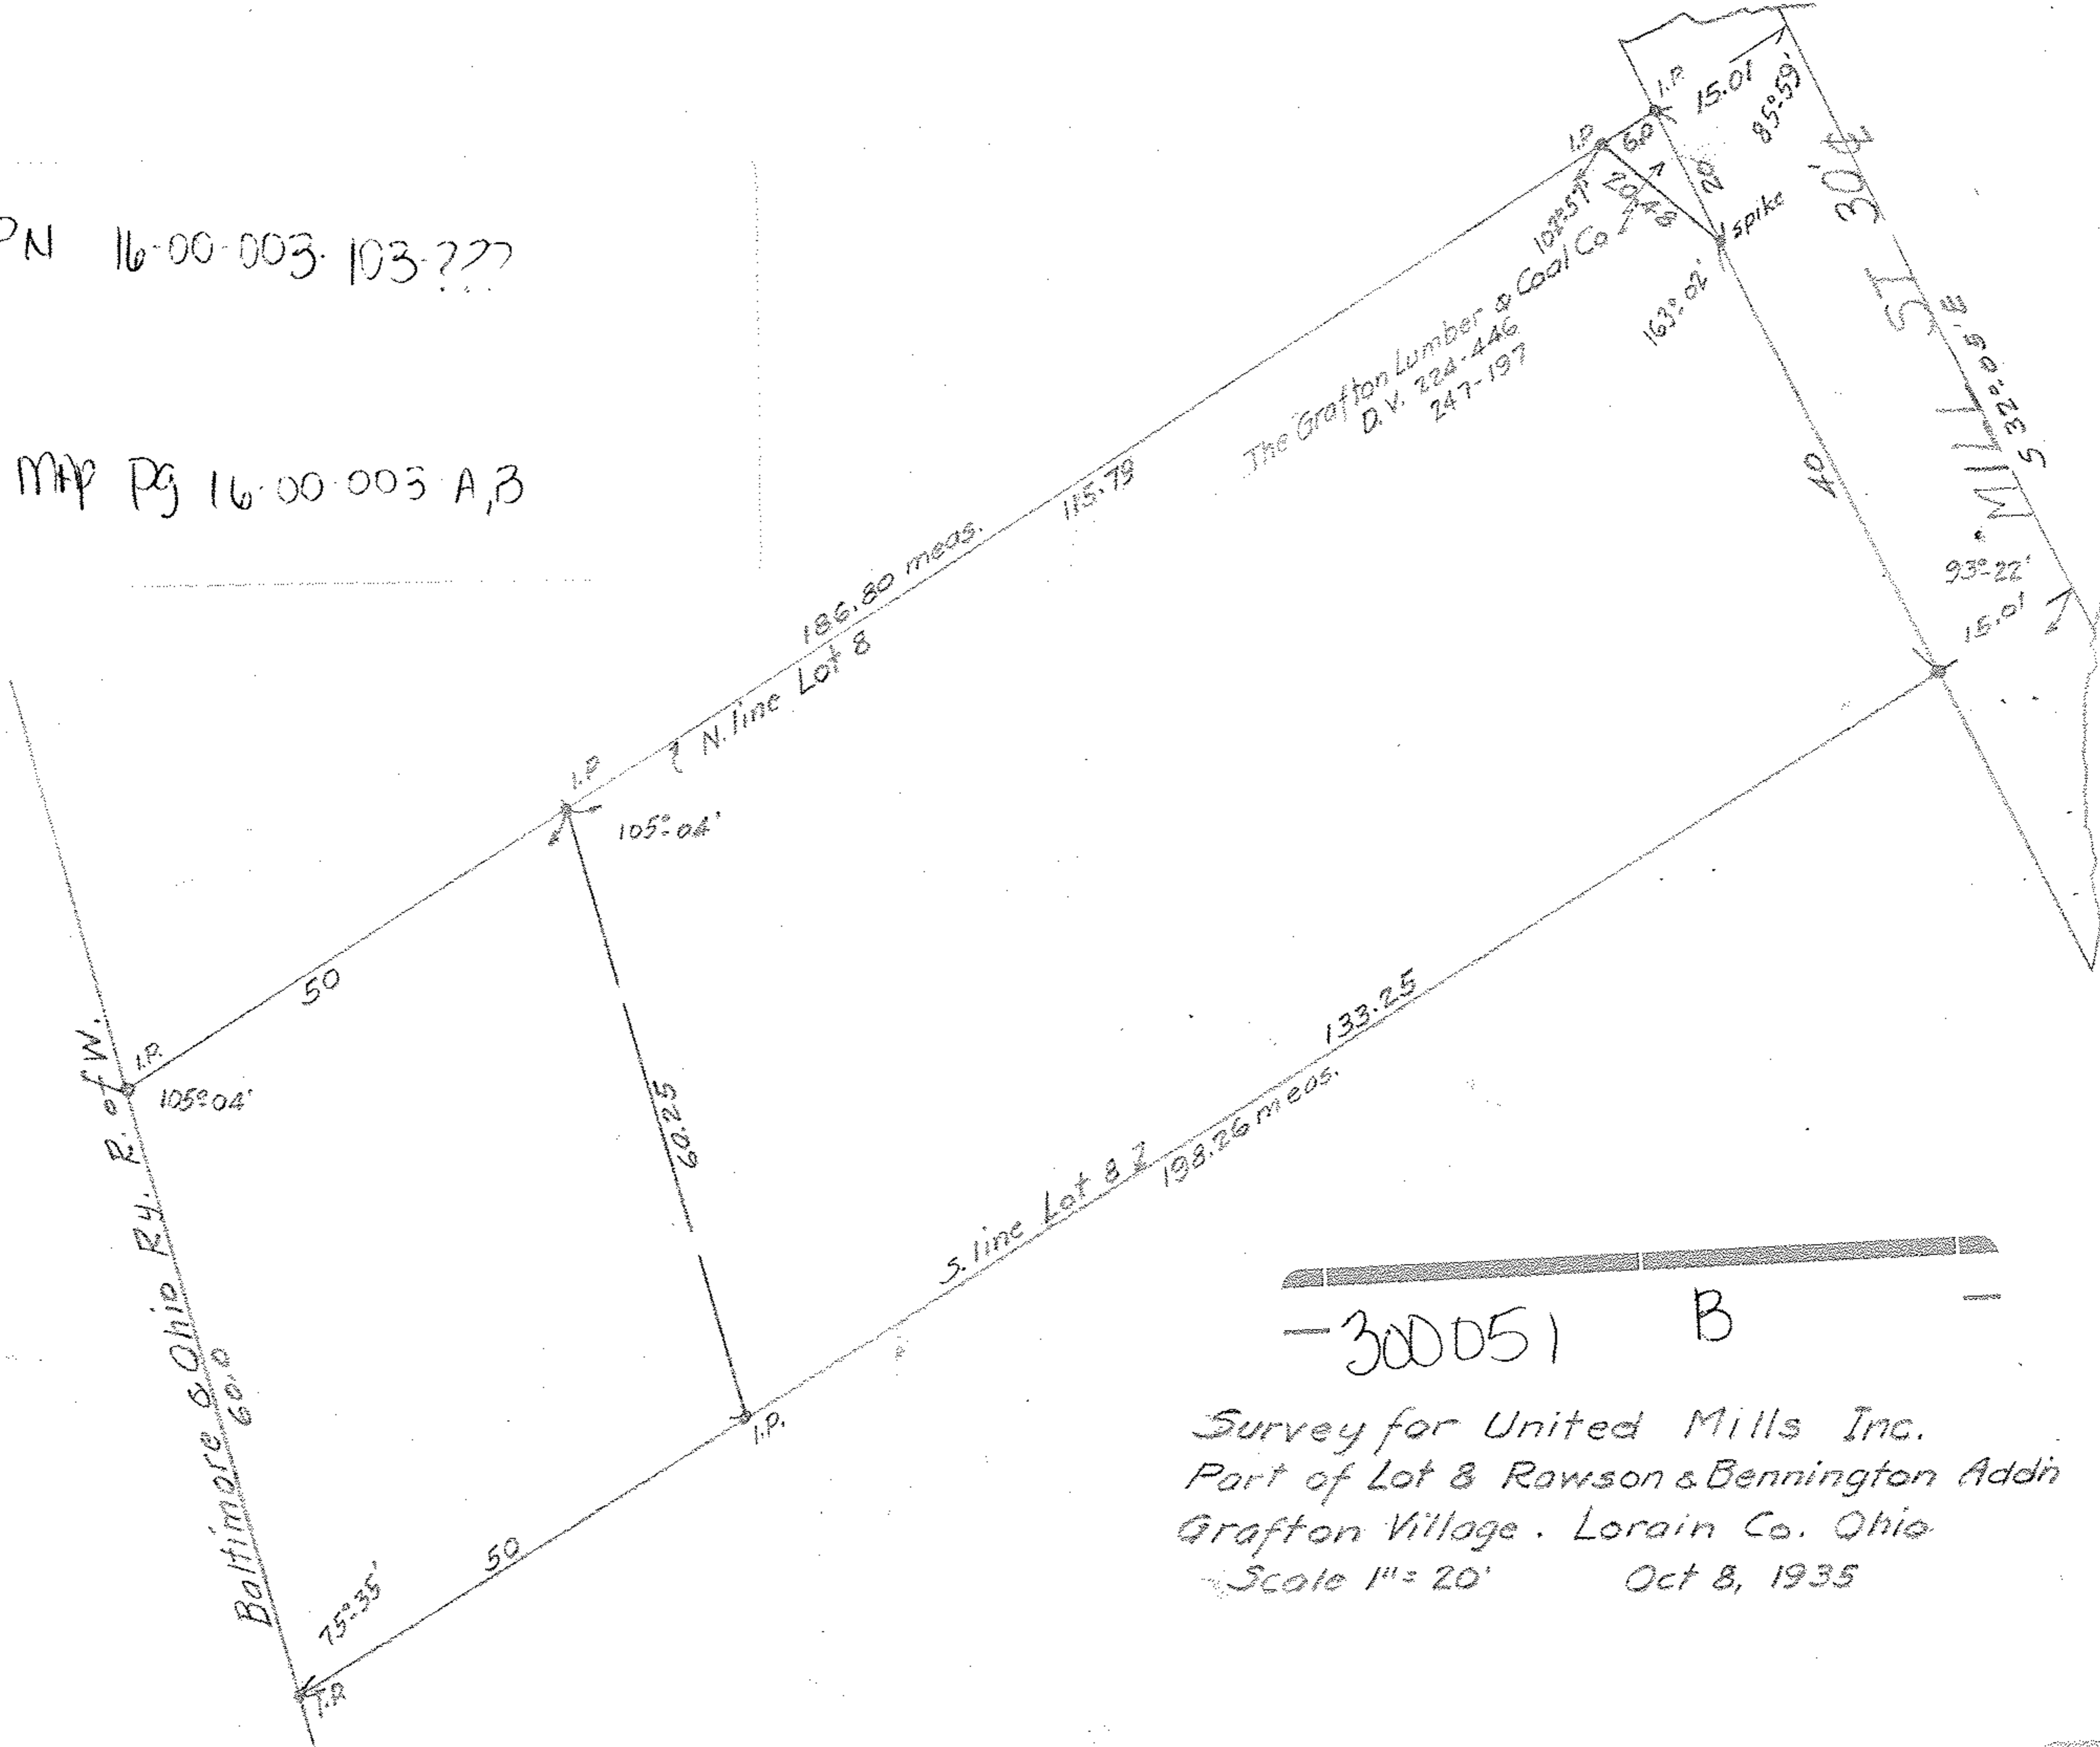

300051 B

Survey for United Mills Inc.
Part of Lot 8 Rawson & Bennington Addn
Grafton Village, Lorain Co., Ohio.
Scale 1" = 20' Oct 8, 1935