


PPN 16-00-056-000-008

MAP Pg 16-00-056-B

Land to be acquired from
Estate of Sarah J. Benton, Monosmith
Lot 56. Grafton Twp.,
Lorain Co., Ohio.
Aug 10, 1922. Scale 1" = 100ft.
Warden & Laundon,
Engineers.

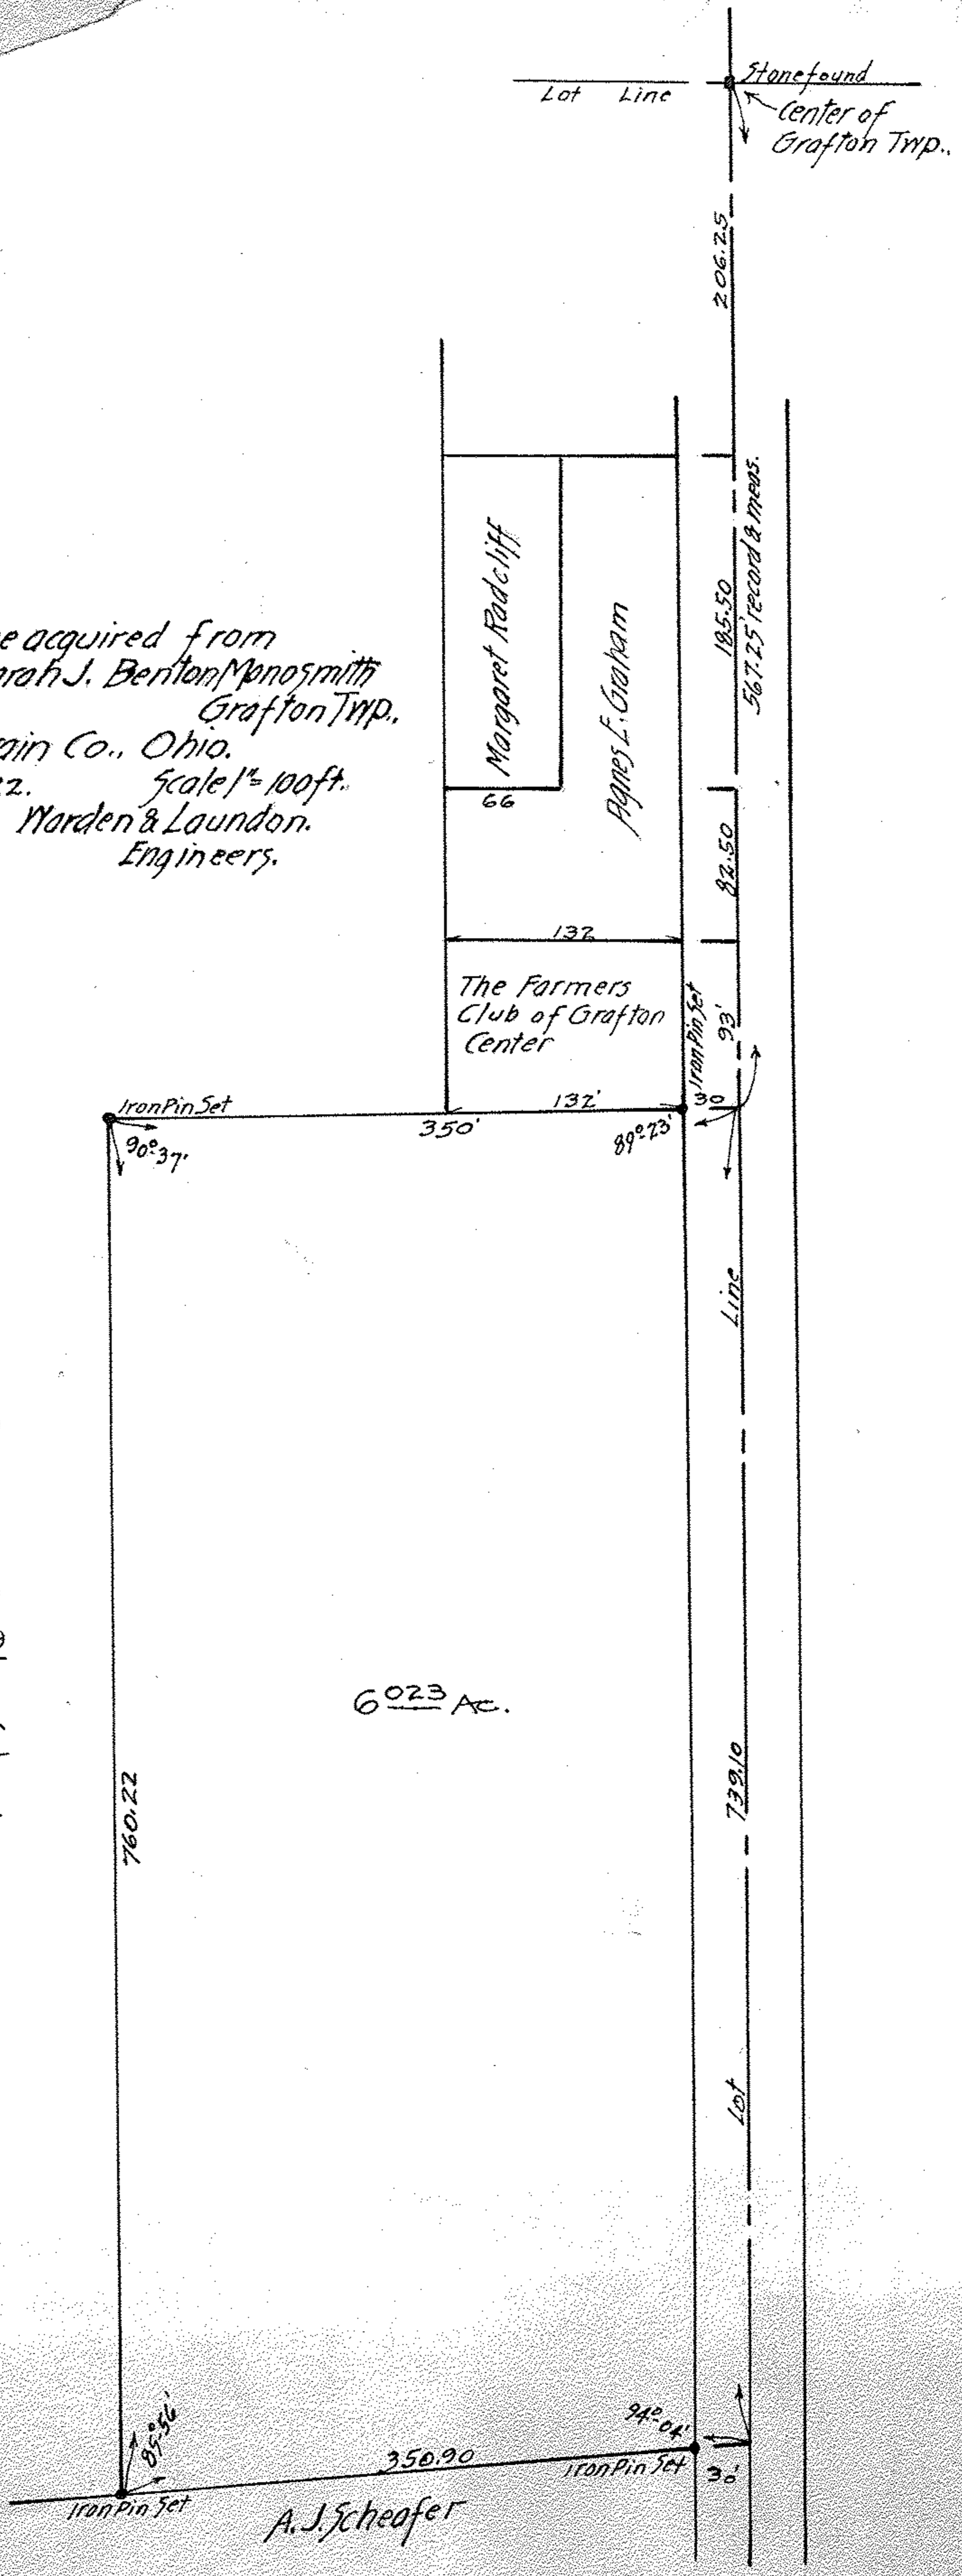

A. J. Scheefer