


PPN 03-00-112-102-222

MAP Pg 3-00-112-B

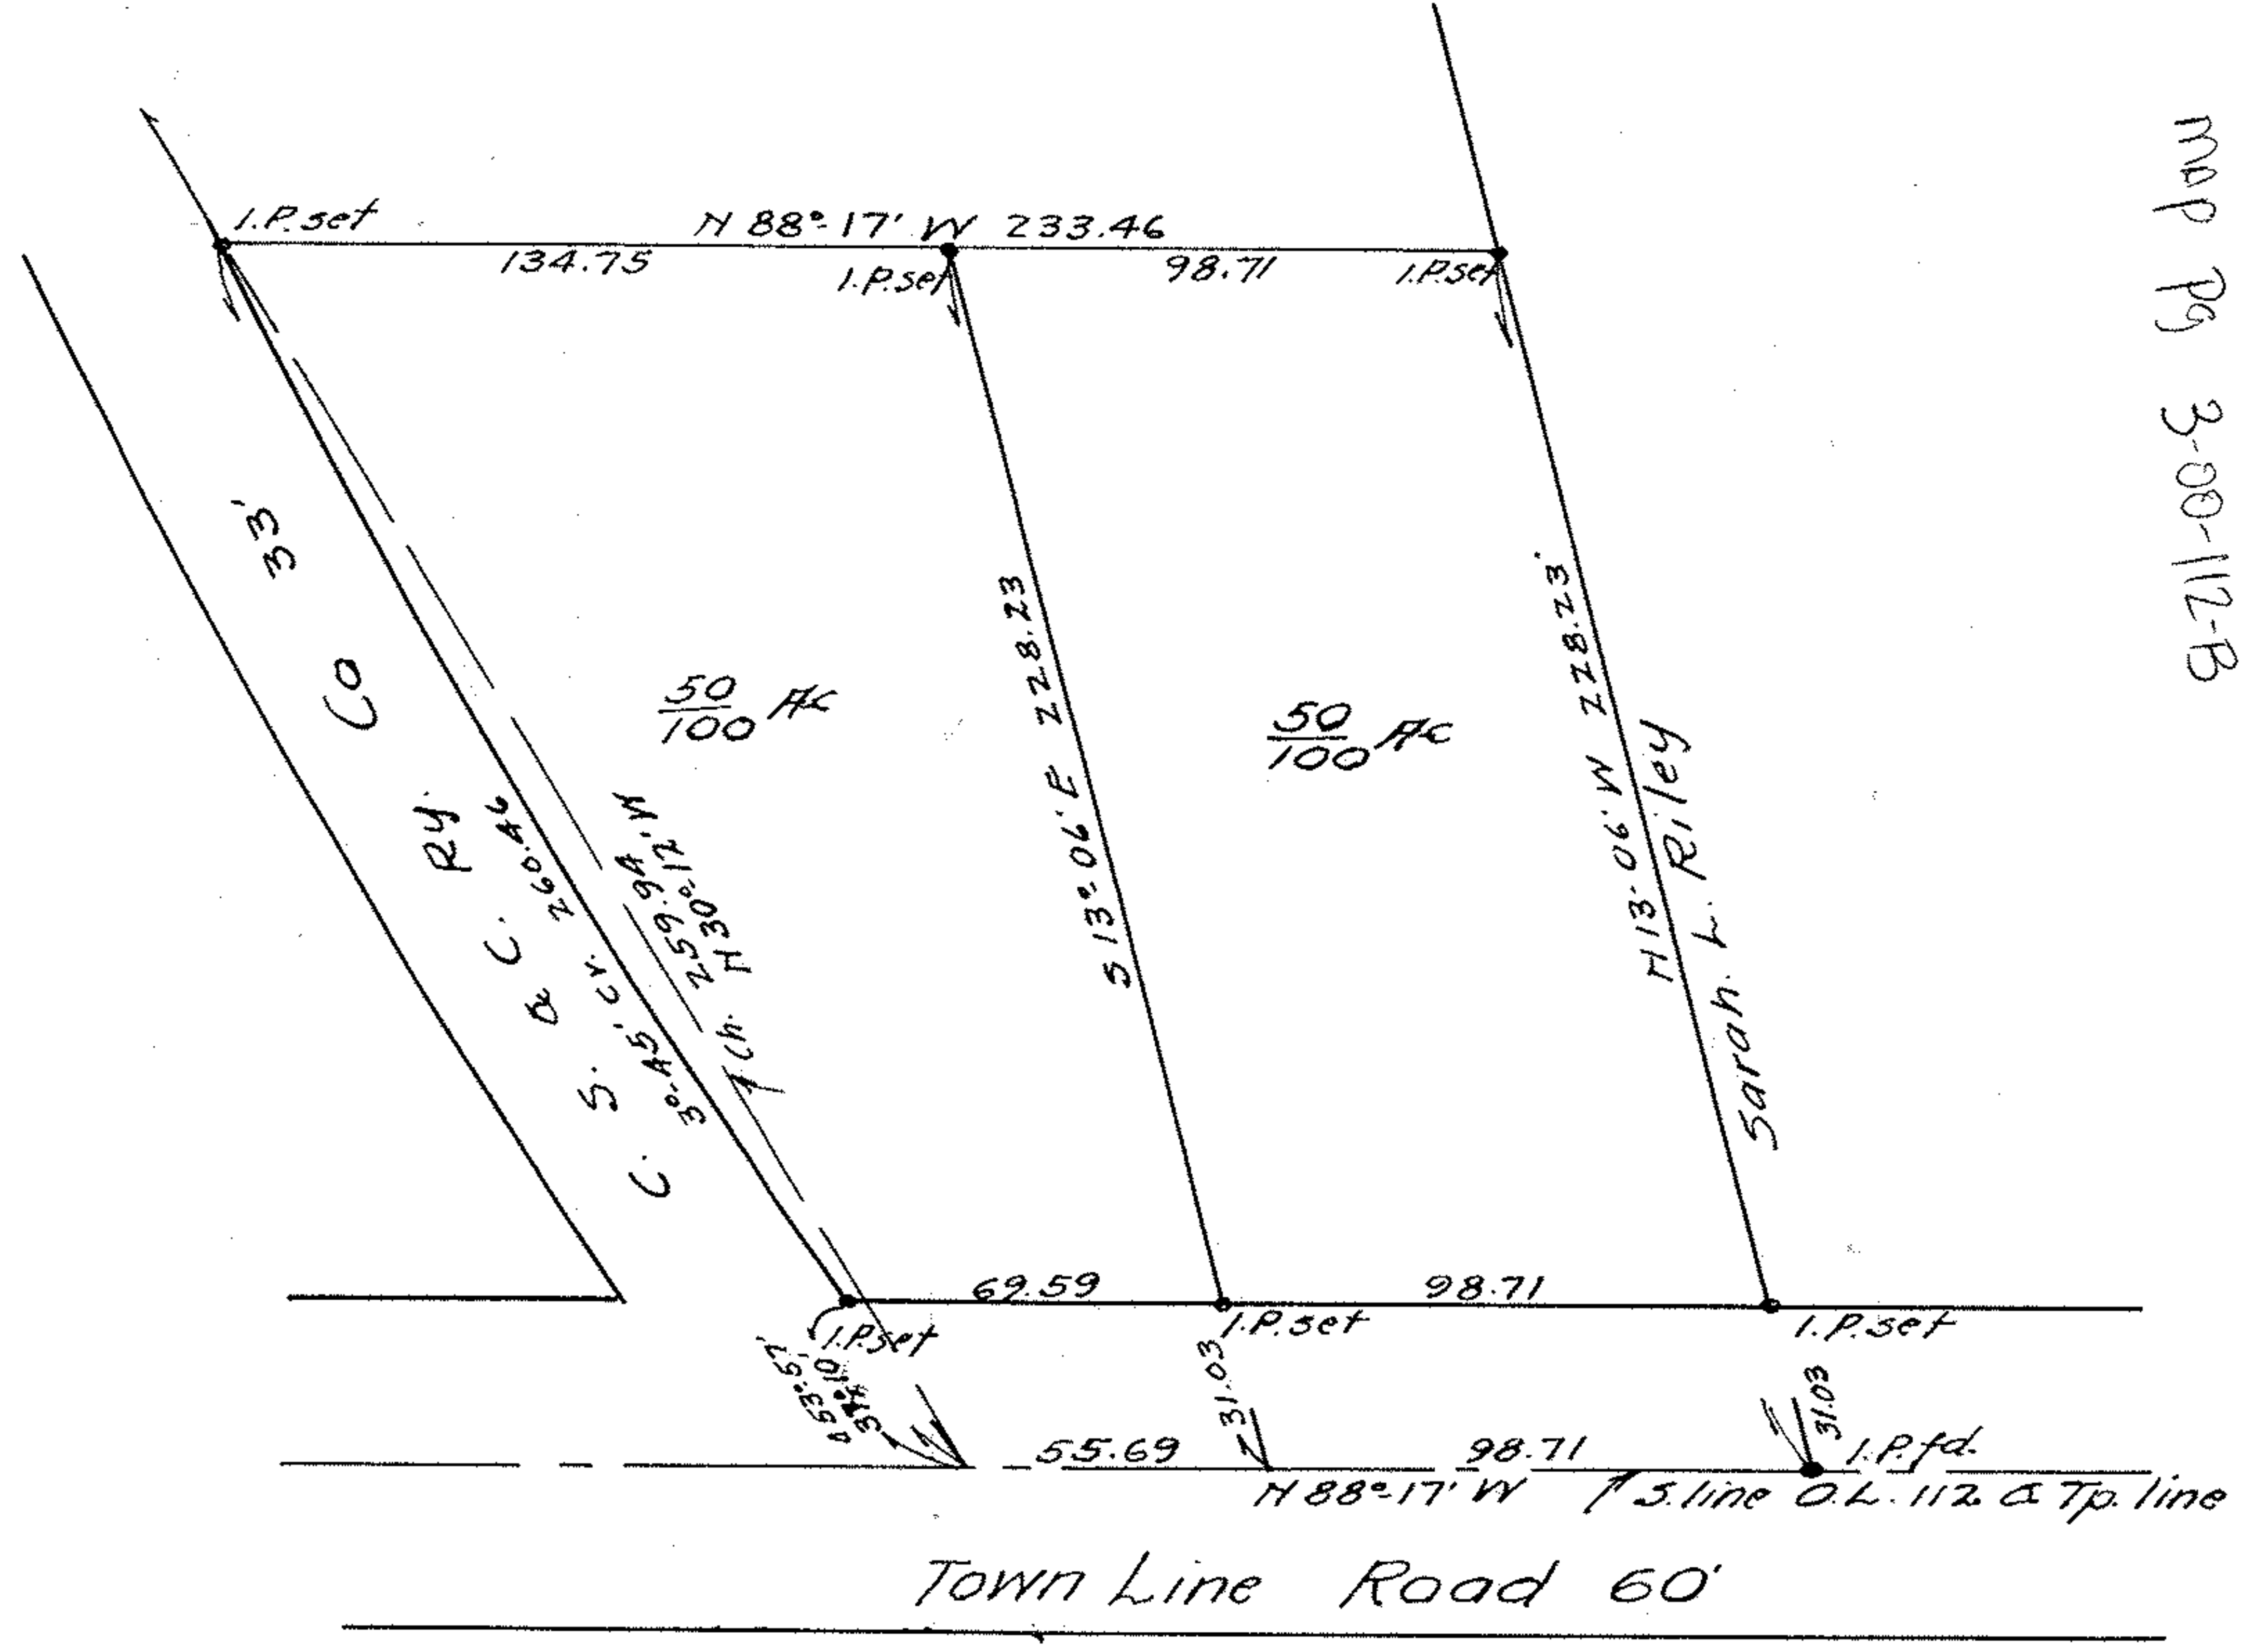

Town Line Road 60'

Survey for Willie Hecock
 Original Lot 112 Sheffield Tp. Lorain Co. Ohio.
 Scale 1" = 50' Aug 18, 23.
 Warden & Laundon
 Civil Engineers.

400 166 A

4-100