


Mathias & George Tomlin

S 87° 47' 00" E
2331.16'

Edward Doller
1925

63.939 Acres Total
0.528
63.411 Acres
2.224 "
61.187 " remaining
0.556
60.631

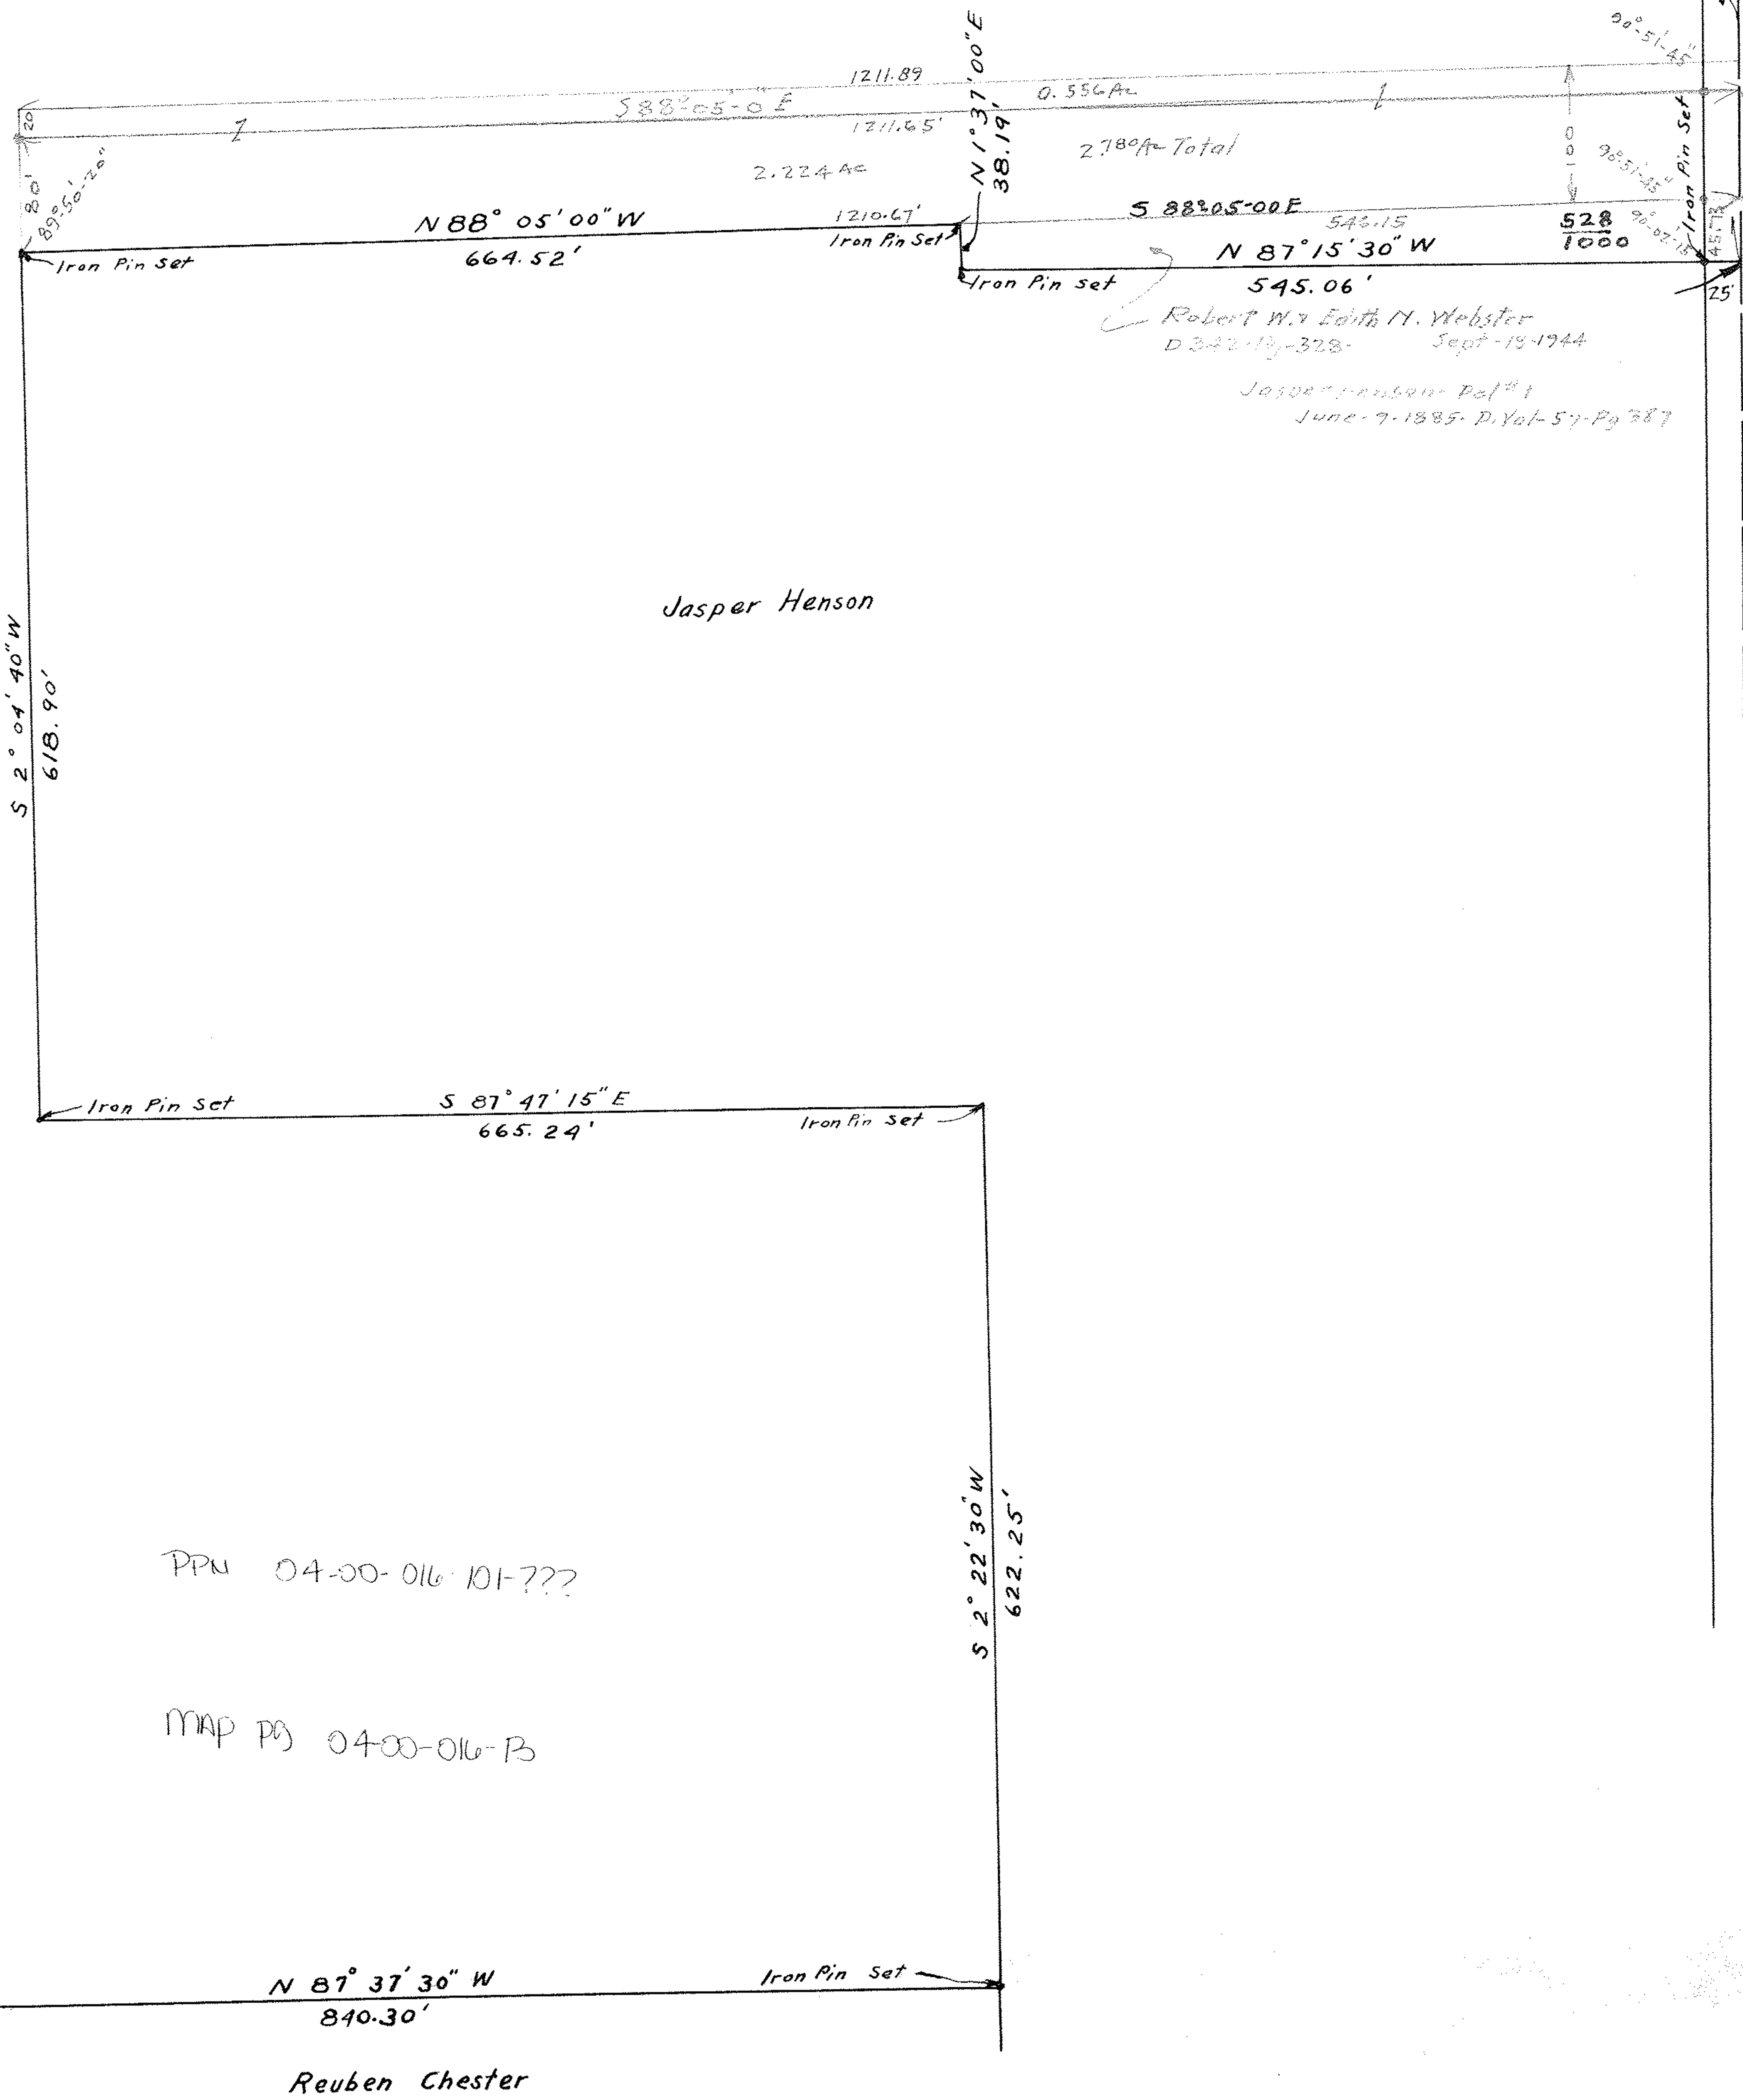

Robert W. Faith M. Webster
D 342-13-323- Sept-14-1944
Jasper Henson- Ref #1
June-7-1985. D. Vol-57-Pg 387

Elizabeth Linden

300474

SURVEY FOR
Edward Doller
Section 16 Avon Village
Lorain Co. Ohio

April 3, 1925 Scale 1" = 100ft.

Worden & Laundon

Civil Engineers
Elyria, Ohio.

Revised Nov 27 1945 J.W. Worden

590.65
S. Line N.Y.C. & St. L.
R.R.

Iron Pin Set

N E 20 00 2
1272.22'

Section Line

Iron Pin Set

Iron Pin Set

Iron Pin Set

Iron Pin Set

Iron Pin set

Iron Pin Set

Iron Pin Set

