


3

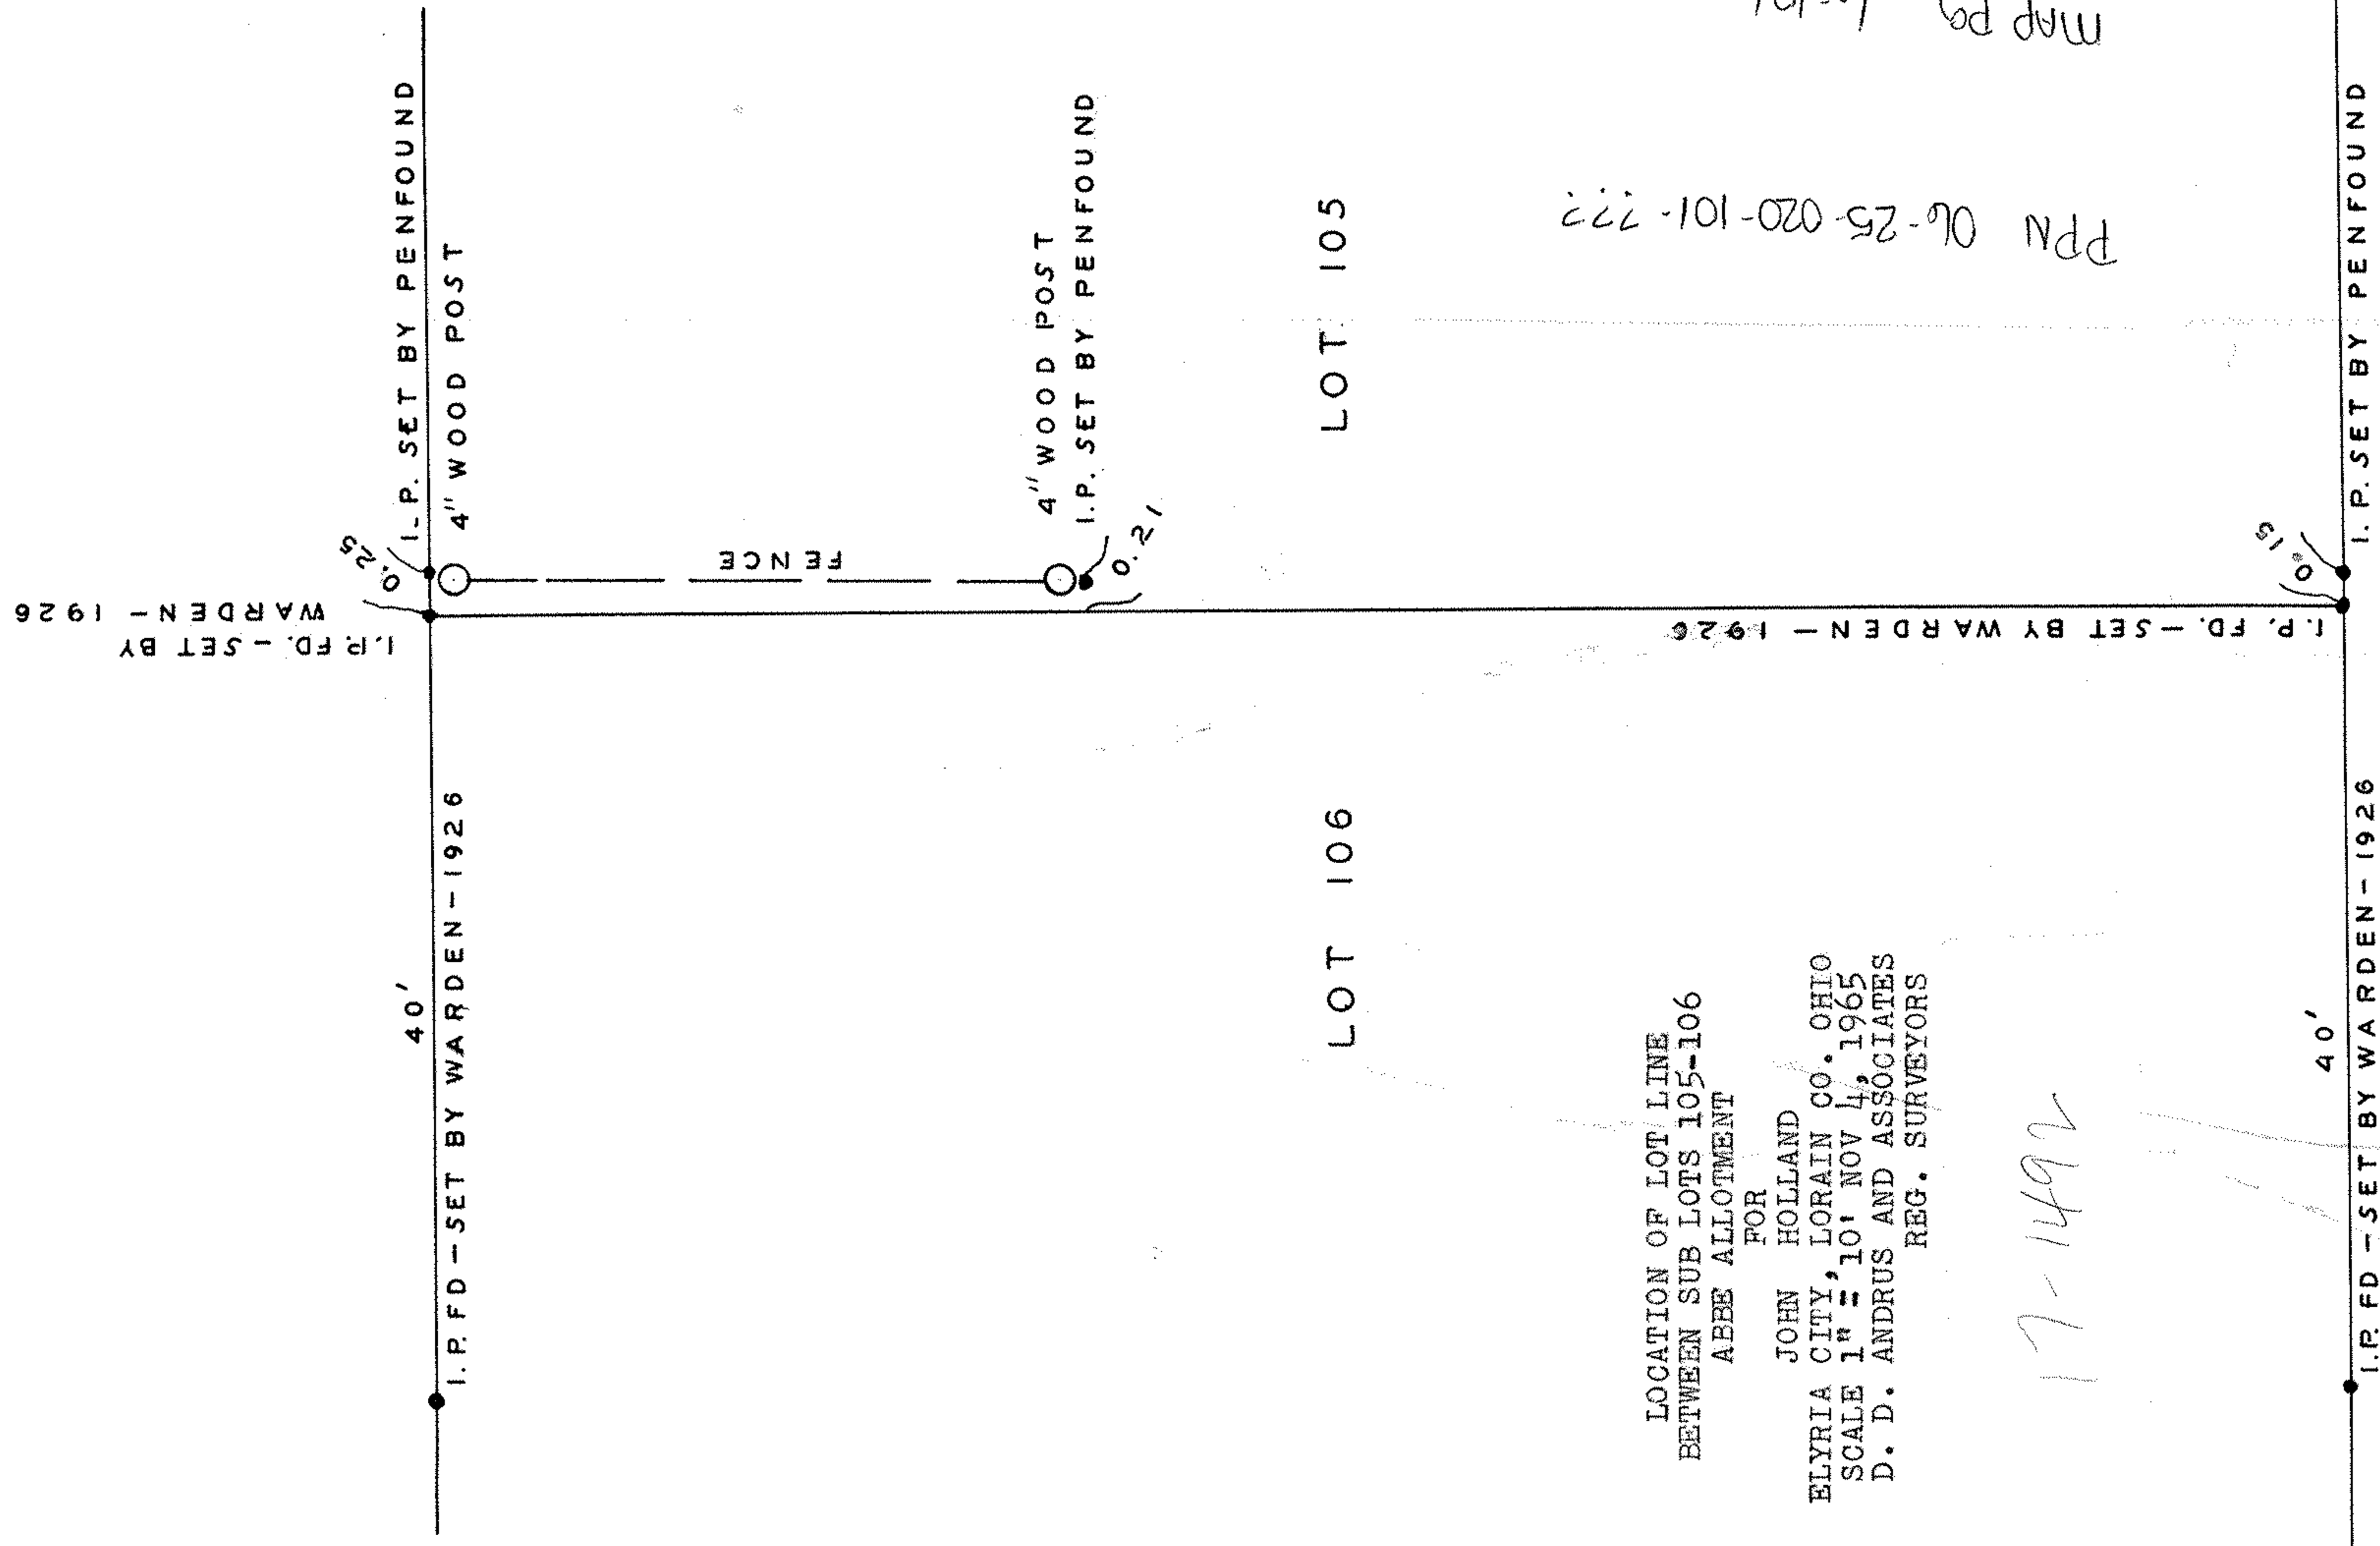

LOCATION OF LOT LINE  
 BETWEEN SUB LOTS 105-106  
 ABBE ALLOTMENT  
 FOR  
 JOHN HOLLAND  
 ELYRIA CITY, LORAIN CO., OHIO  
 SCALE 1" = 10' NOV 4, 1965  
 D. D. ANDRUS AND ASSOCIATES  
 REG. SURVEYORS

17-1492

PPN 06-25-020-101-???

MAP PG 6-106

17-1492

COURT

EADY

40'

40'

0.15

0.21

0.25

40'

LOT 106

LOT 105

FENCE

4" WOOD POST  
I.P. SET BY PENFOUND

I.P. SET BY PENFOUND  
4" WOOD POST

I.P. FD. - SET BY  
WARDEN - 1926

I.P. FD - SET BY WARDEN - 1926

I.P. FD. - SET BY WARDEN - 1926

I.P. FD - SET BY WARDEN - 1926

I.P. SET BY PENFOUND