

JOHN W. WARDEN

CIVIL ENGINEER AND SURVEYOR

405 ELYRIA BLOCK

ELYRIA, OHIO

STATE OF OHIO

REGISTERED } PROFESSIONAL ENG.
SURVEYOR

PHONES

BUSINESS 3211


RESIDENCE 38633

17-1024

Survey for
HENRY JORGENSEN
Lot 40 West of Black River
Elyria Township - Lorain County Ohio
Scale 1"=80' Aug. 12, 1948.

PPN 06-29-040-101-???

MAP PG 6-41

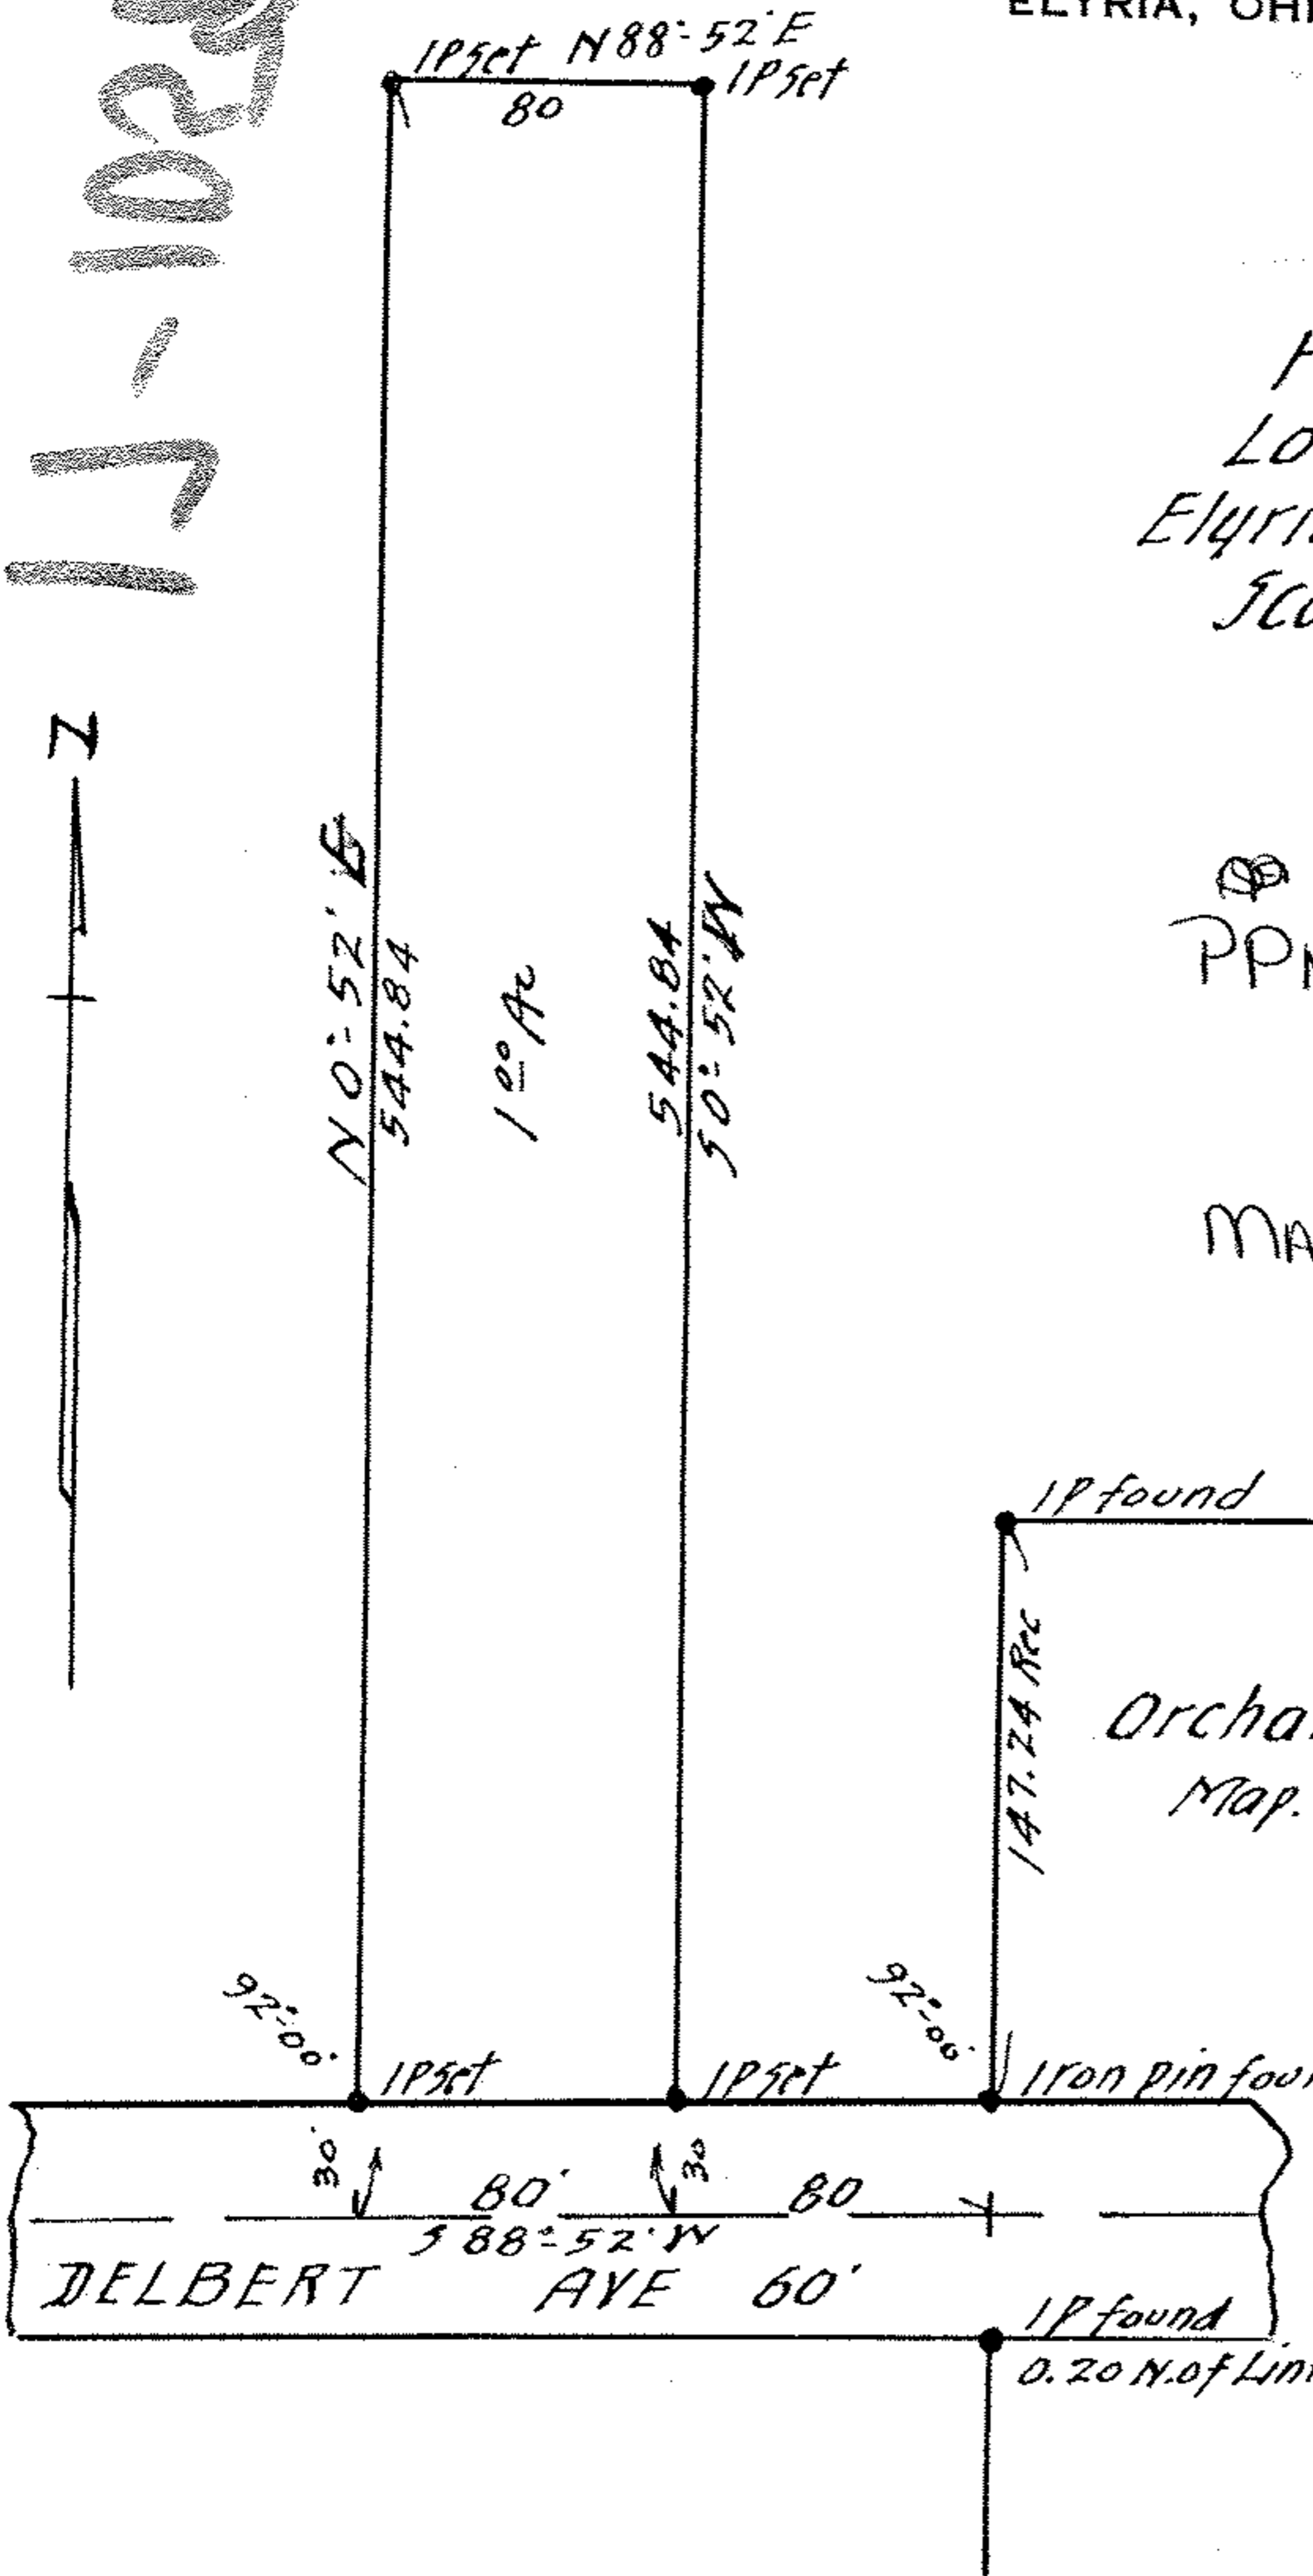

Orchard Grove Allt.
Map. Vol. 6 Pg. 43

Iron pin found 2.0' West of Line
and 0.40' South of Line

17-1059-2