

MAP OF SURVEY MADE FOR

Willie Hecock


Original Lot 112 Sheffield Trwp.

County, Ohio

Distances are given in feet and decimal parts

Scale, 1 in. 40 Feet
Elyria, O.,
Order No.,
F. B. Pg.,

London, C. E.
A BLOCK
24

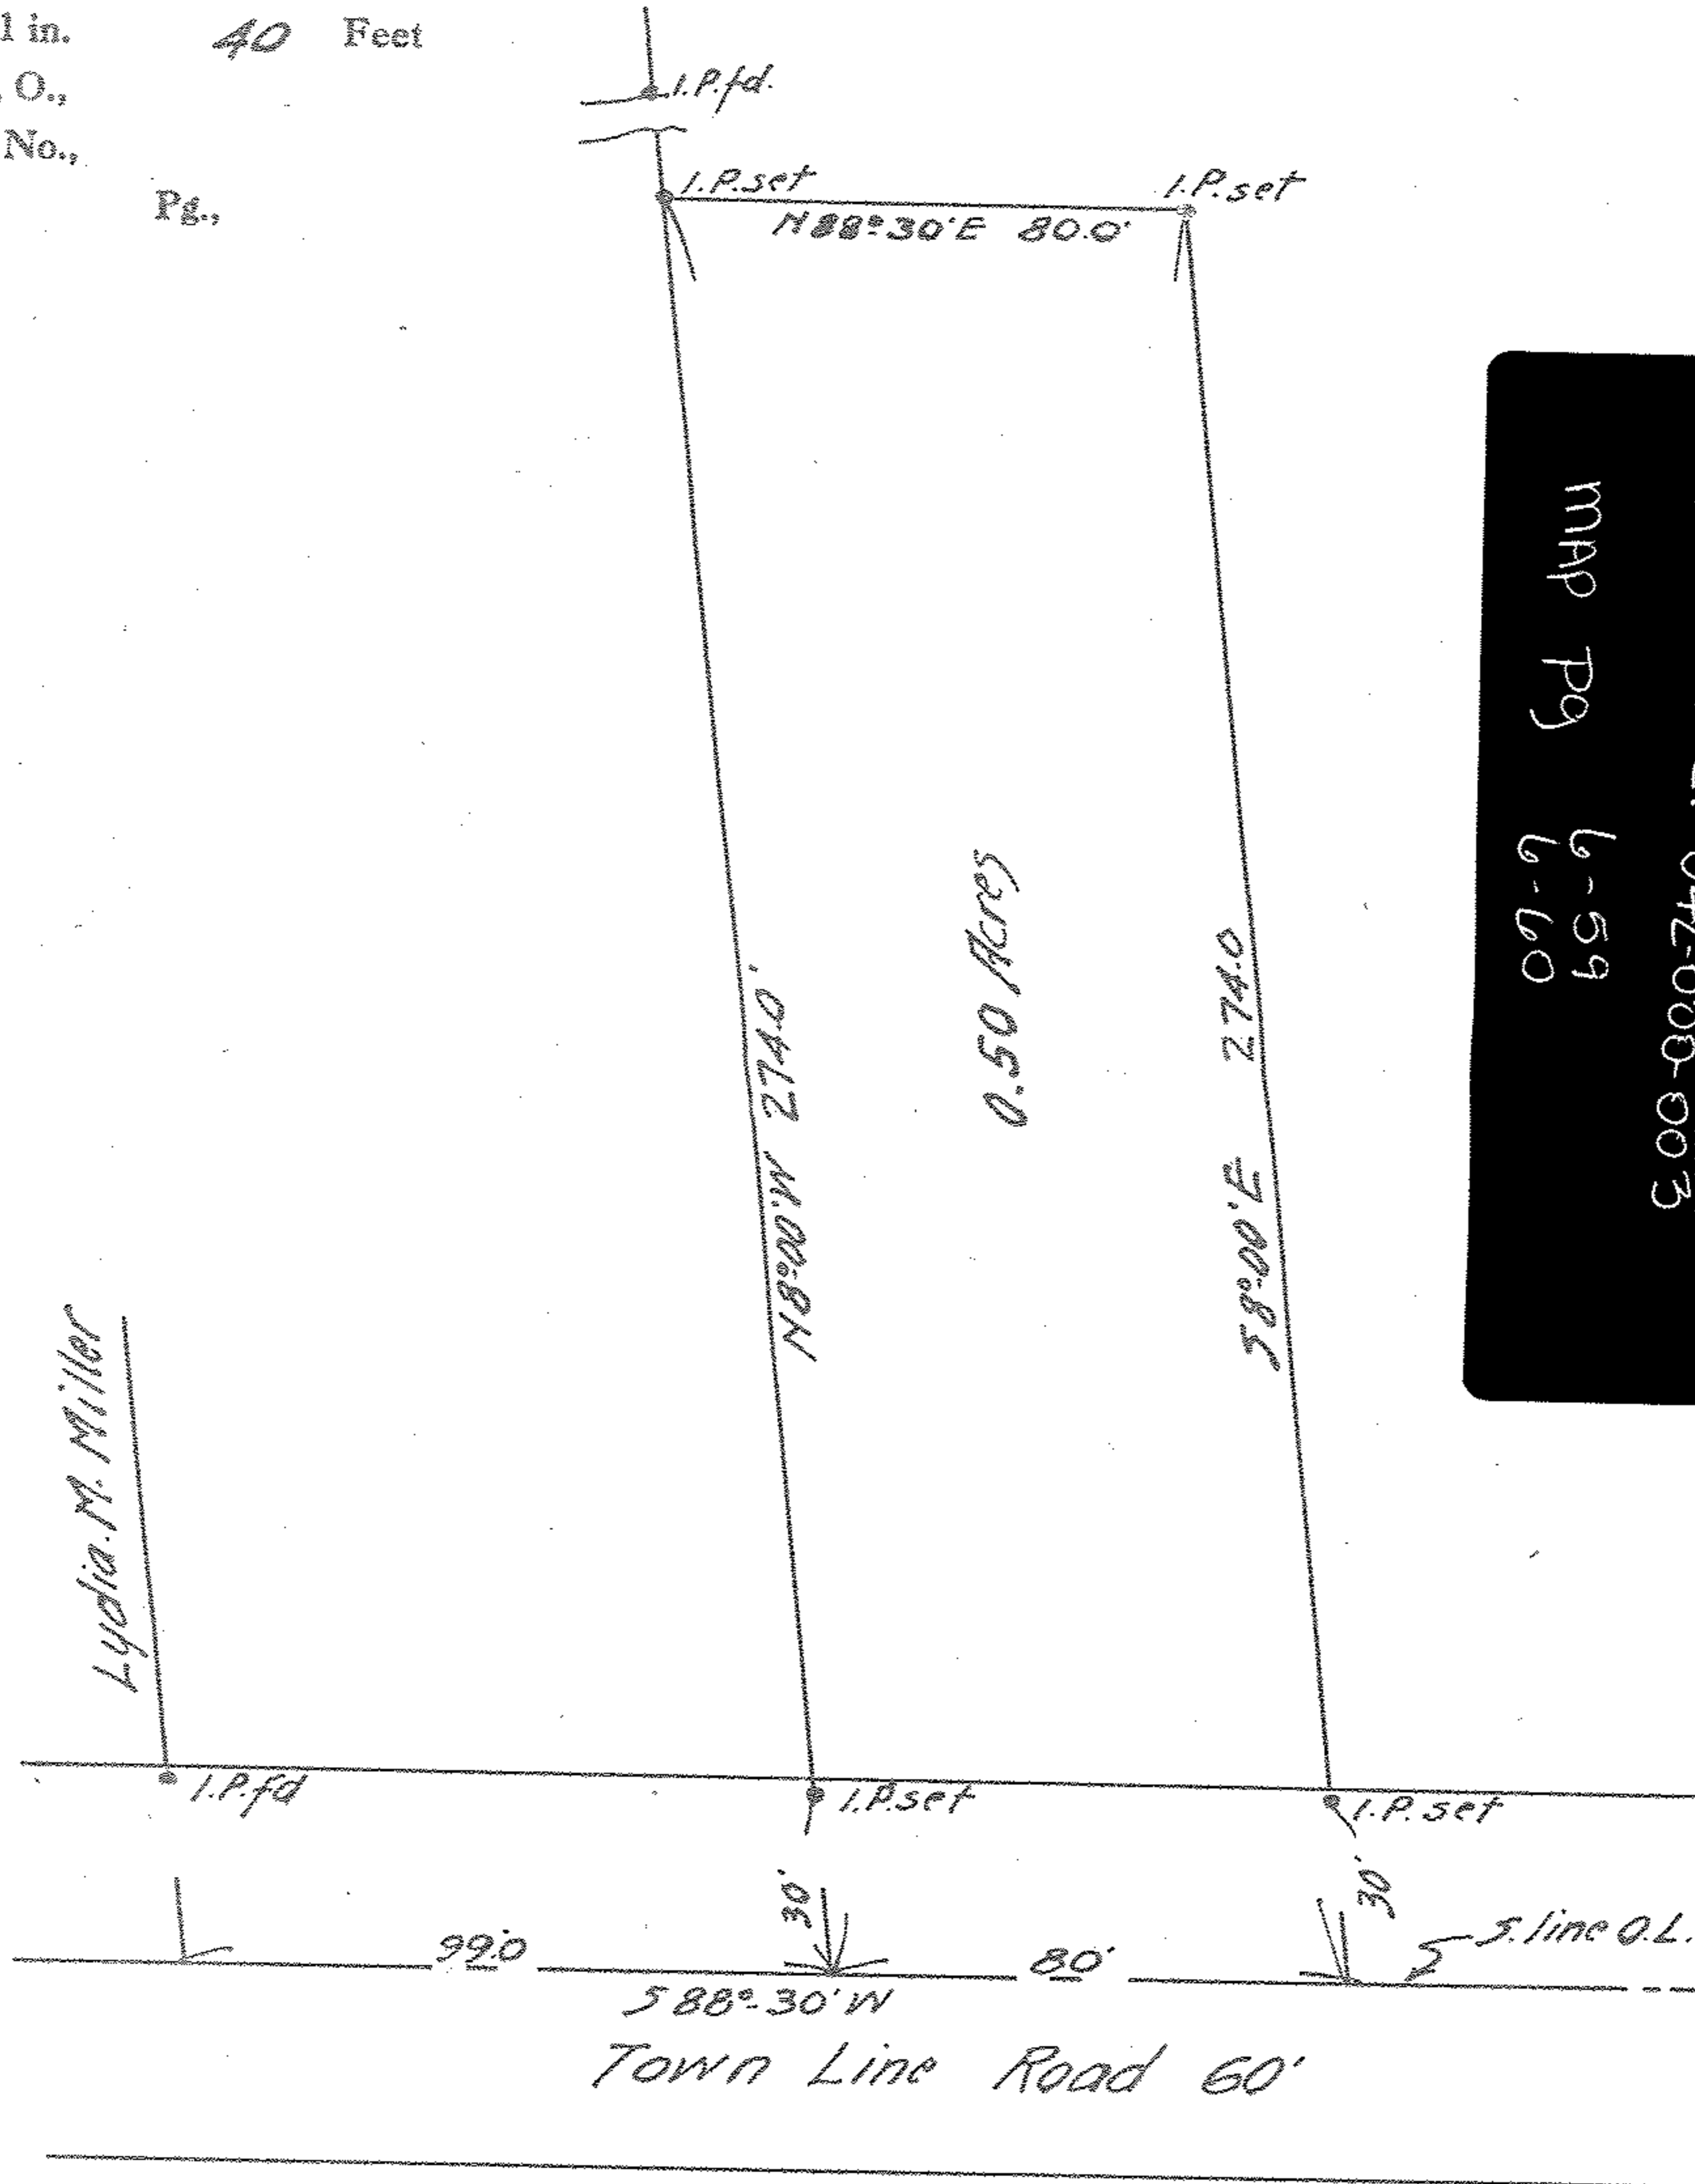

MAP Pg 6-59
6-60
000-000-003