


Survey of  
O. J. Rockwood Farm.  
 Lots 141-160.      Pittsfield Twp.,  
 Lorain Co.,      Ohio.

Aug. 6-1921.      Scale 1 inch = 300 feet.

Wardens & Saunders  
Surveyors.

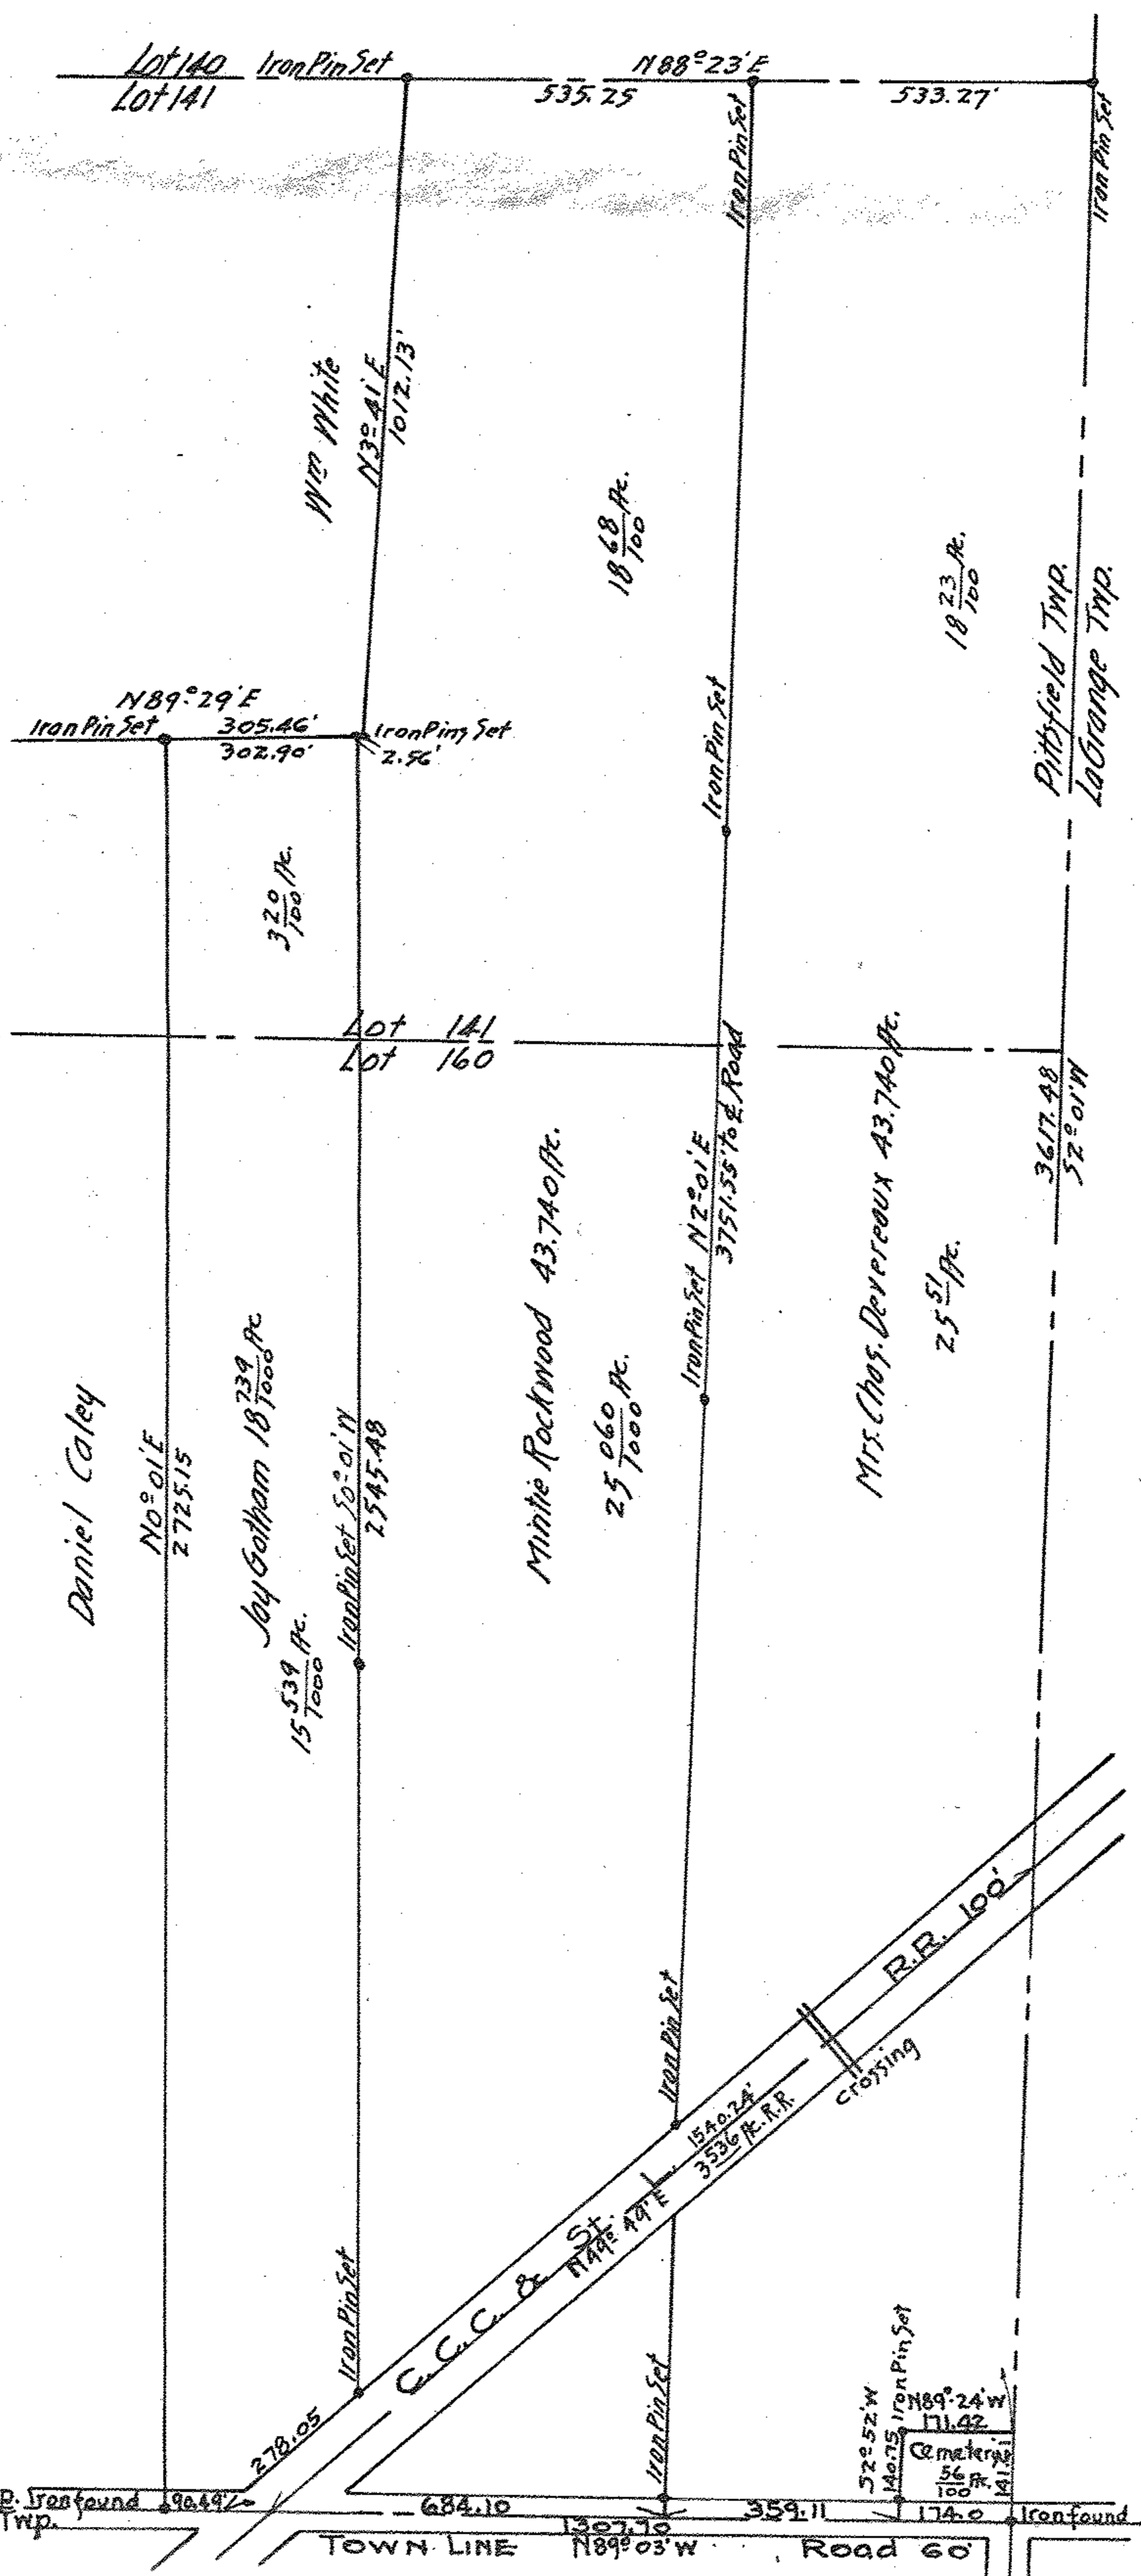

Pittsfield Twp. Iron found 90.49' Wellington Twp.