


Matt & Ursula Zieherl
 D-Vol. 331-Pg. 330 Oct. 16, 1943.

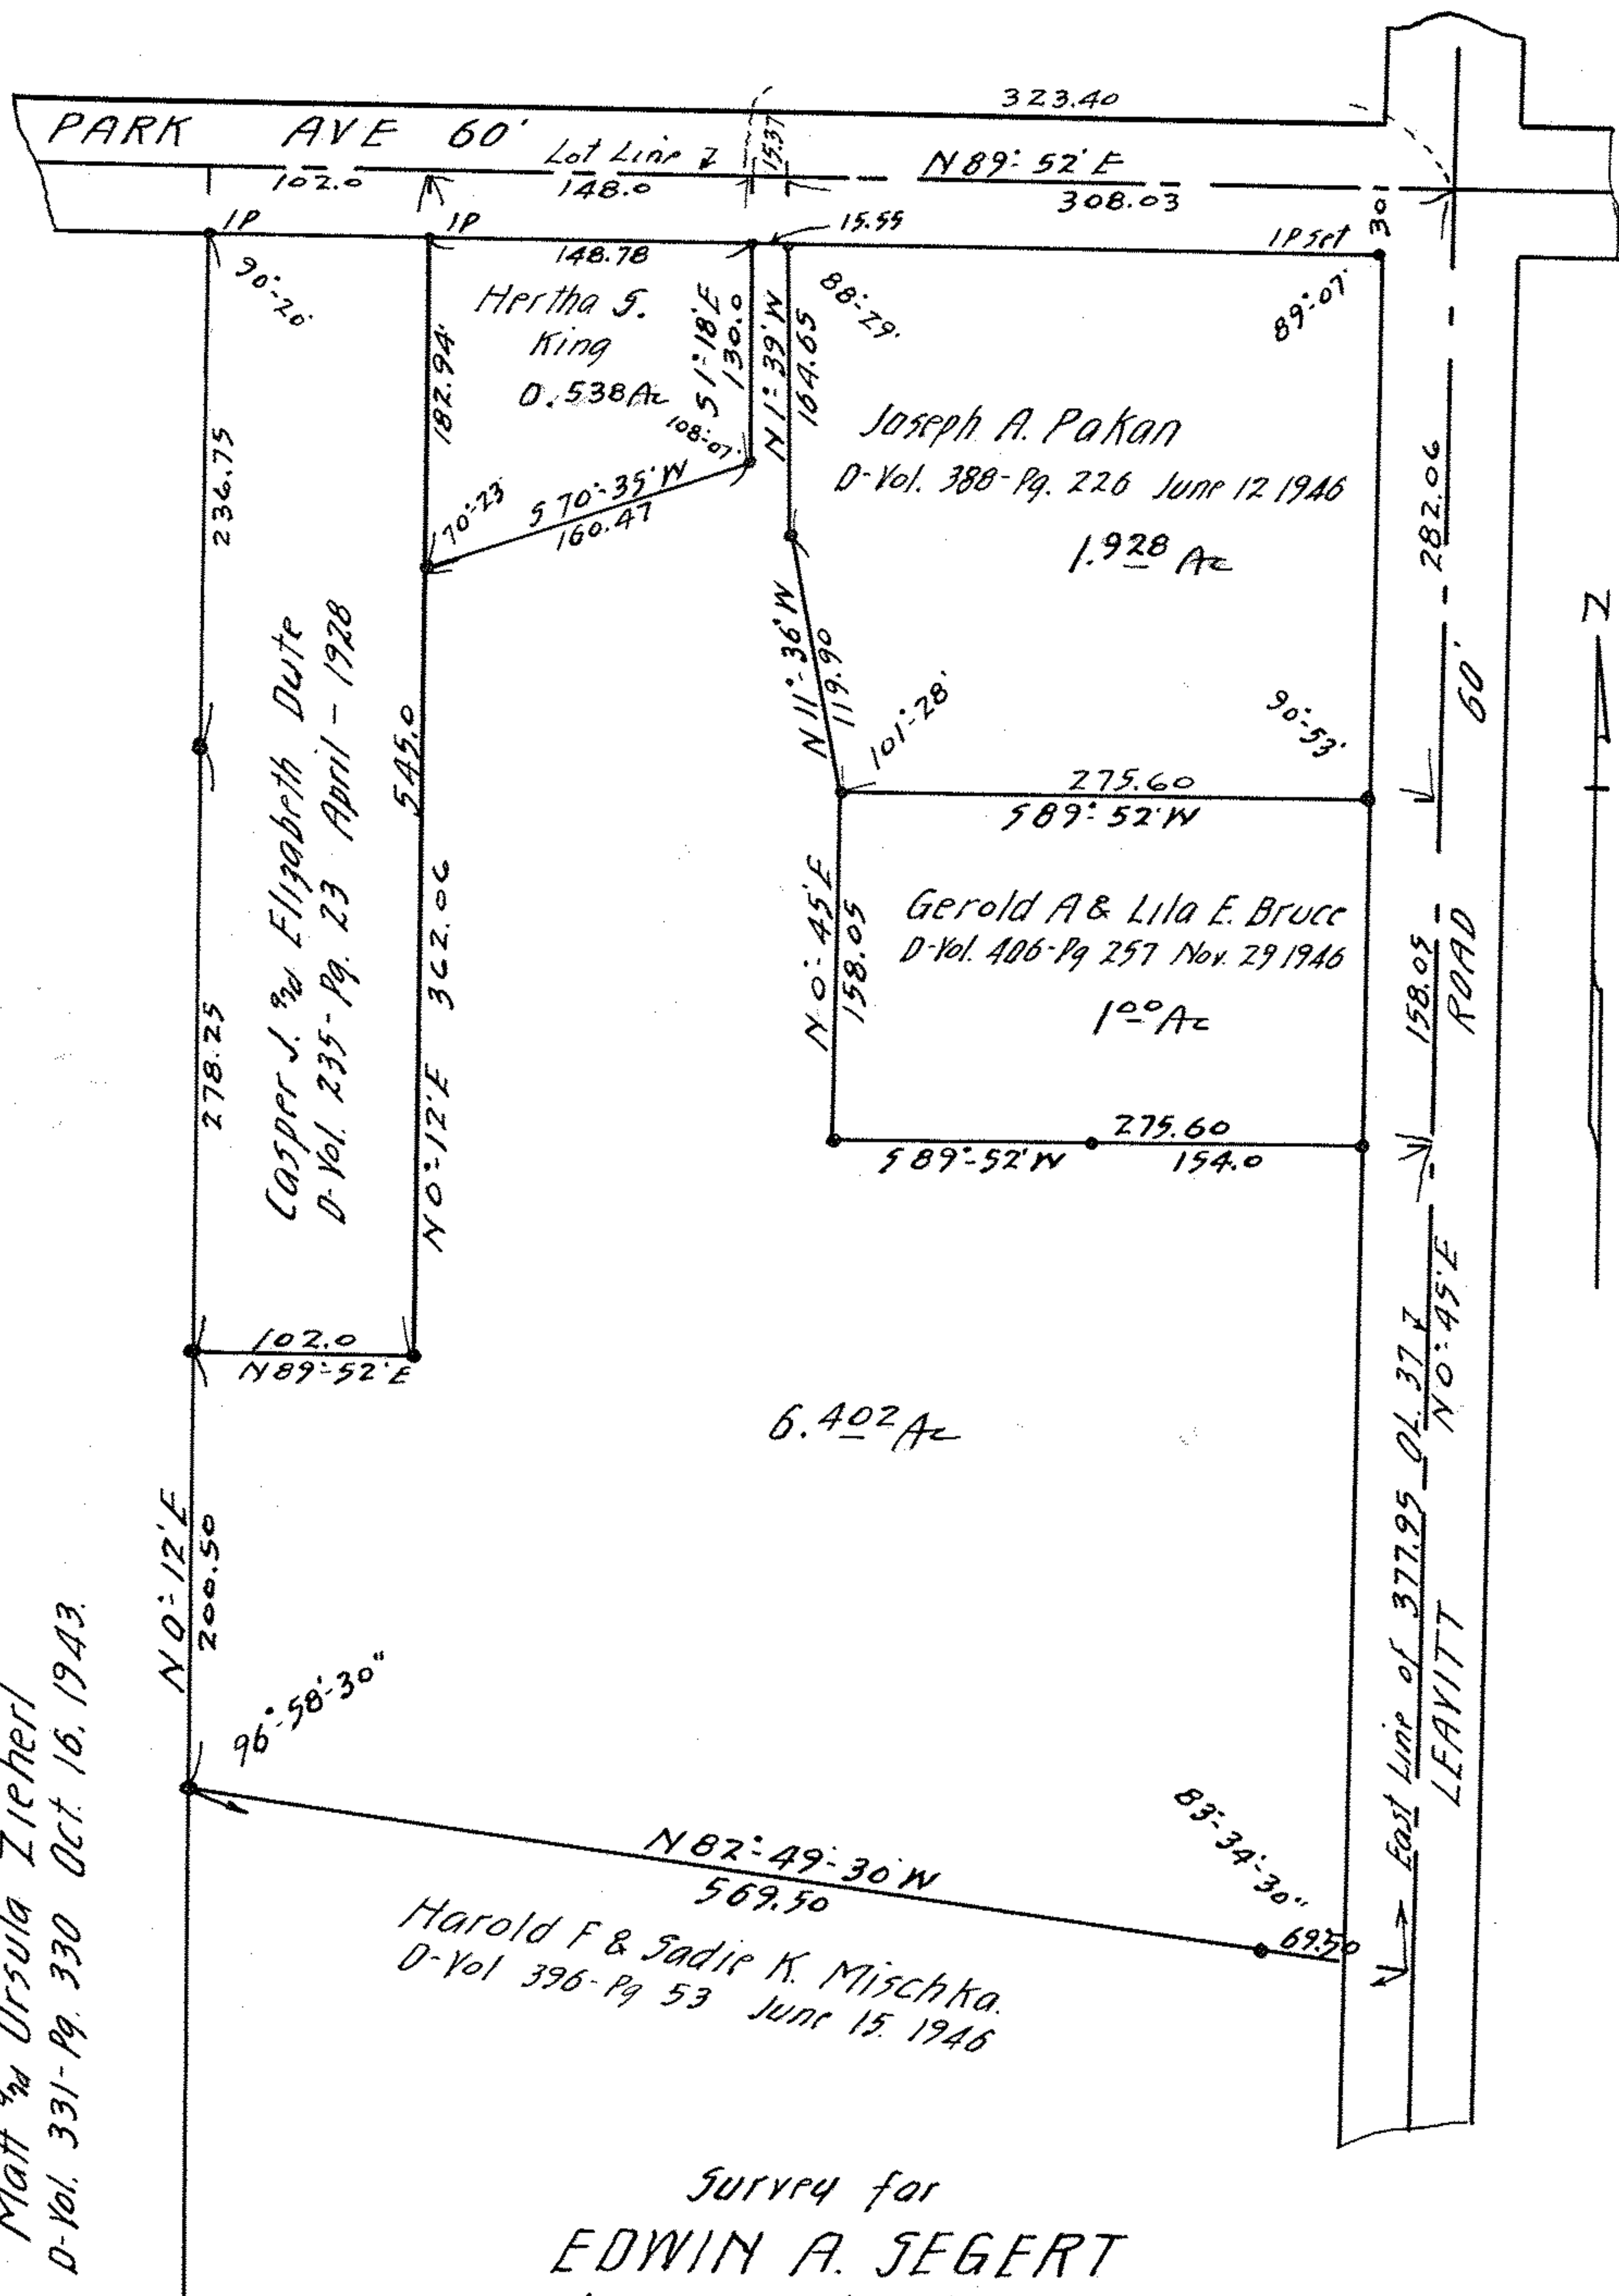

Survey for
EDWIN A. SEGERT
 Lot 37 Amherst Township
 Lorain County Ohio
 Scale 1" = 100' May 16, 1947
 J. W. Warden, Registered Surveyor.

22-0000-3