


Survey for Elizabeth Gerhart
Section 24. Avon Village, Lorain Co. Ohio.

Scale 1"=200' Nov, 21, 1921.

Warden & Laundon
Engineers

John Webber

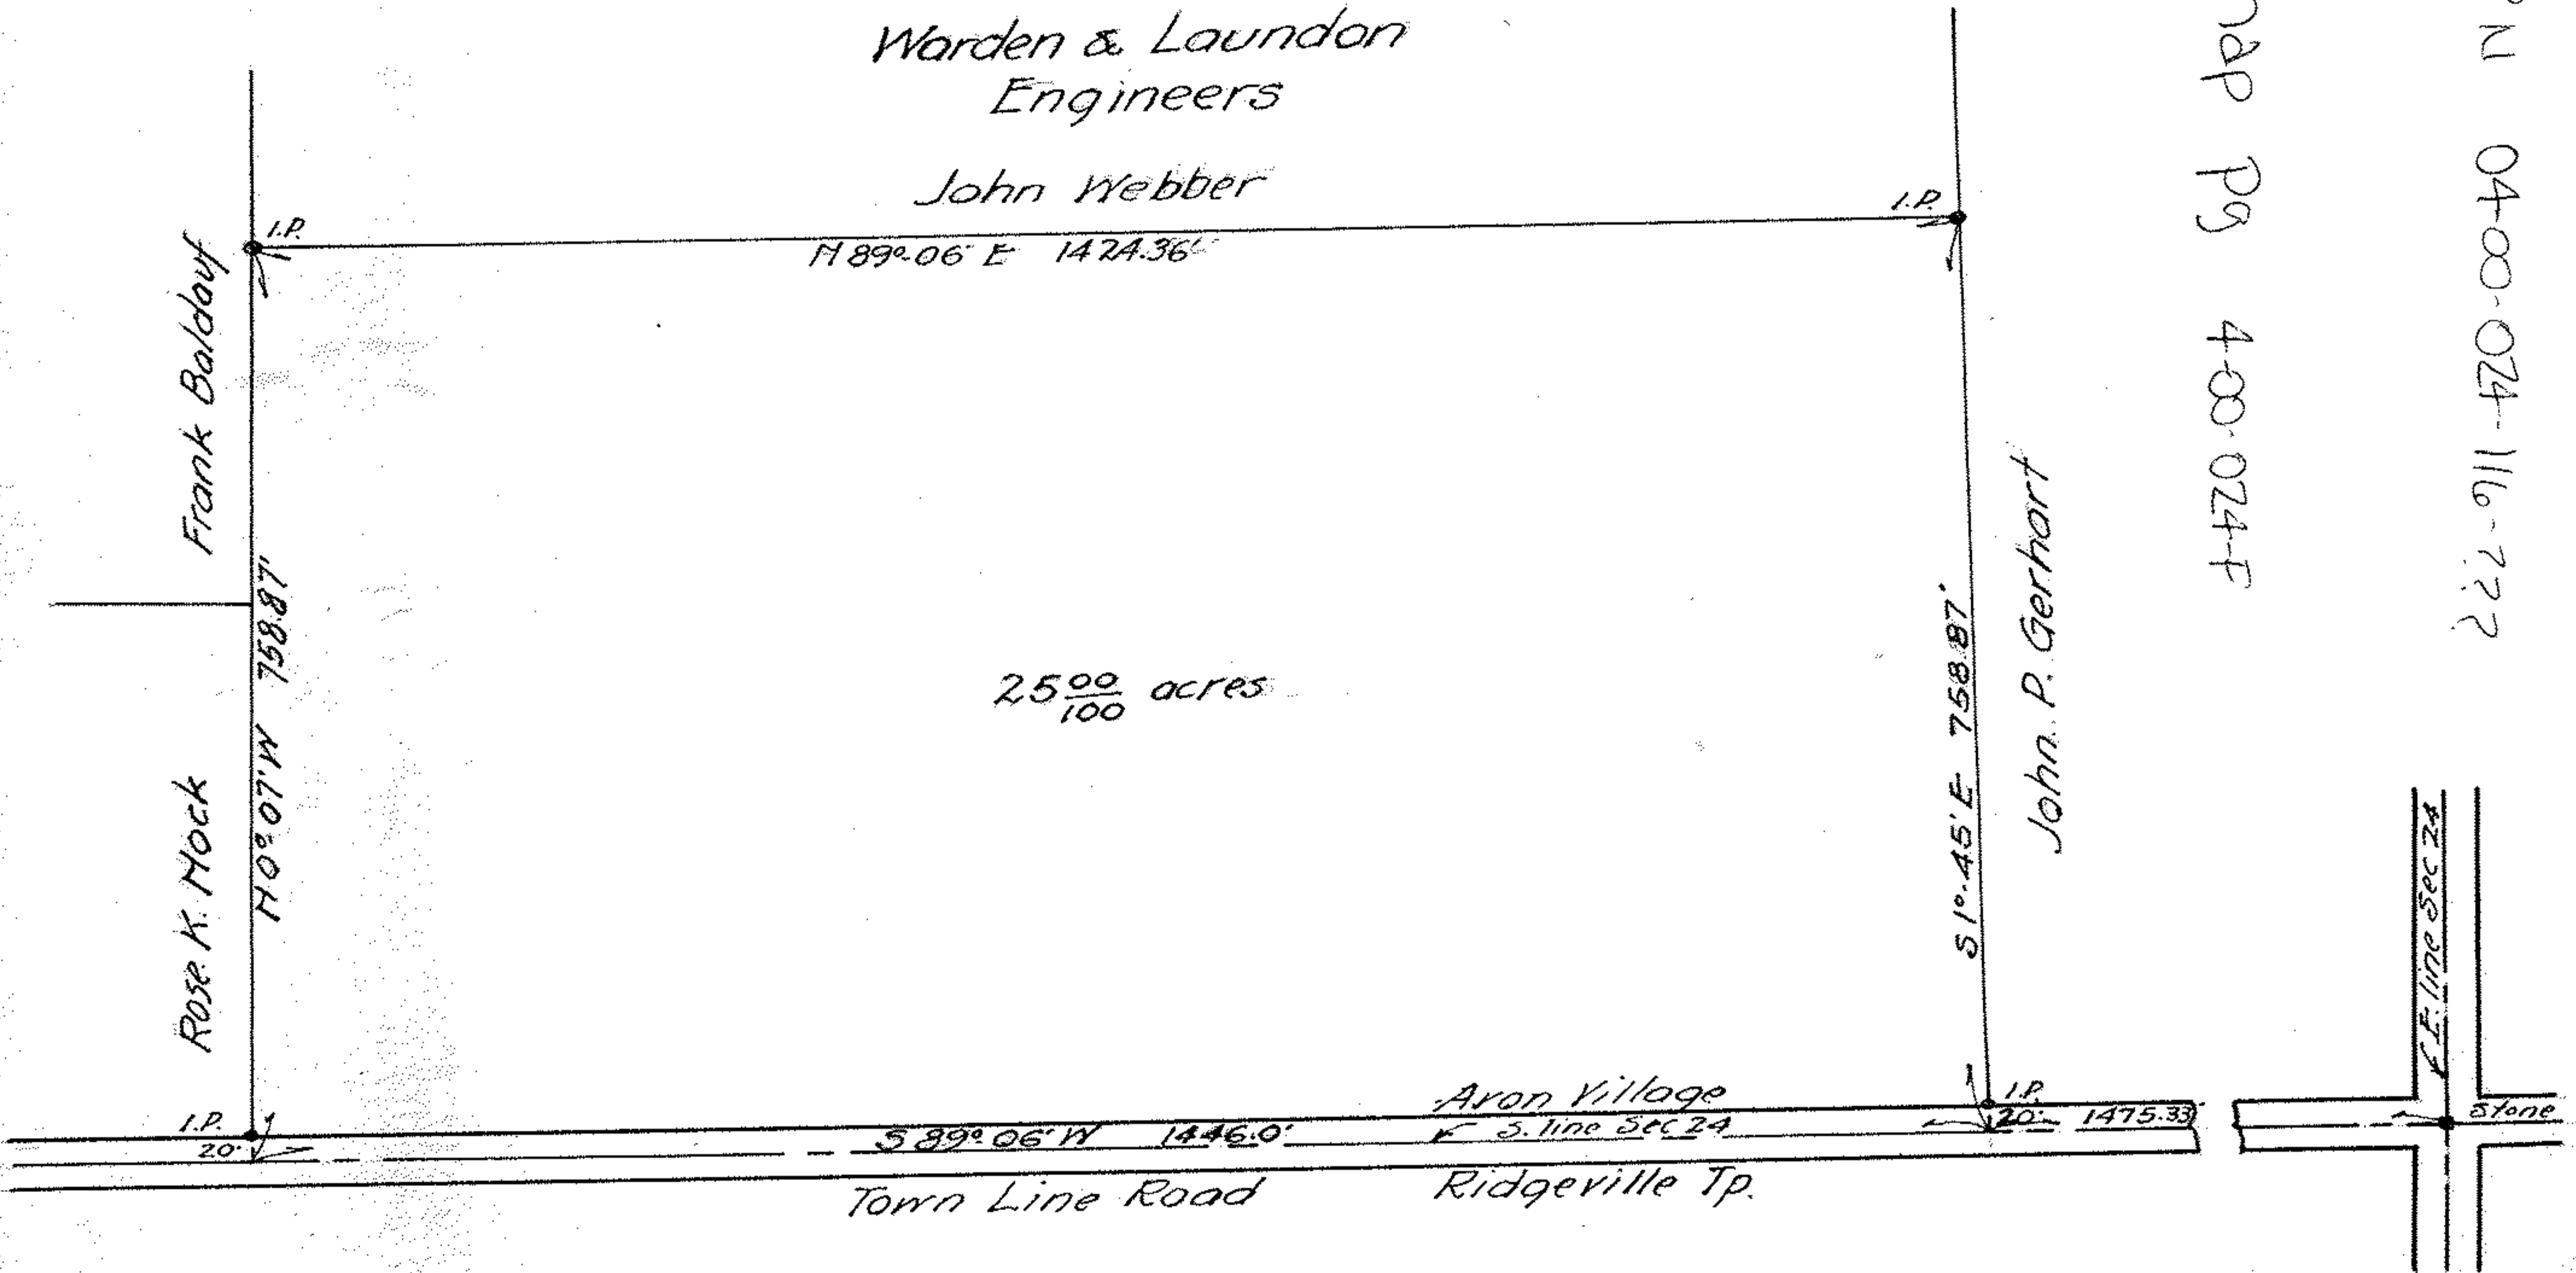

MAP P9 4-00-024-F

PPN 04-00-024-116-???

24-13
13-52

400437 A