

# J. W. WARDEN & ASSOCIATES


CIVIL ENGINEERS AND SURVEYORS

D. D. ANDRUS, PRESIDENT  
405 ELYRIA BLOCK  
ELYRIA, OHIO

TELEPHONES 3211  
42871

M. W. JACKSON  
SECRETARY

STATE OF OHIO  
REGISTERED } PROFESSIONAL ENG.  
SURVEYOR

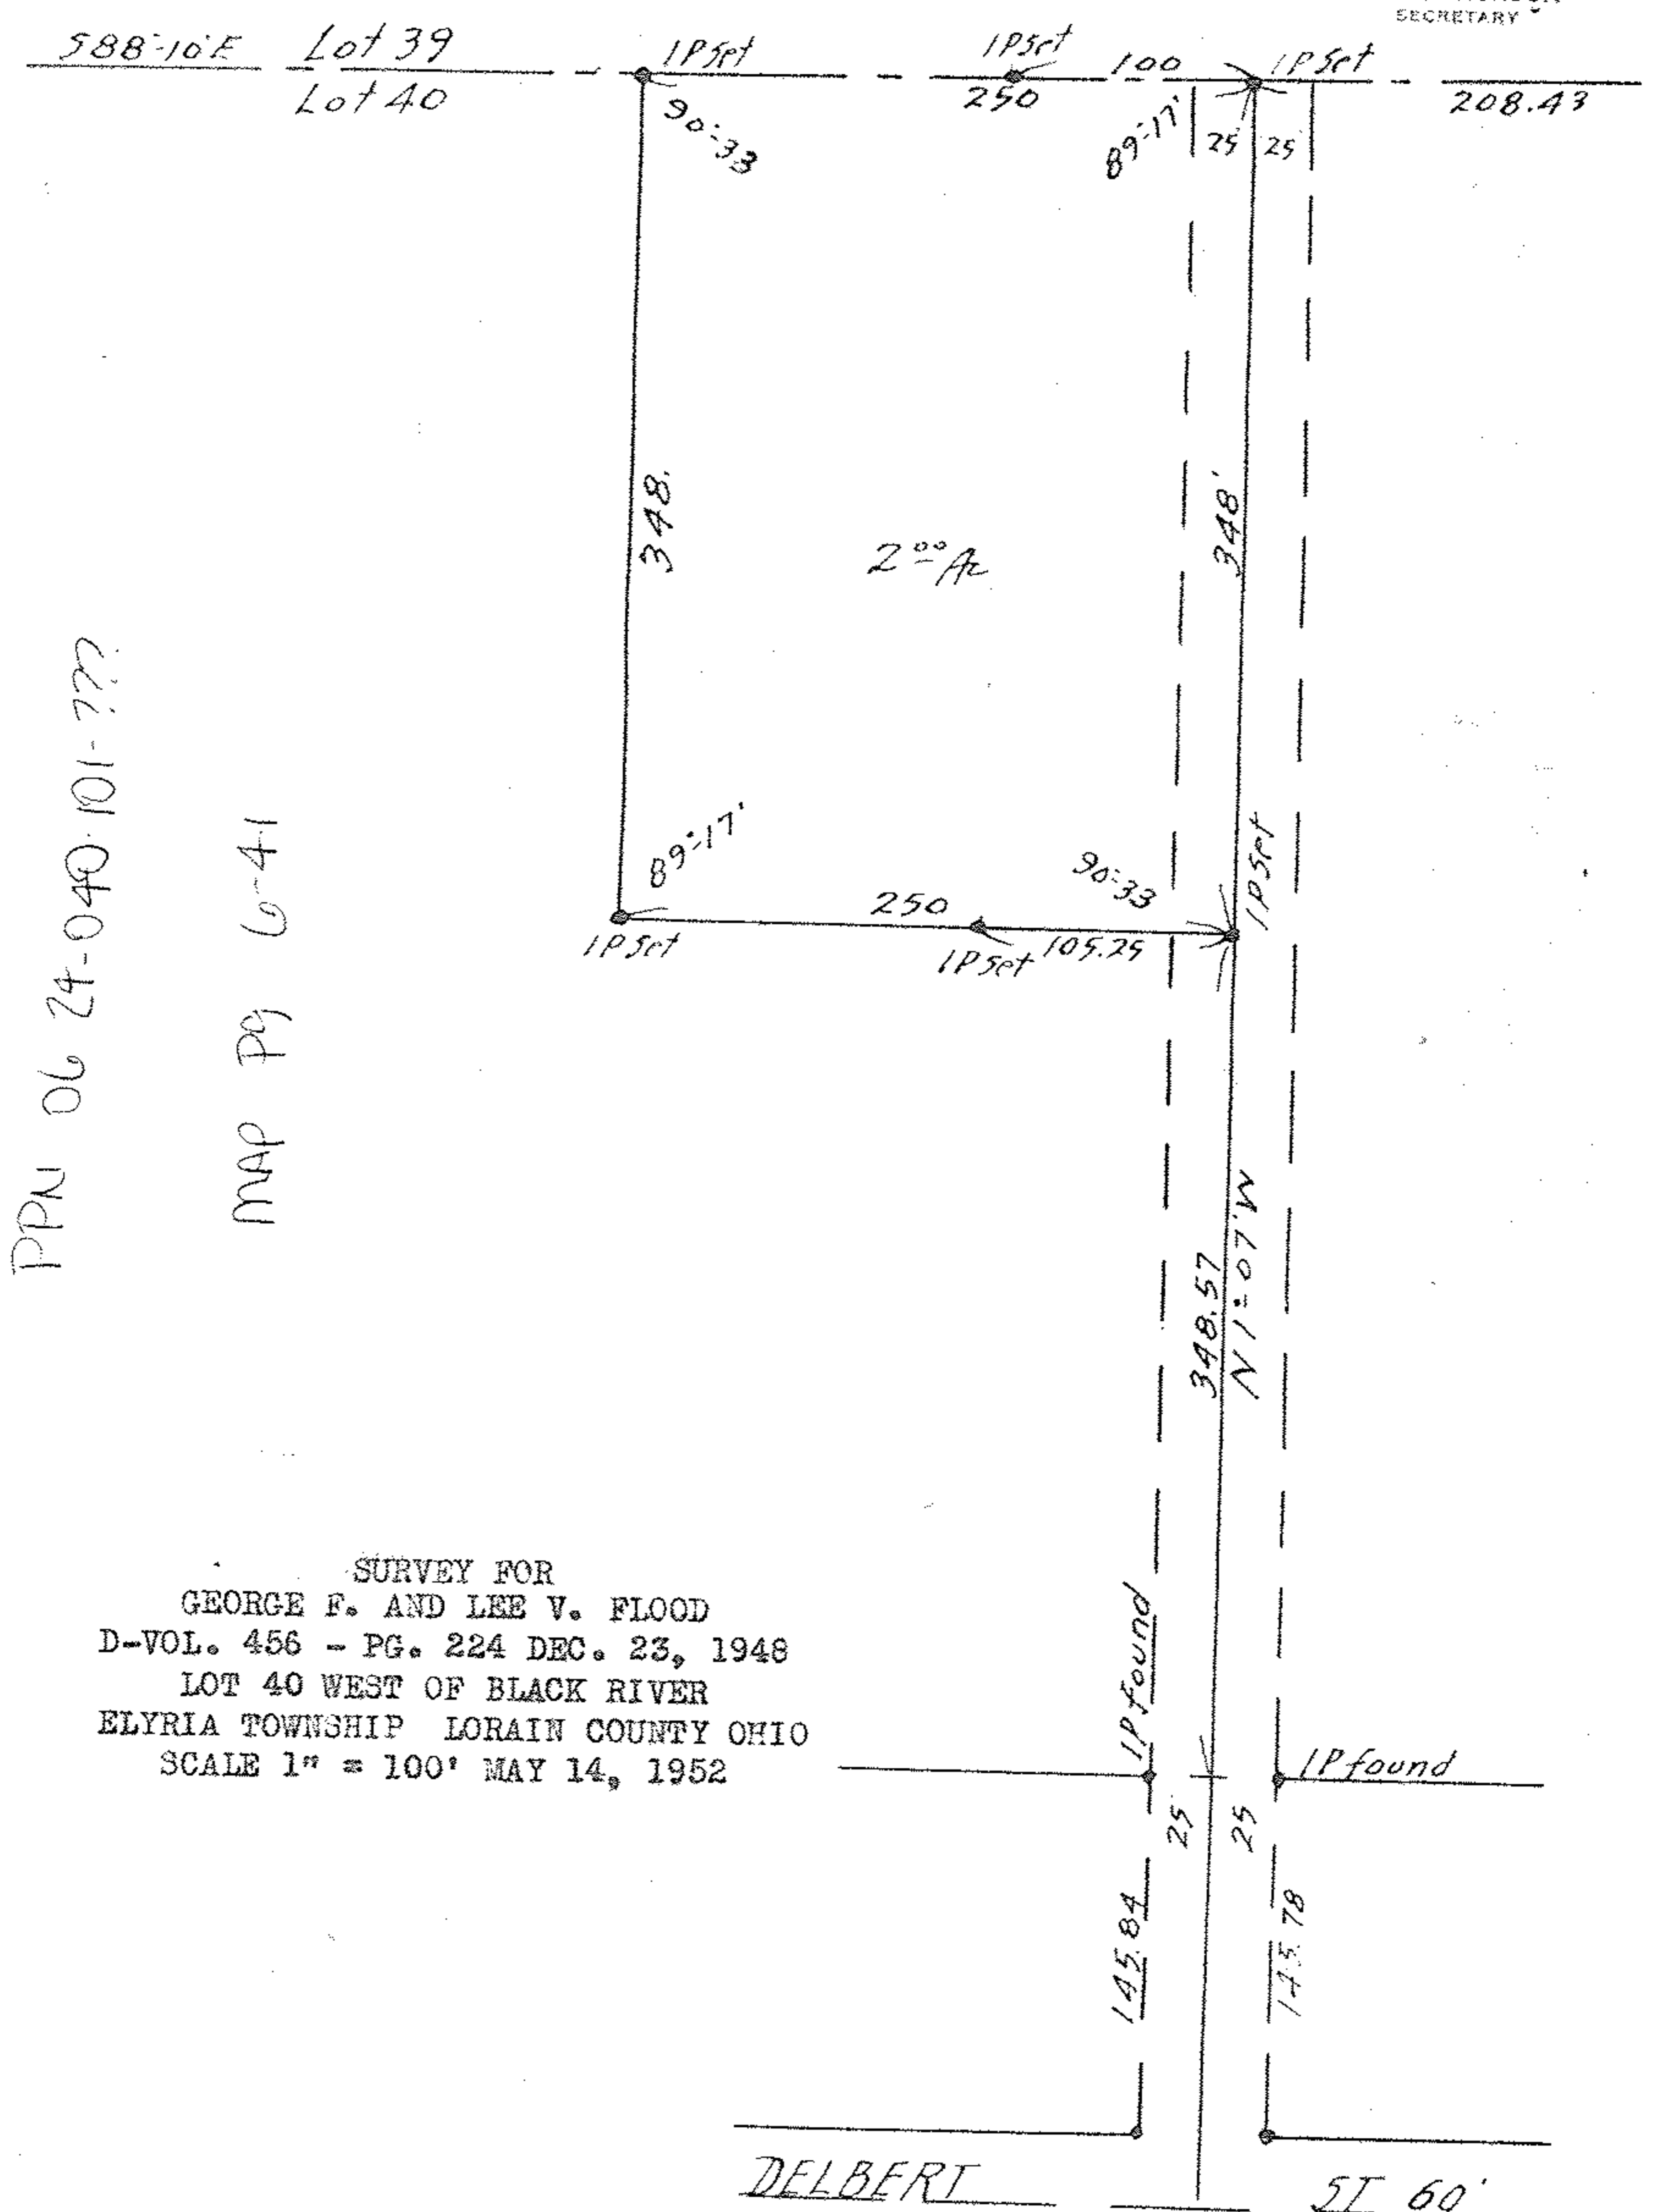

PPN 06 24-040-101-777

MAP PG 6-41

SURVEY FOR  
GEORGE F. AND LEE V. FLOOD  
D-VOL. 456 - PG. 224 DEC. 23, 1948  
LOT 40 WEST OF BLACK RIVER  
ELYRIA TOWNSHIP LORAIN COUNTY OHIO  
SCALE 1" = 100' MAY 14, 1952