

# J. W. WARDEN & ASSOCIATES

CIVIL ENGINEERS AND SURVEYORS

D. D. ANDRUS, PRESIDENT  
405 ELYRIA BLOCK  
ELYRIA, OHIO


TELEPHONES 3211  
42871

M. W. JACKSON  
SECRETARY

STATE OF OHIO  
REGISTERED } PROFESSIONAL ENG.  
SURVEYOR

MAP PG 04-00-030-F

PPN 04-00-030-141-016

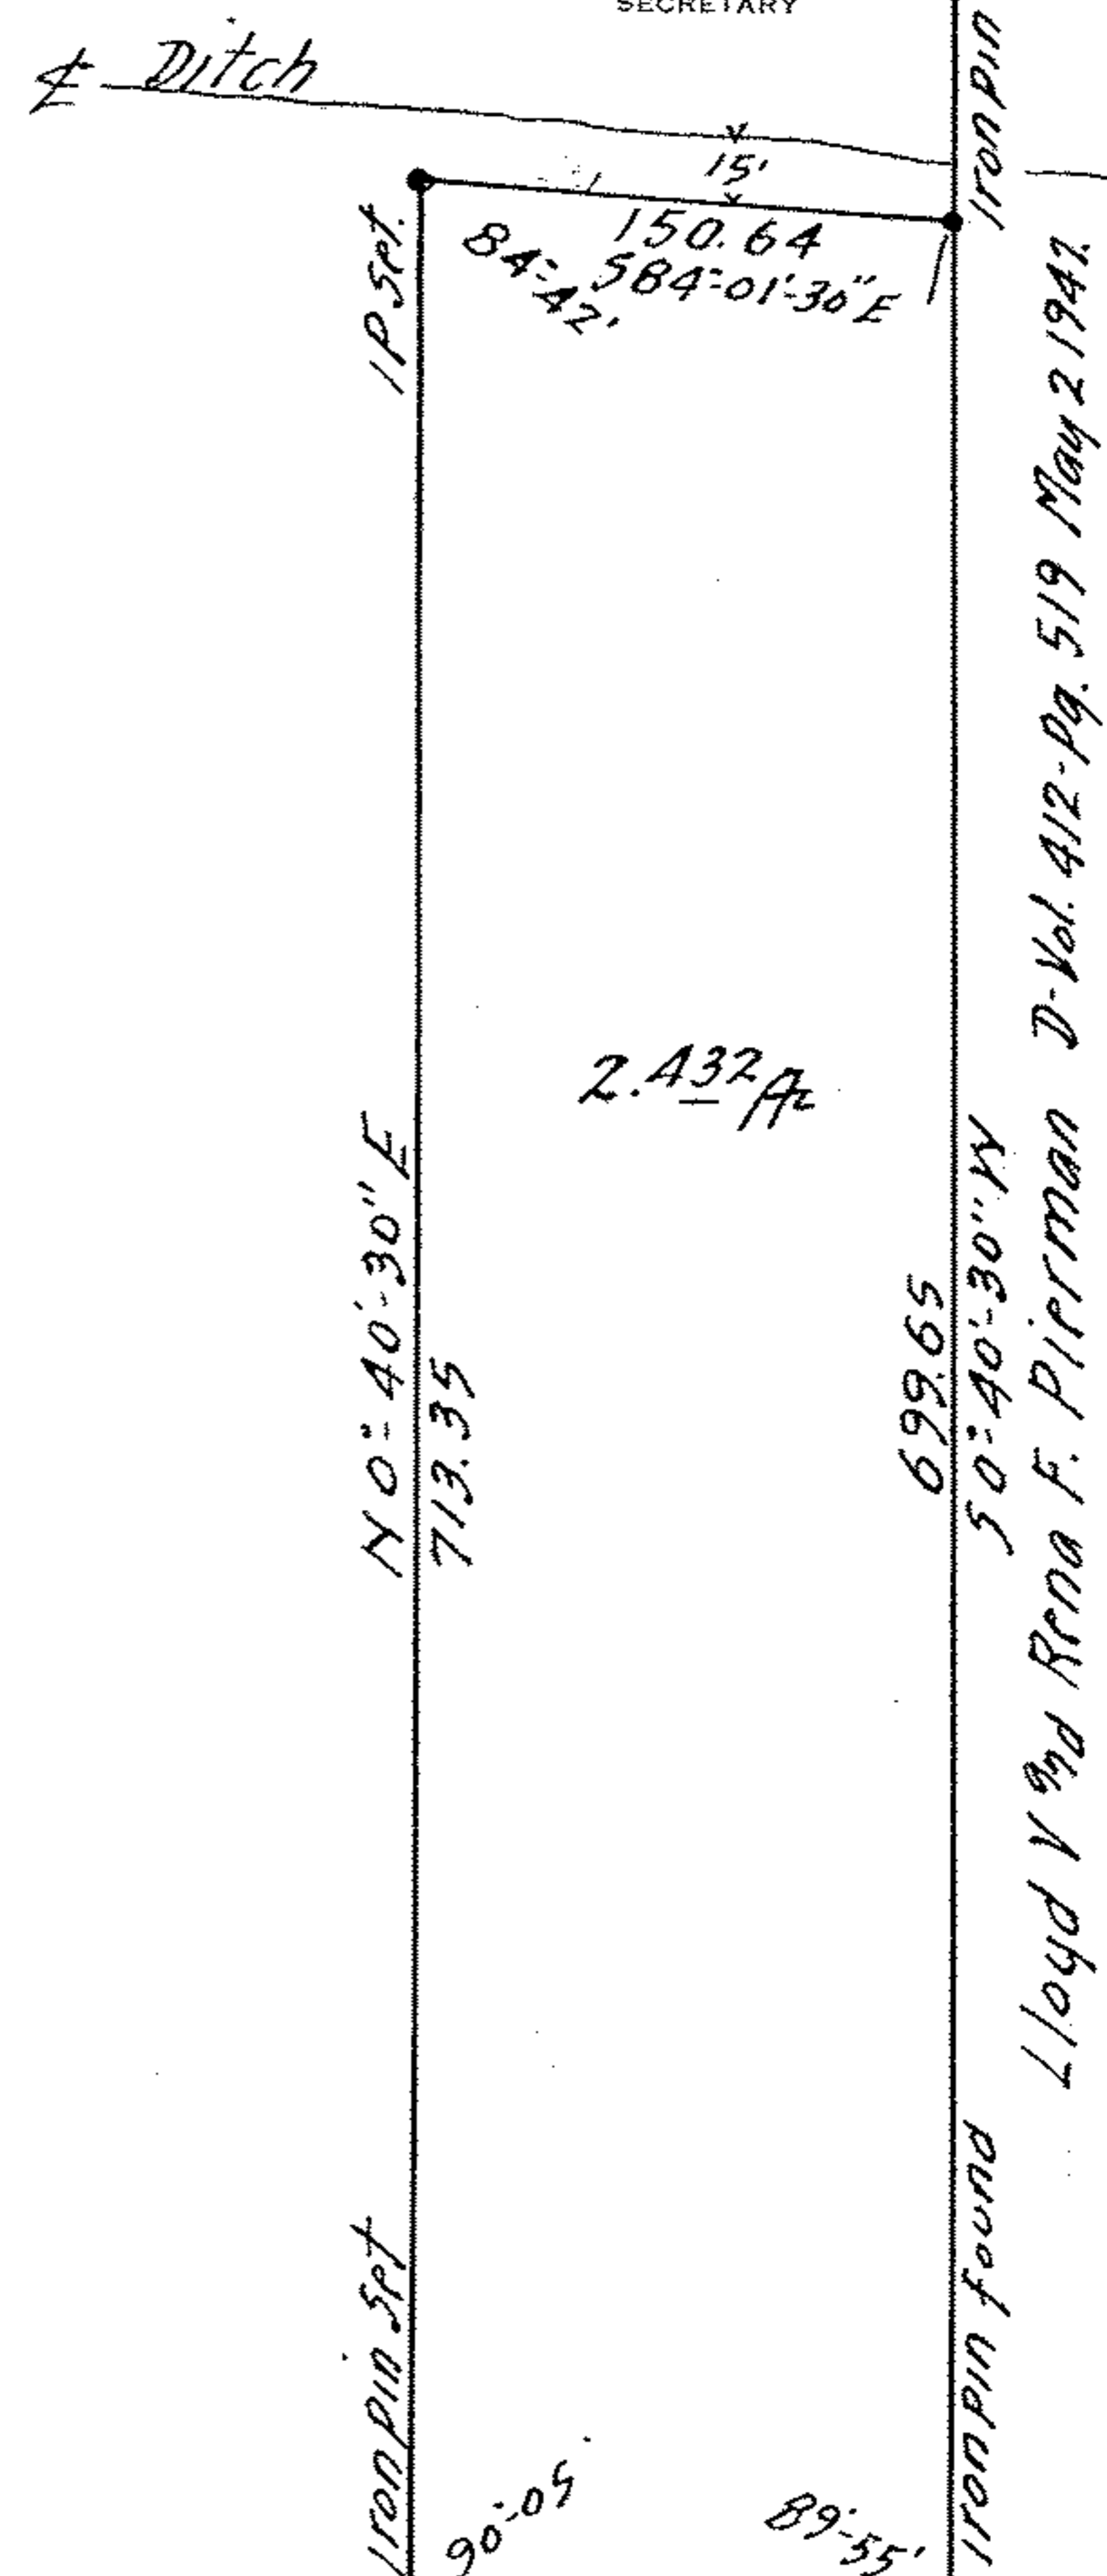

SURVEY FOR  
ANTONIE KVAC ESTATE  
D-VOL. 275 PG. 349 MAY 18, 1935  
SECTION 30 AVON LAKE VILLAGE  
LORAIN COUNTY, OHIO  
SCALE 1" = 100' JUNE 17, 1952

701214 B