

JOHN W. WARDEN

CIVIL ENGINEER AND SURVEYOR

405 ELYRIA BLOCK

ELYRIA, OHIO

STATE OF OHIO


REGISTERED } PROFESSIONAL ENG.
SURVEYOR

PHONES

BUSINESS 3211

RESIDENCE 38633

*Fred & Augusta Peck
D-Vol. 323 -Pg. 84-Aug. 20, 1942.*

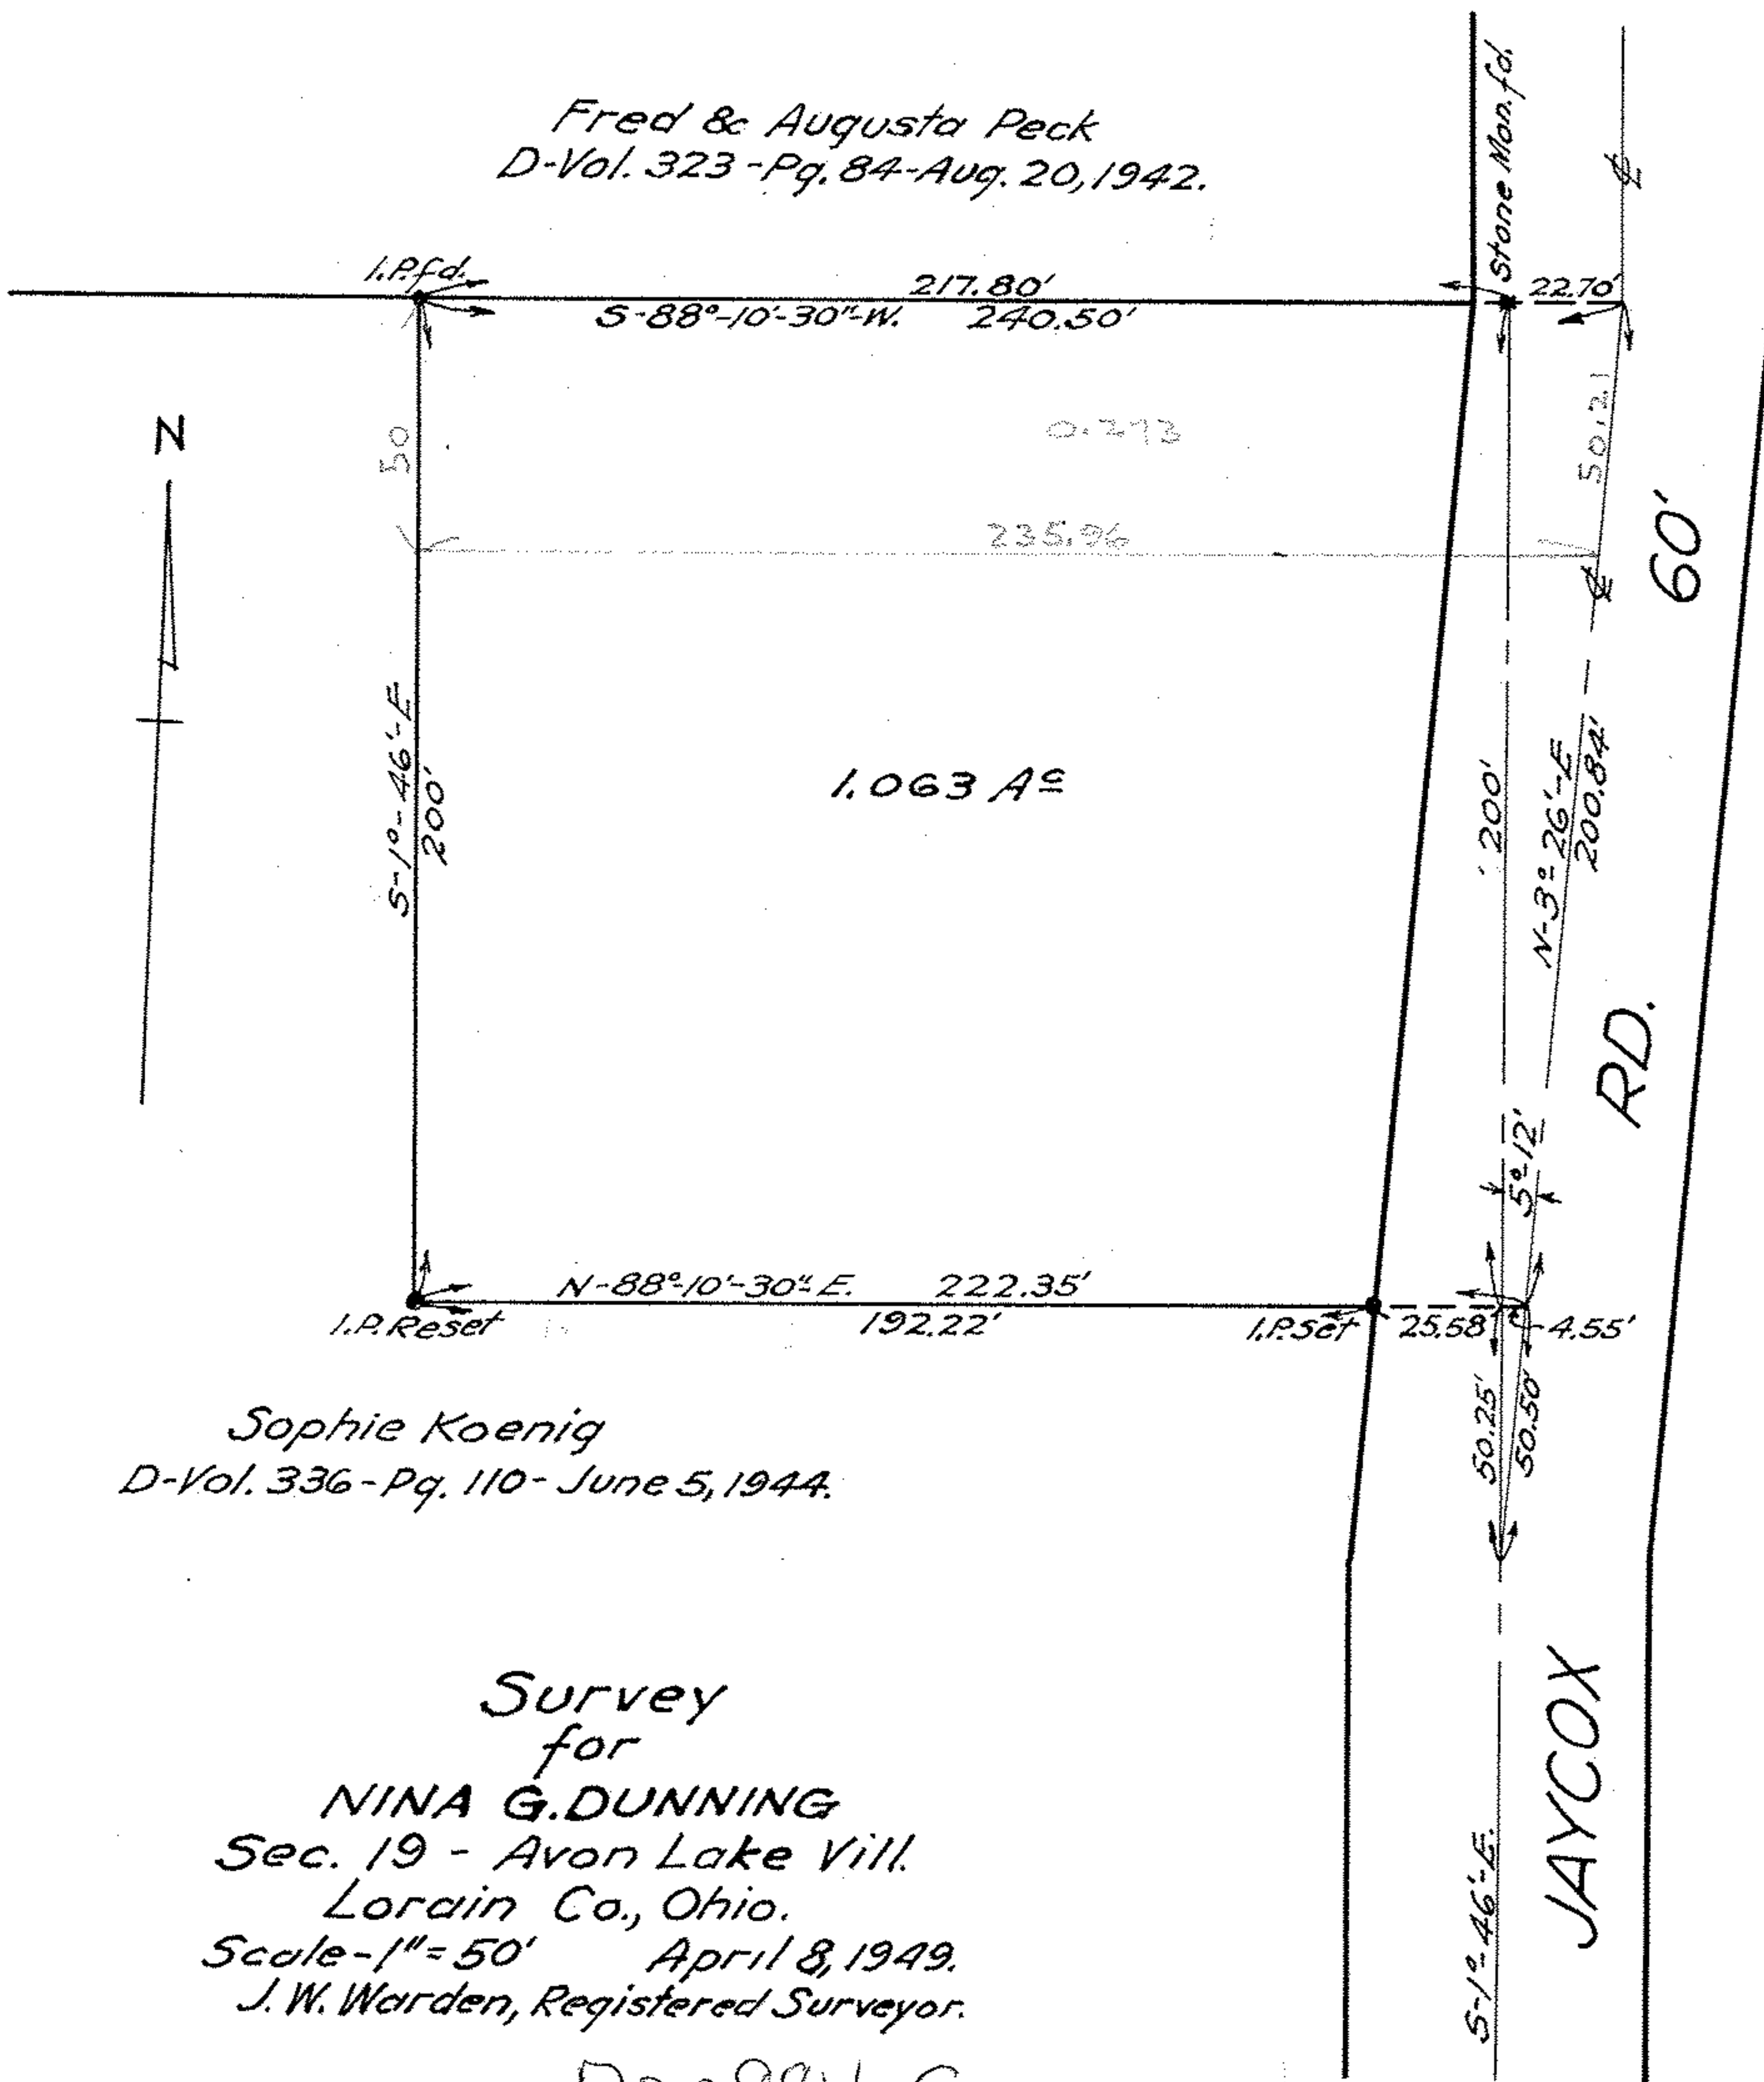

*Sophie Koenig
D-Vol. 336 -Pg. 110- June 5, 1944.*

*Survey
for
NINA G. DUNNING
Sec. 19 - Avon Lake Vill.
Lorain Co., Ohio.
Scale - 1" = 50' April 8, 1949.
J. W. Warden, Registered Surveyor.*

700884 C