

JOHN W. WARDEN & ASSOCIATES

STATE OF OHIO

CIVIL ENGINEERS AND SURVEYORS

TELEPHONE 3211

REGISTERED { PROFESSIONAL ENG.
SURVEYOR


405 ELYRIA BLOCK

ELYRIA, OHIO

North property line

PPN 04-00-019-???-???

MAP Pg 4-00-019-B

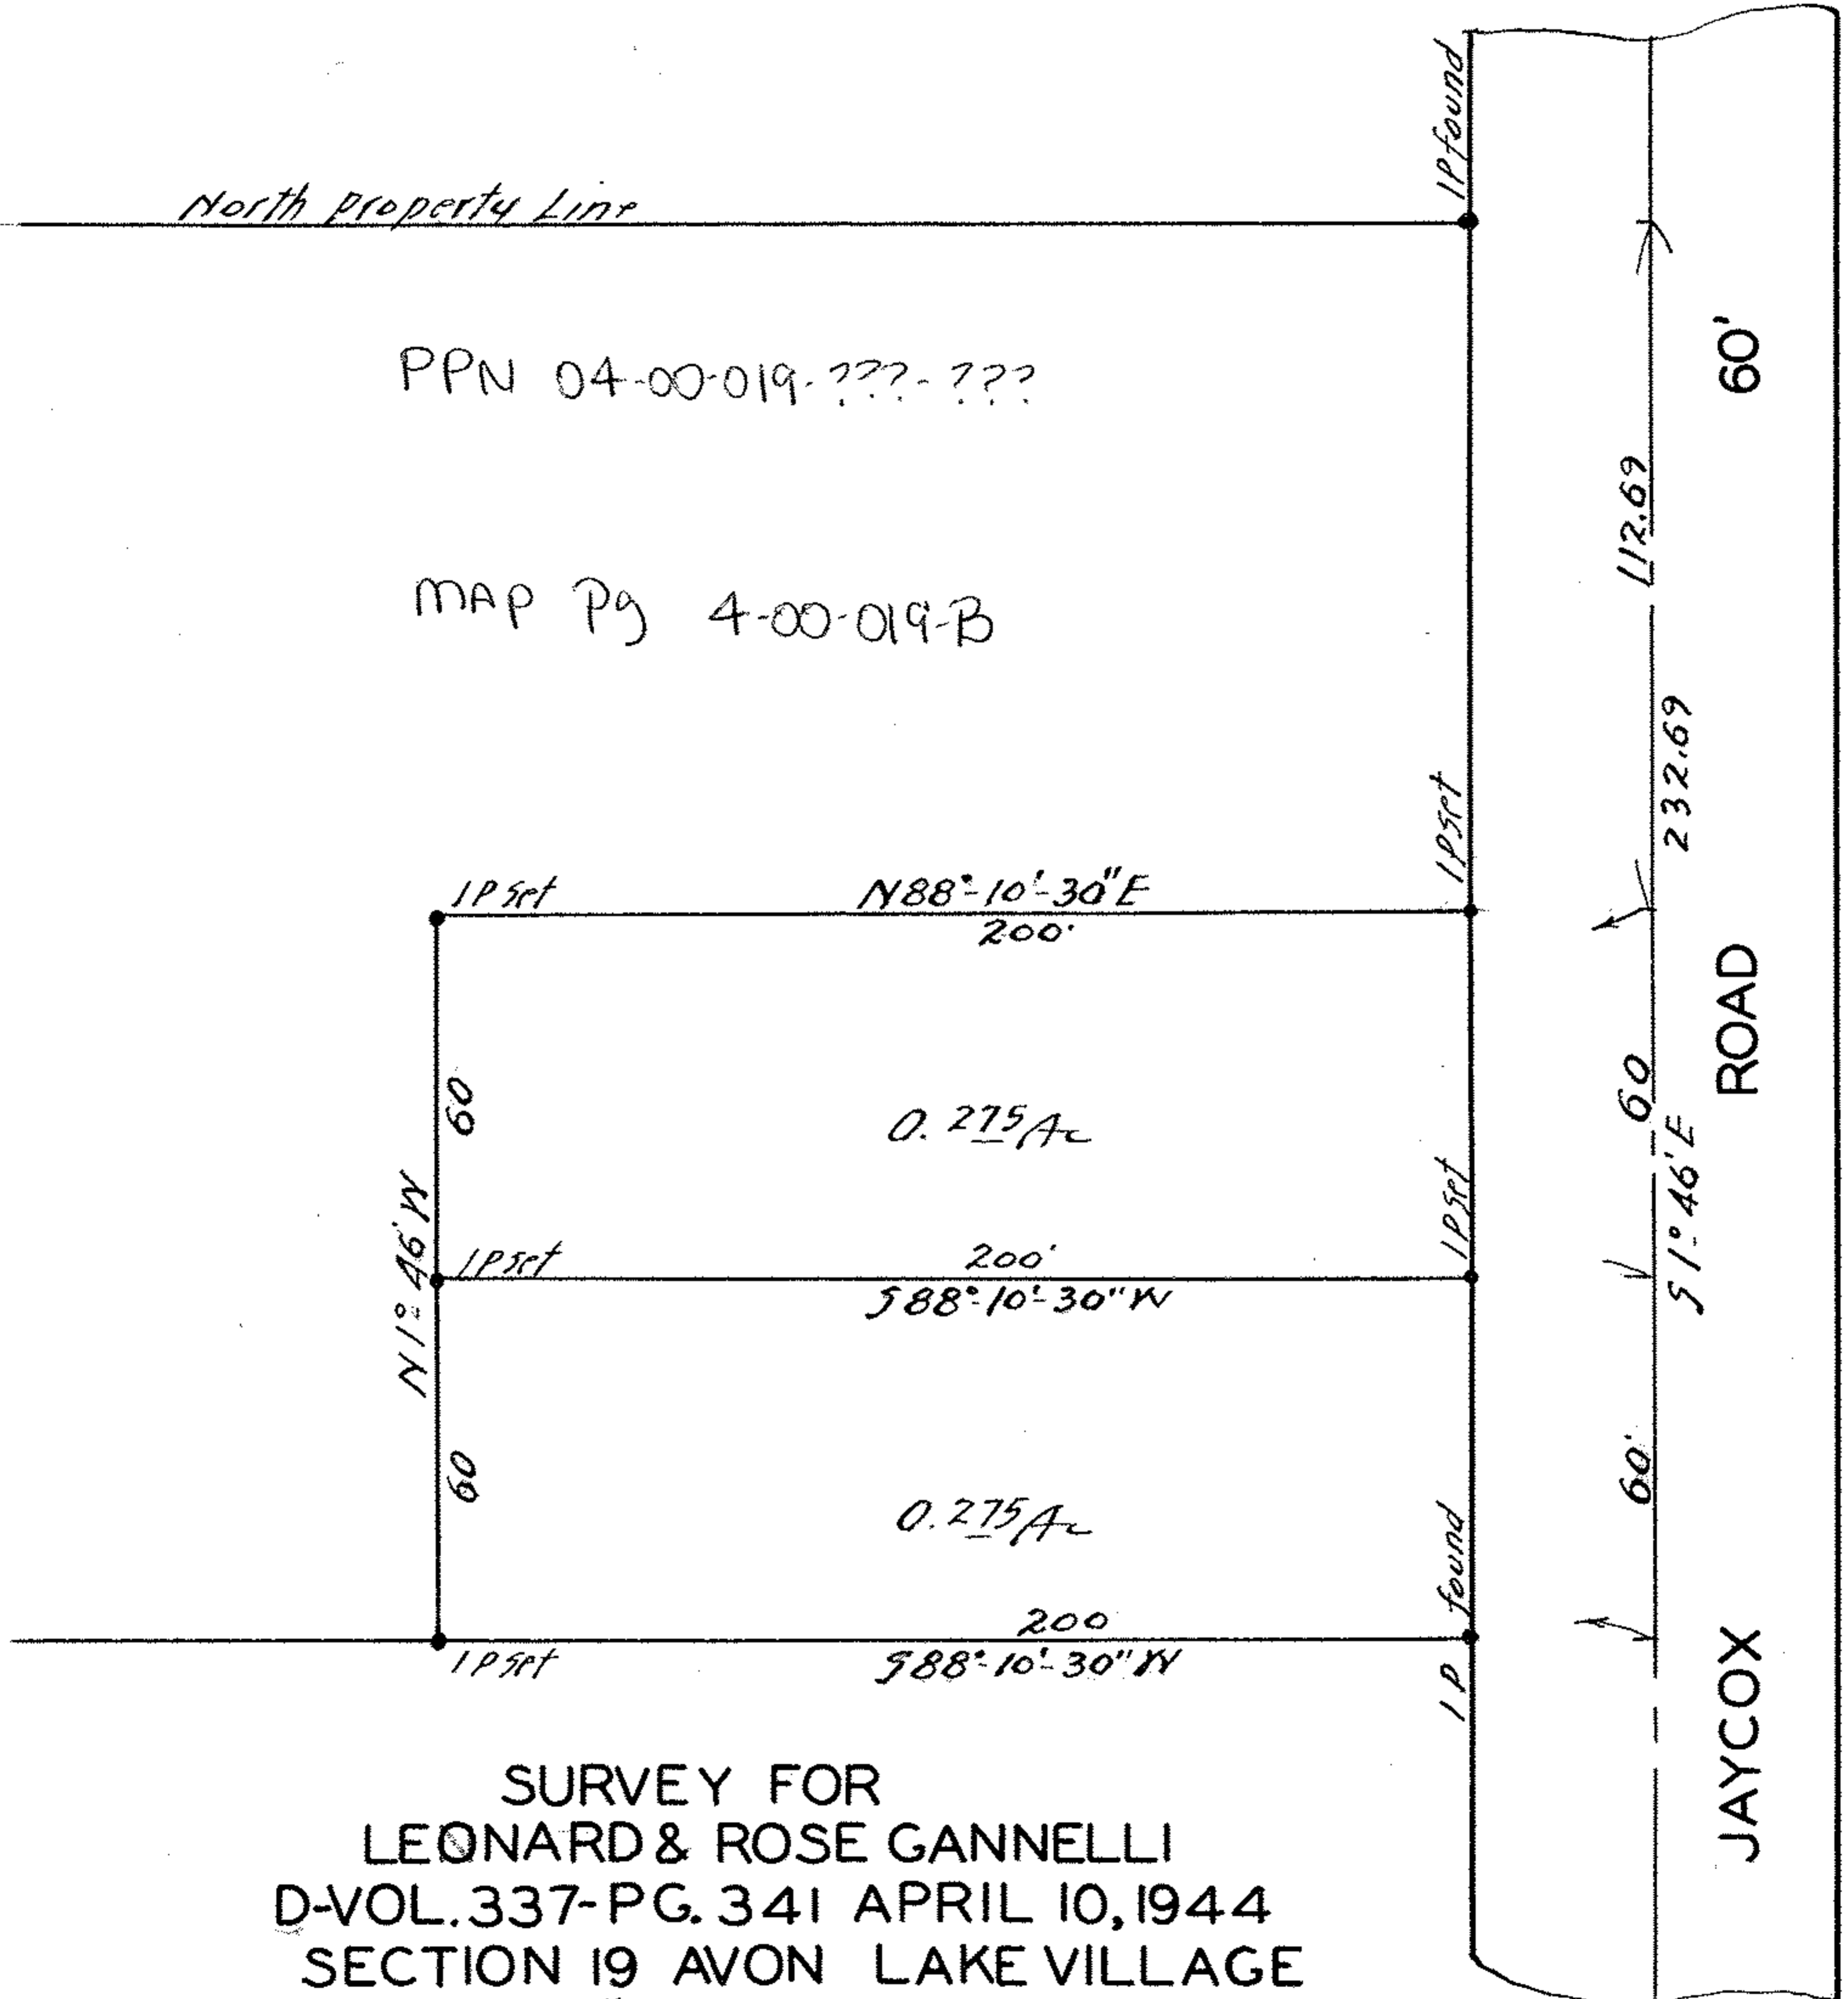

SURVEY FOR
 LEONARD & ROSE GANNELLI
 D-VOL. 337-PG. 341 APRIL 10, 1944
 SECTION 19 AVON LAKE VILLAGE
 SCALE 1"=40' JUNE 22, 1950

700884 A