

JOHN W. WARDEN & ASSOCIATES

STATE OF OHIO


CIVIL ENGINEERS AND SURVEYORS

REGISTERED { PROFESSIONAL ENG.
SURVEYOR

405 ELYRIA BLOCK

TELEPHONE 3211

ELYRIA, OHIO

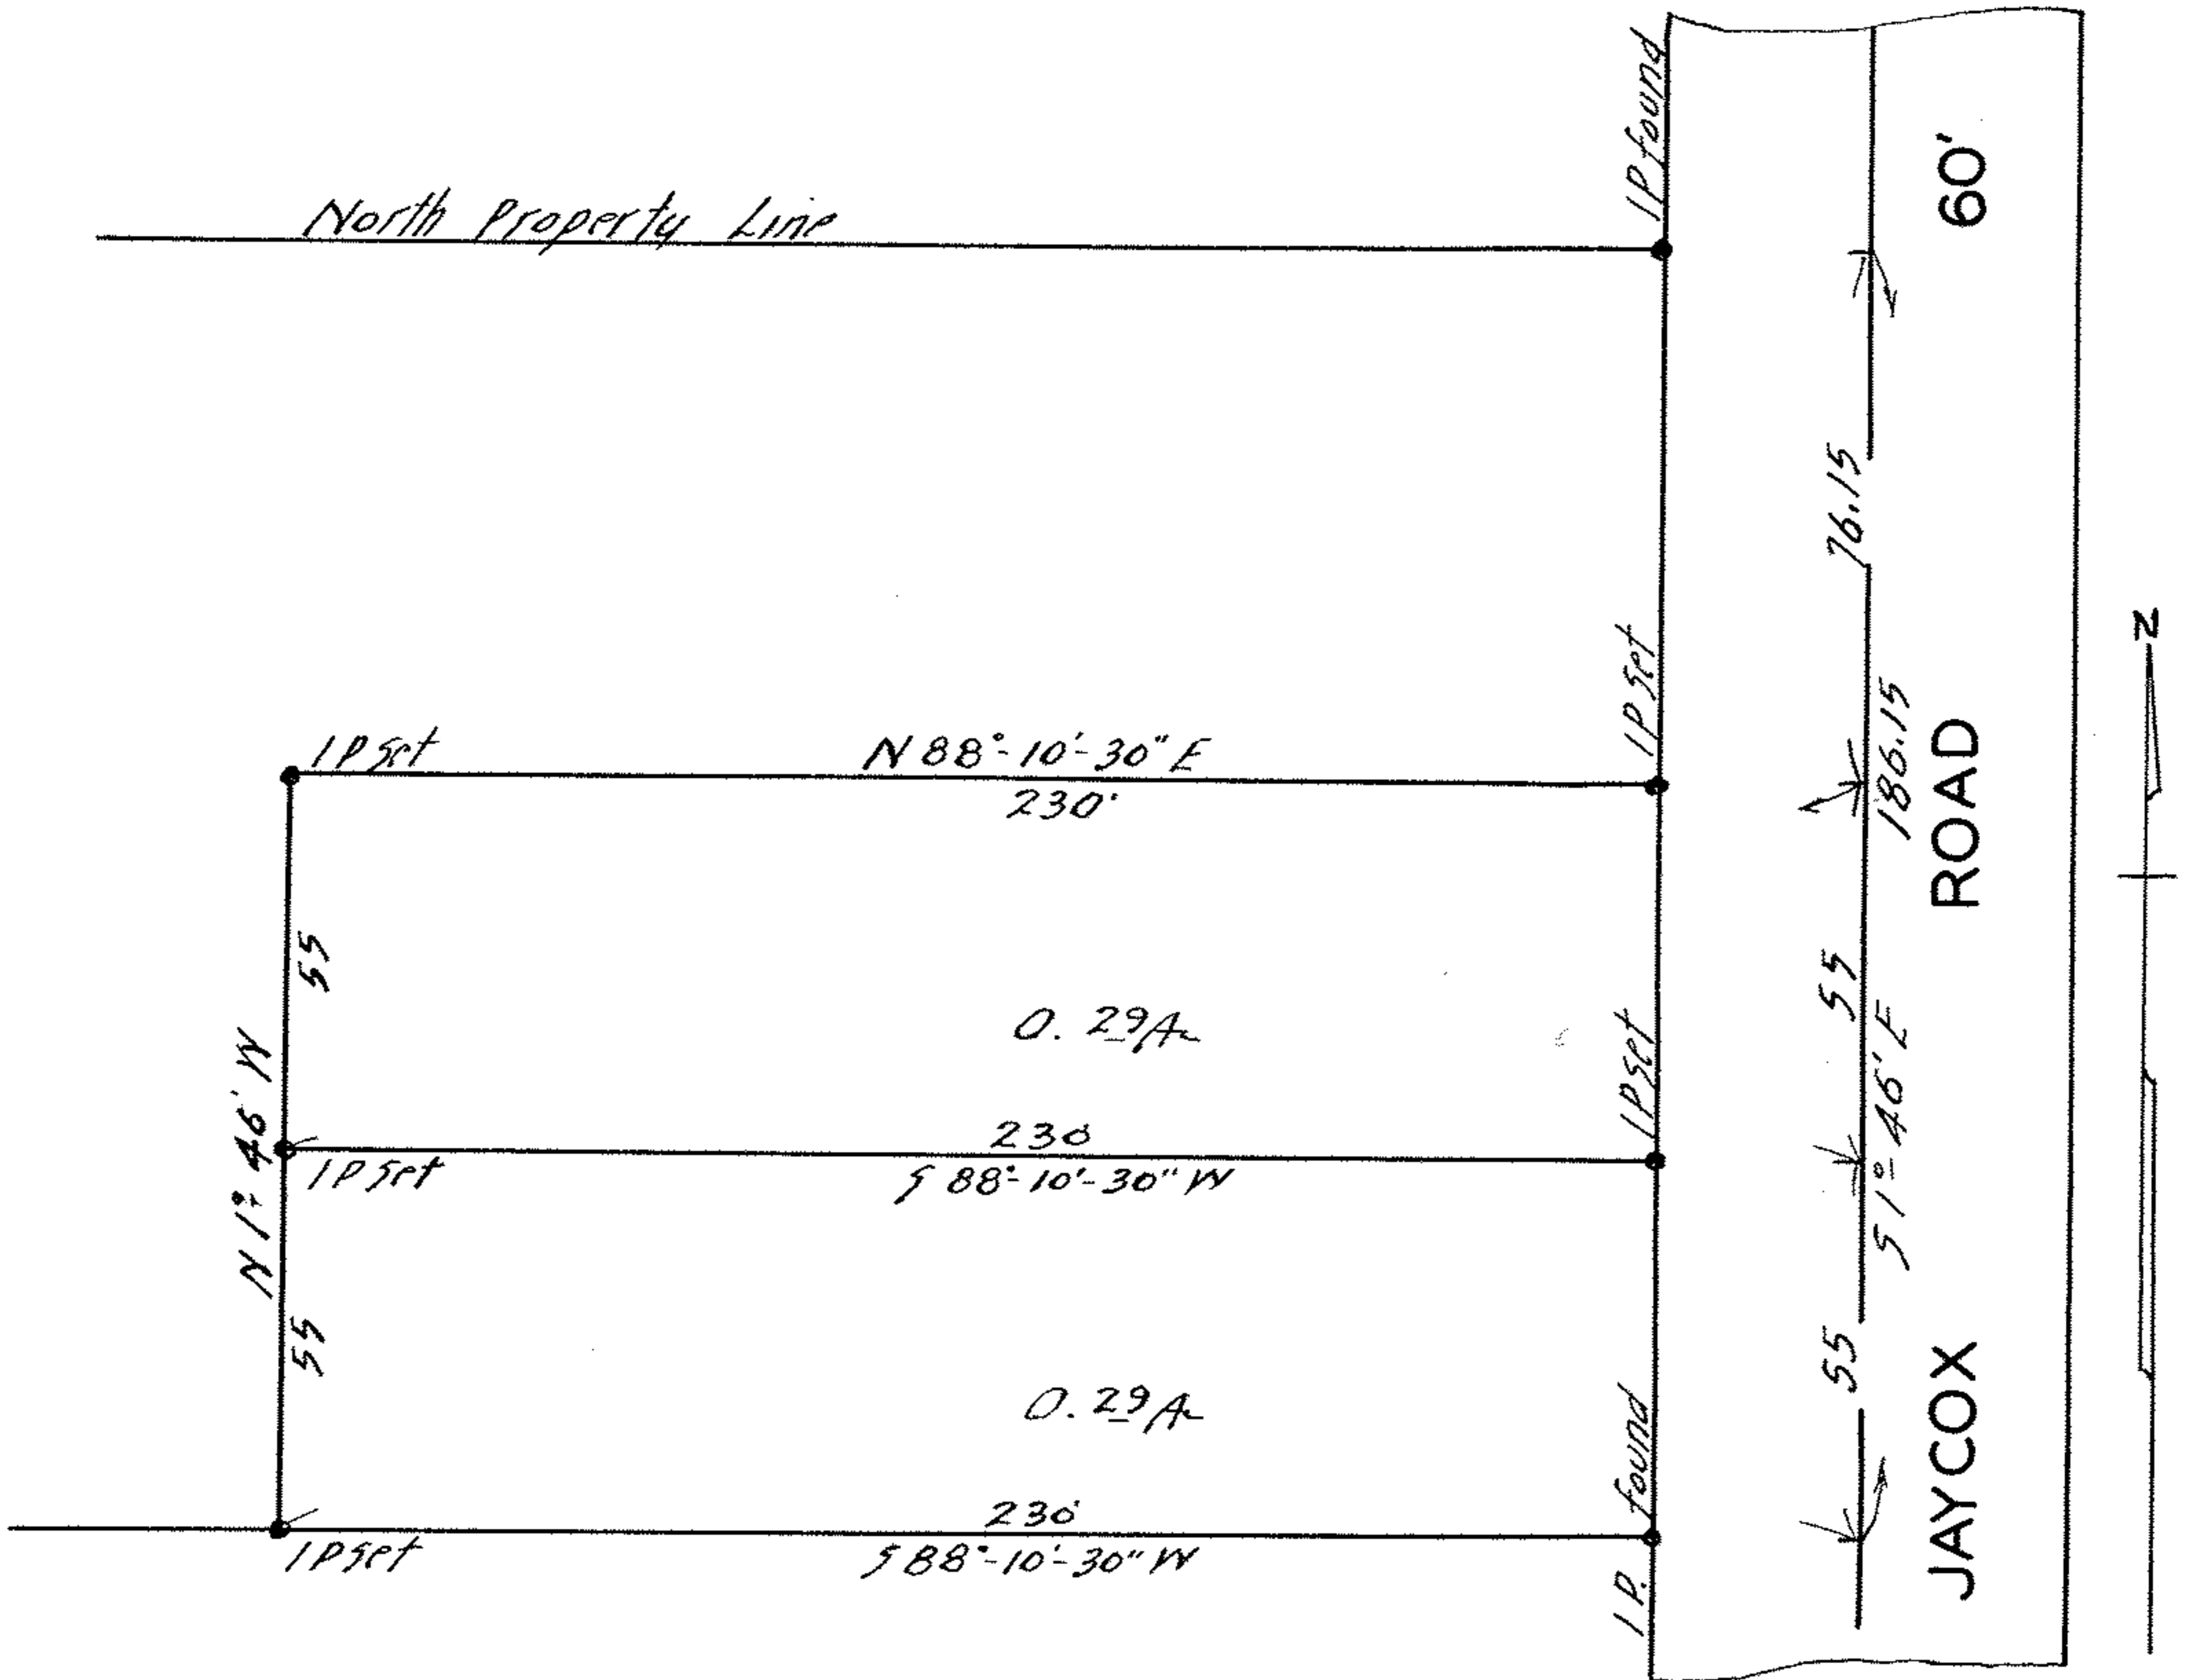

SURVEY FOR
 RUDOLPH HOPKE
 D-VOL.335-PG.80 MAY 13, 1944
 SECTION 19 AVON LAKE VILLAGE
 LORAIN COUNTY OHIO
 SCALE 1"=40' JUNE 22, 1950

700884 B