

# J. W. WARDEN & ASSOCIATES

STATE OF OHIO

CIVIL ENGINEERS AND SURVEYORS

D. D. ANDRUS, PRESIDENT

TELEPHONES FA 2-9828


405 ELYRIA BLOCK

FA 2-1466

ELYRIA, OHIO

M. W. JACKSON  
SECRETARY

REGISTERED { PROFESSIONAL ENG.  
SURVEYOR

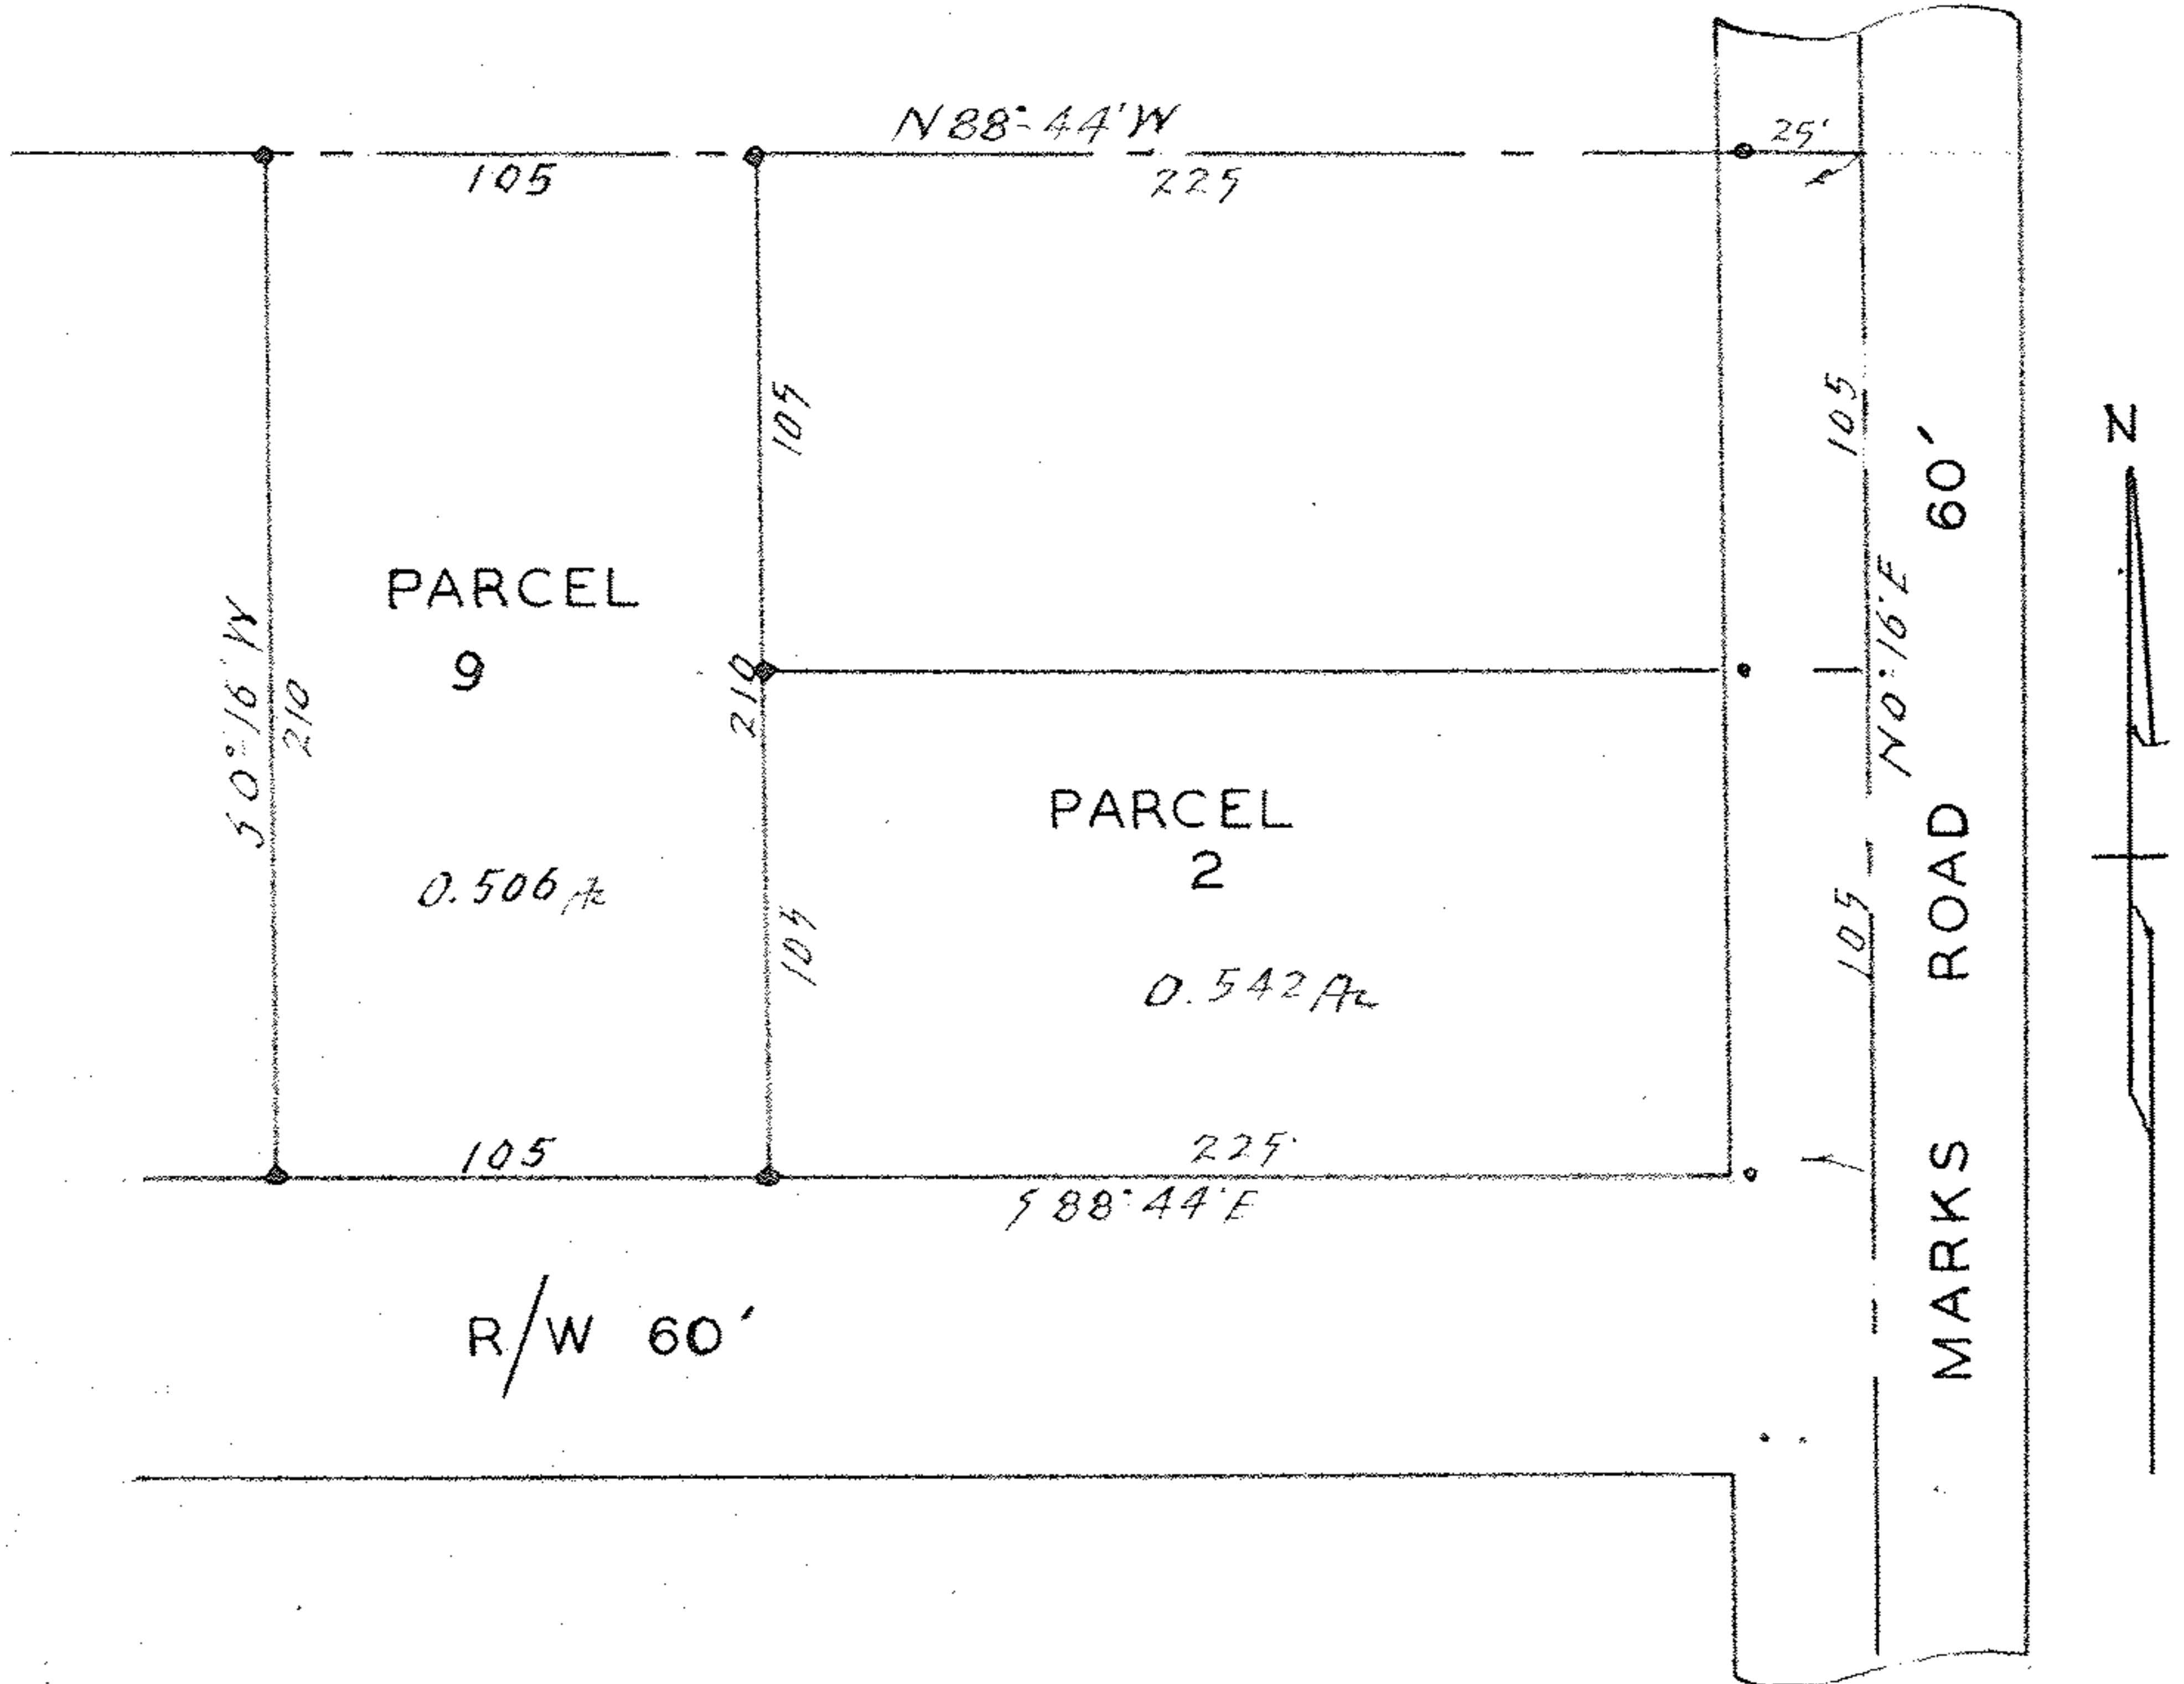

Survey for <sup>10</sup>  
 MATT J. AND MARIE J. BERGER <sup>27</sup>  
 O. L. 8 COLUMBIA TOWNSHIP <sup>25</sup>  
 LORAIN COUNTY, OHIO <sup>19</sup>  
 SCALE 1" = 60' MARCH 15, 1962 <sup>29</sup>

50