


EAST FOURTH STREET 66'

MIDDLE AVENUE 99'

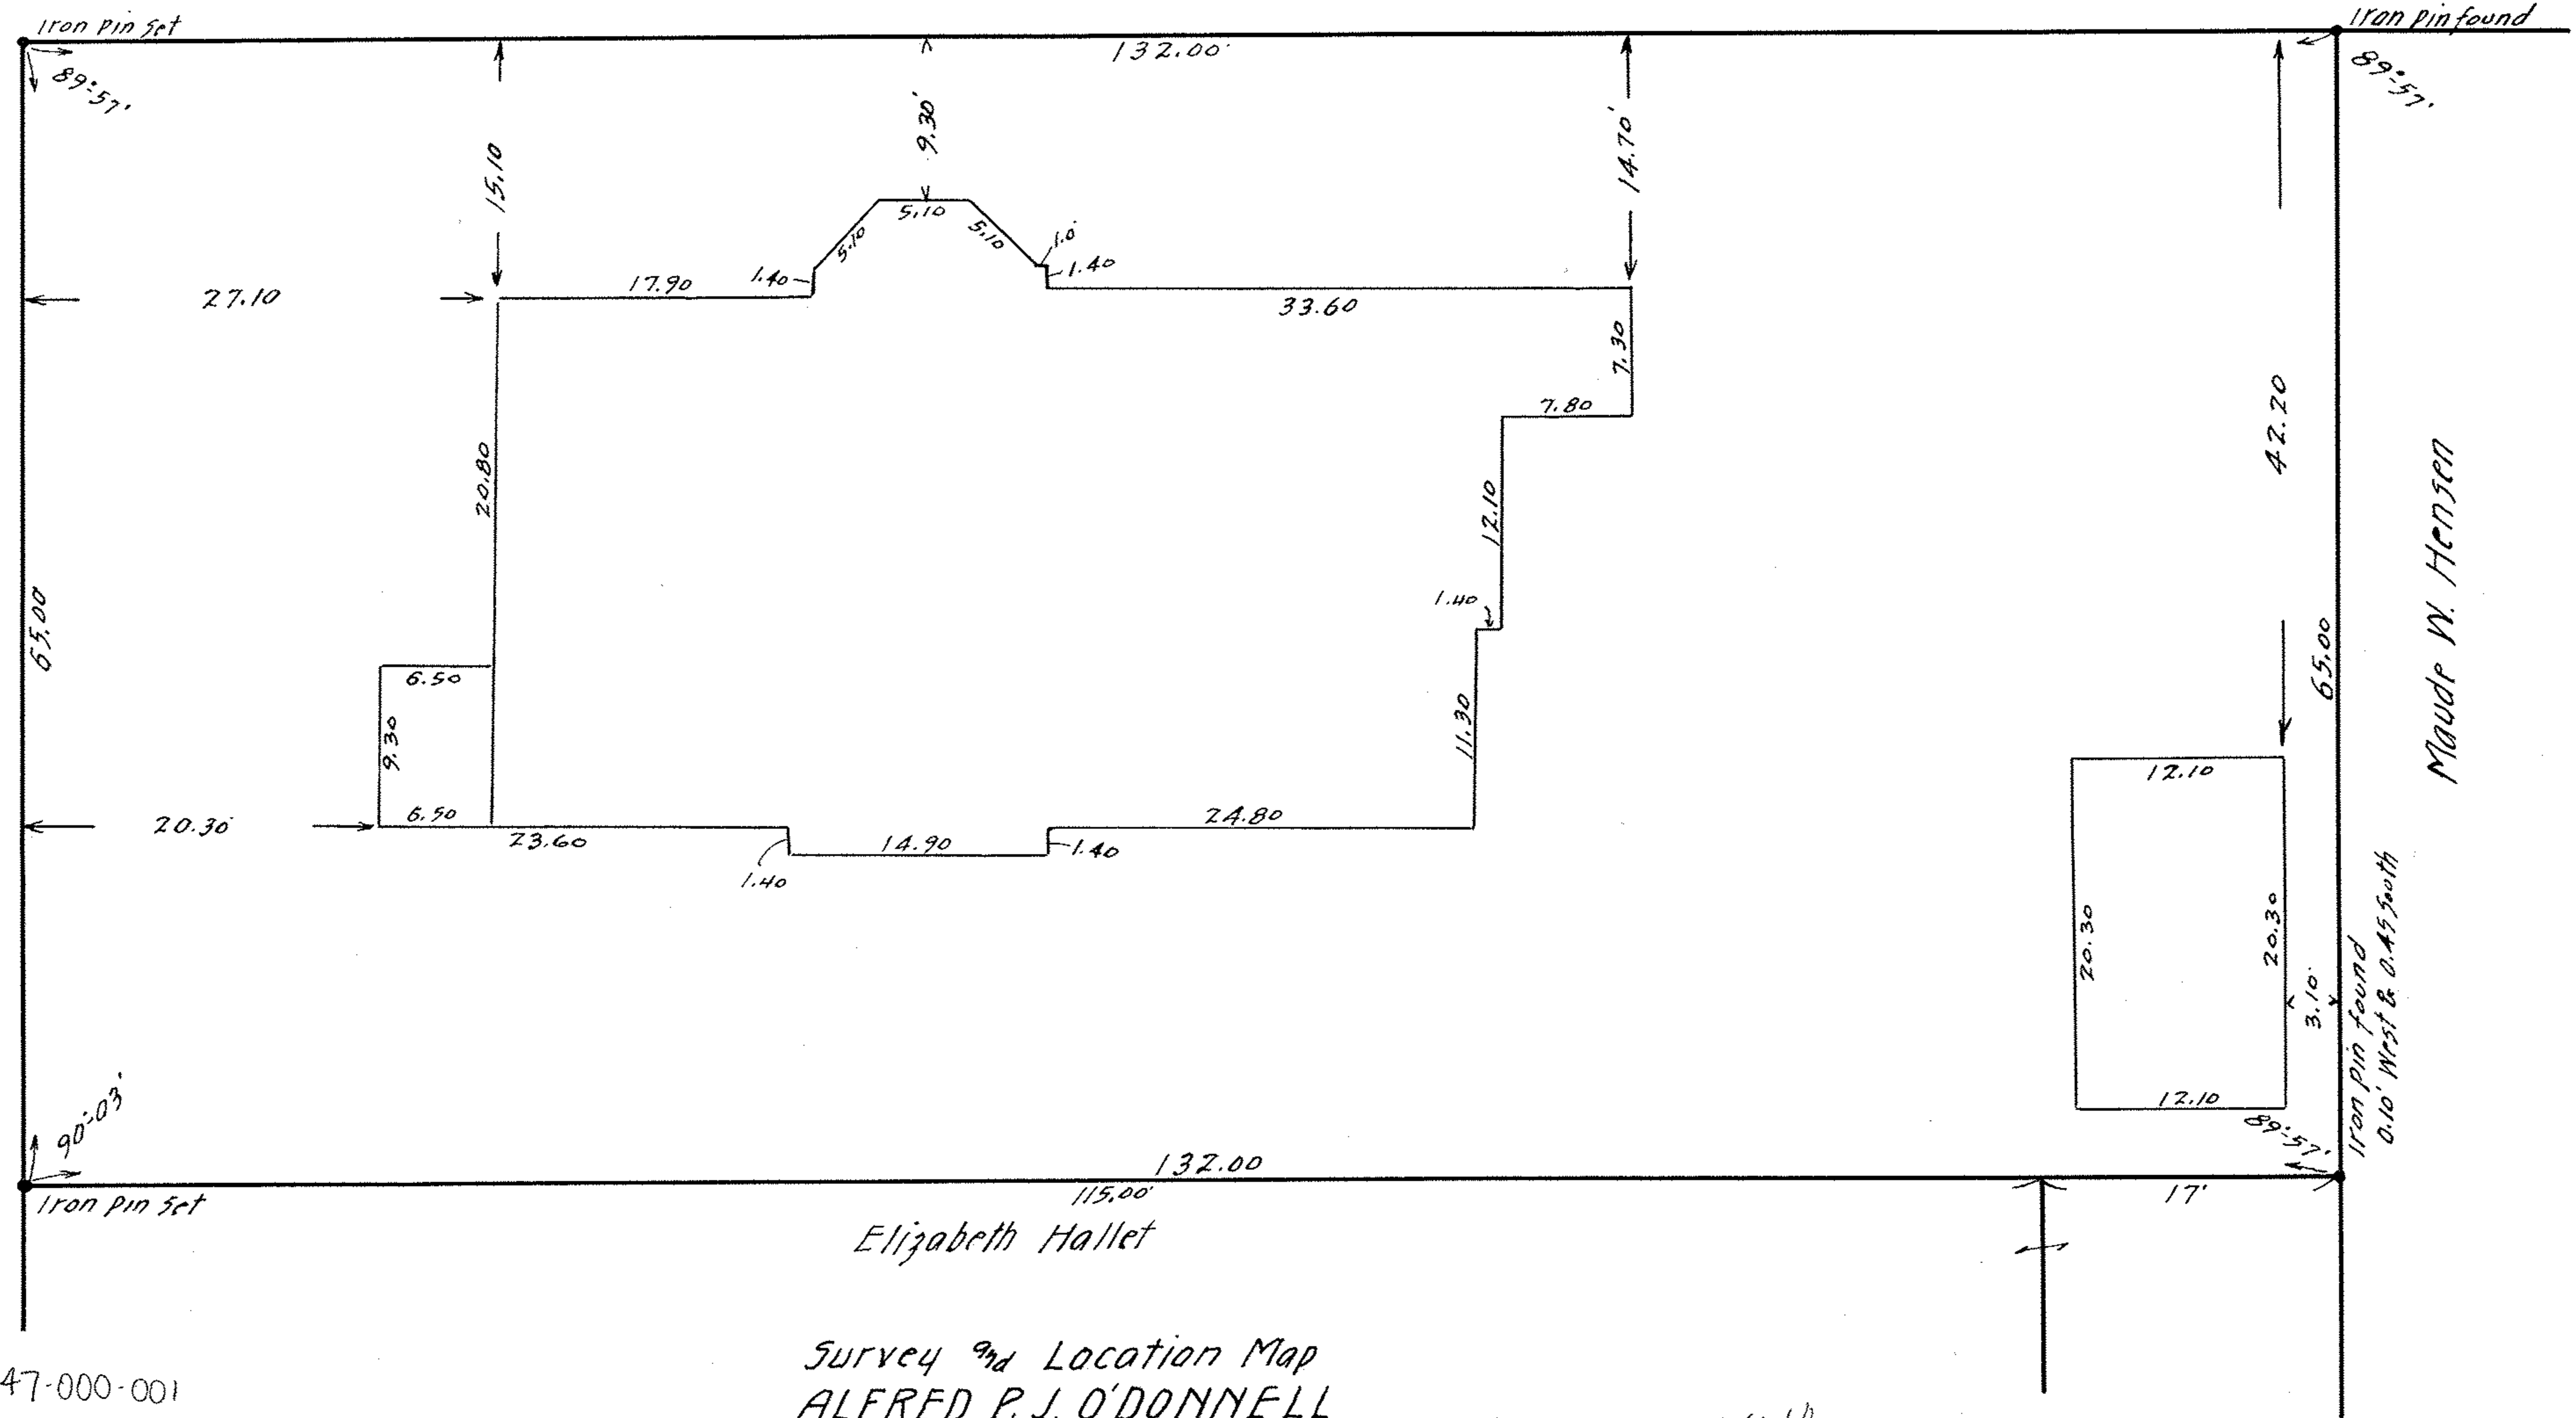

PPN 06-26-047-000-001

MAP PG 6-120

Survey and Location Map
 ALFRED P. J. O'DONNELL
 D-Vol. 294-Pg 216 Aug. 12, 1938.
 Block 47 Lot 340 Elyria City,
 Lorain County Ohio
 scale 1" = 10' Nov. 27 1946
 J. W. Warden, Registered Surveyor.

14-1444