

J. W. WARDEN & ASSOCIATES


CIVIL ENGINEERS AND SURVEYORS

D. D. ANDRUS, PRESIDENT
405 ELYRIA BLOCK
ELYRIA, OHIO

TELEPHONES 3211
42871

M. W. JACKSON
SECRETARY

STATE OF OHIO
REGISTERED } PROFESSIONAL ENG.
SURVEYOR

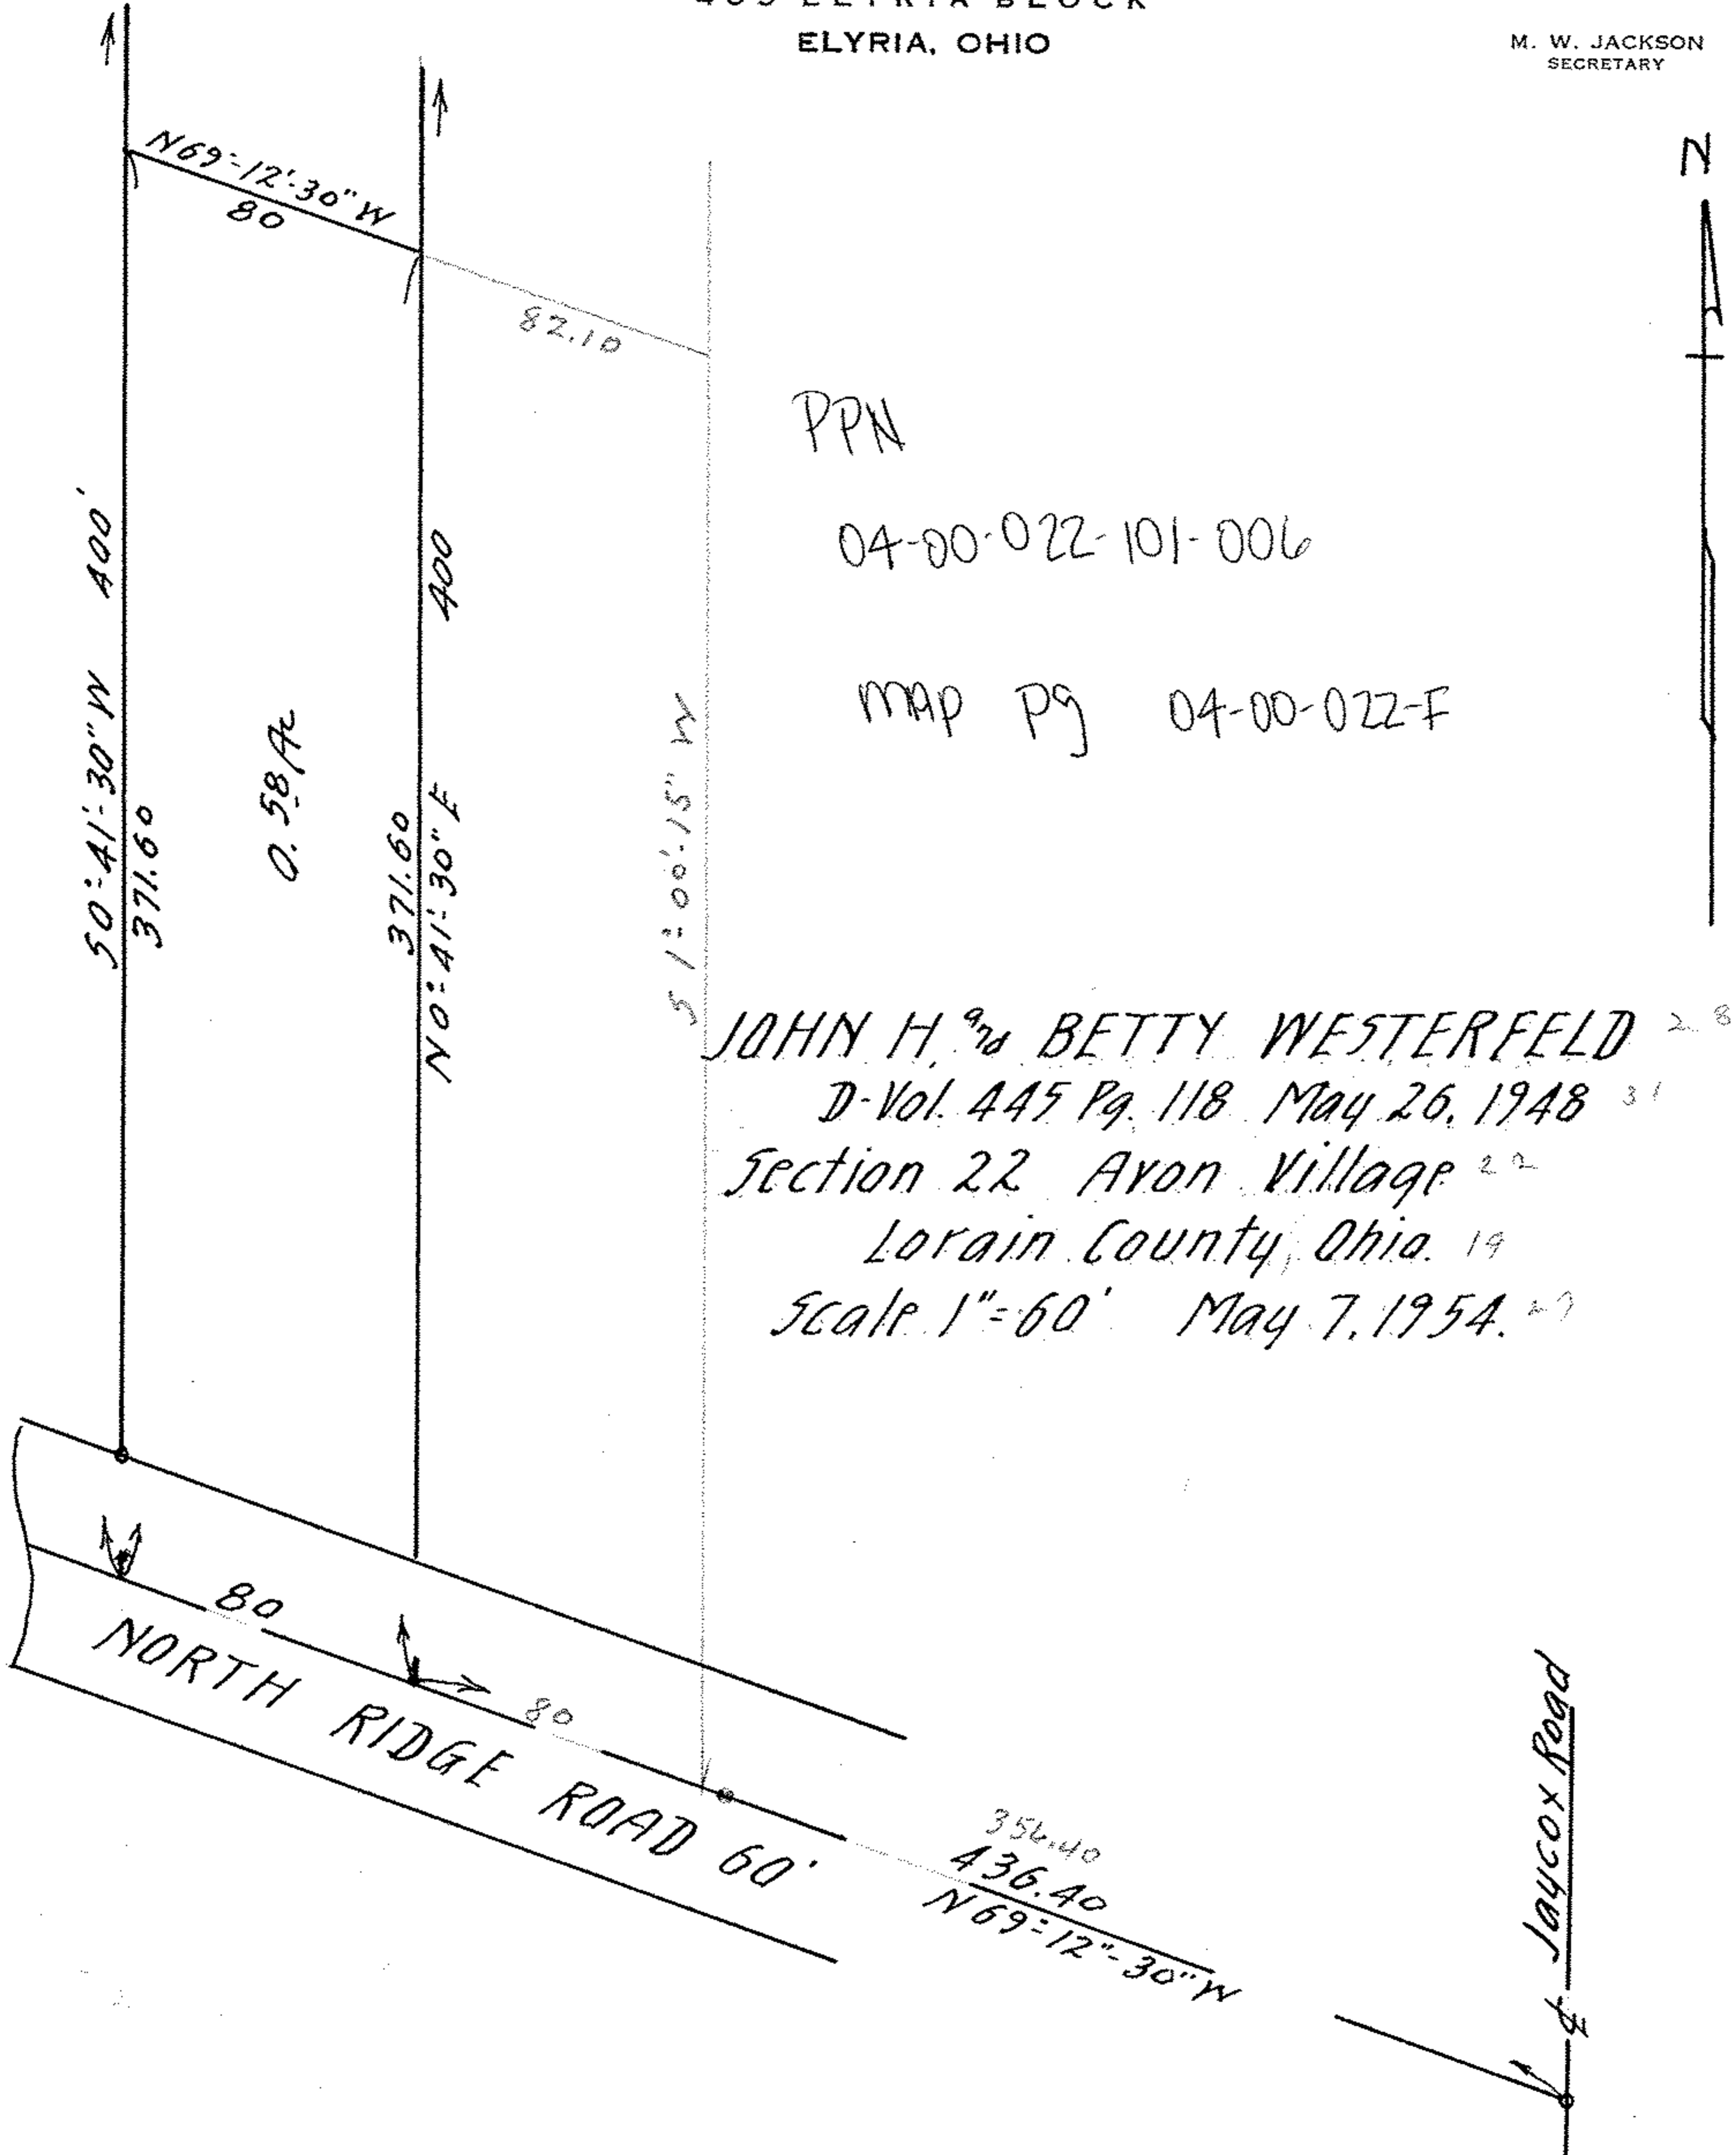

JOHN H. ^{9th} BETTY WESTERFELD ²⁻⁸
 D-Vol. 445 Pg. 118 May 26, 1948 ³¹
 Section 22 Avon Village ²⁰
 Lorain County, Ohio. ¹⁹
 Scale 1"=60' May 7, 1954. ²⁷