


JOHN W. WARDEN
 CIVIL ENGINEER AND SURVEYOR
 405 ELYRIA BLOCK
 ELYRIA, OHIO

STATE OF OHIO
 REGISTERED } PROFESSIONAL ENG.
 SURVEYOR

PHONES
 BUSINESS 3211
 RESIDENCE 38633

John & Betty Mustorfold
 440-118 May 26, 1948
 324-41 Jan 18 1948

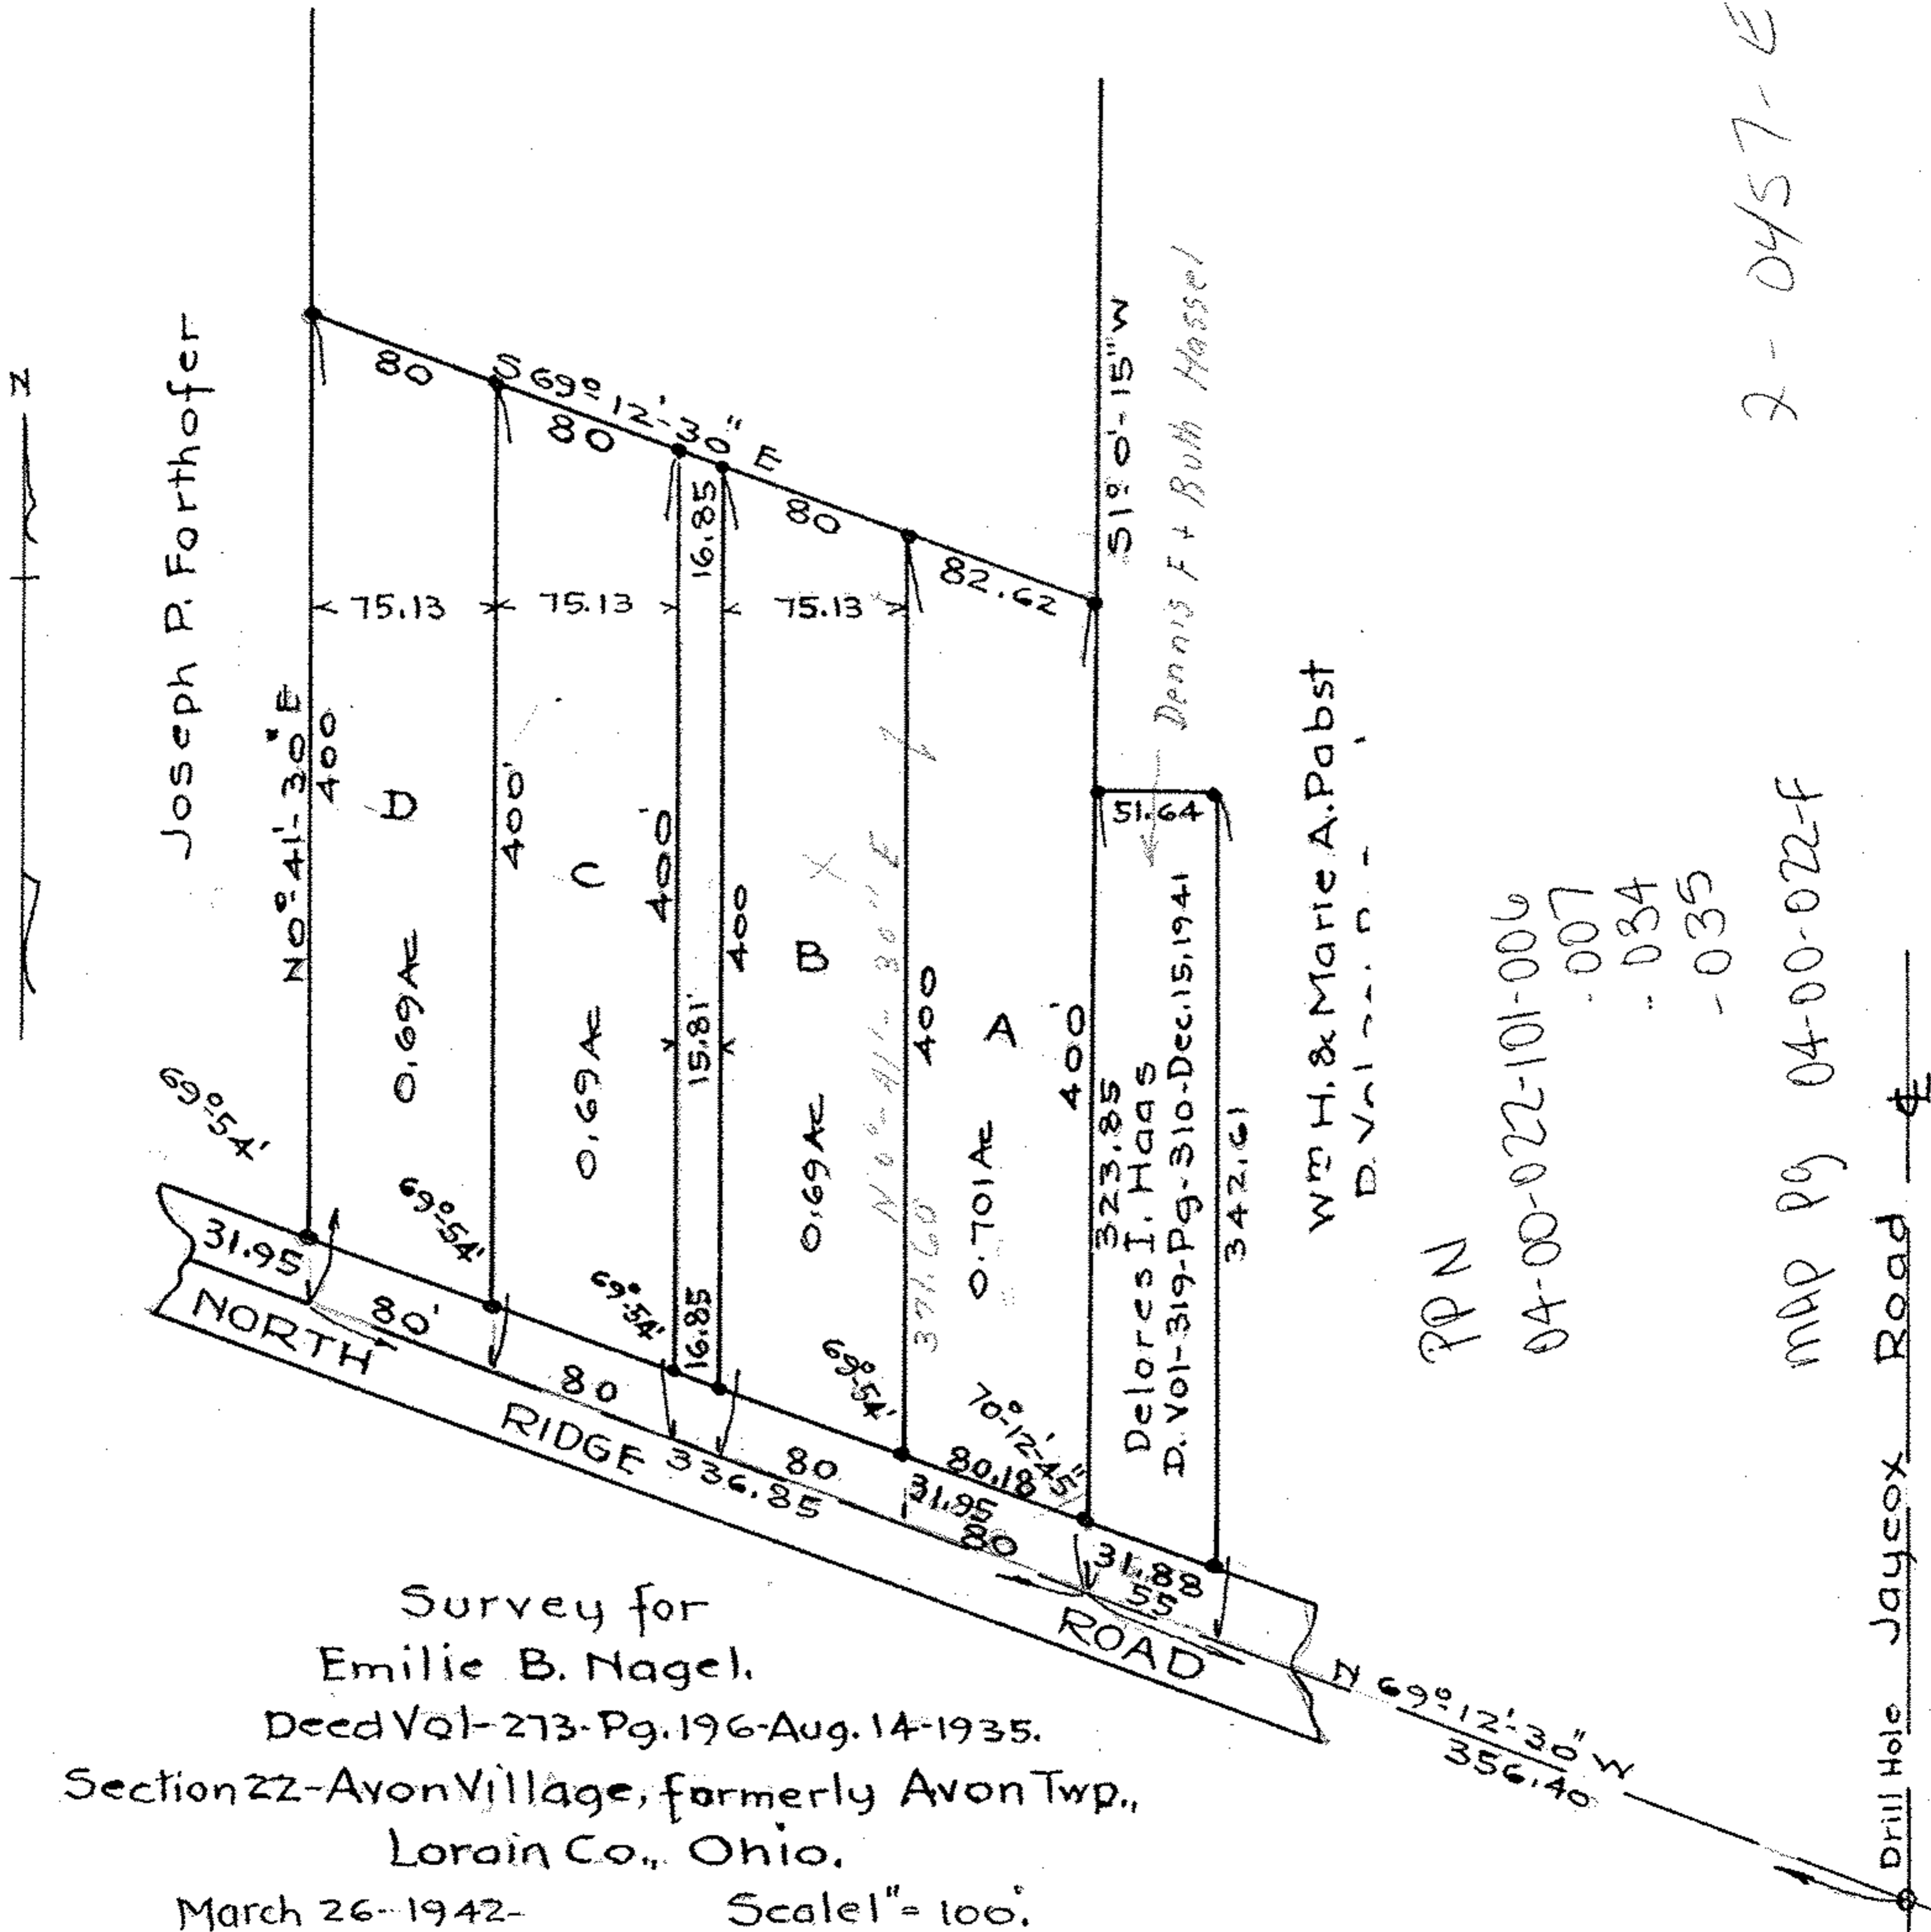

Survey for
 Emilie B. Nagel.
 Deed Vol-273-Pg.196-Aug.14-1935.
 Section 22-Avon Village, formerly Avon Twp.,
 Lorain Co., Ohio.
 March 26-1942- Scale" = 100'

2-0457-E

PPN
 04-00-022-101-006
 .007
 .034
 .035
 MAP Pg 04-00-022-F

Wm H. & Marie A. Pabst
 D. Vol. 319-Pg. 310-Dec. 15, 1941

Drill Hole Jaycox Road