

JOHN W. WARDEN

CIVIL ENGINEER AND SURVEYOR

405 ELYRIA BLOCK

ELYRIA, OHIO

STATE OF OHIO

REGISTERED

PROFESSIONAL ENG.
SURVEYOR

PHONES

BUSINESS 3211

RESIDENCE 38633

*Survey for
Frank A. Nagel Est.
D-Vol. 290 pg. 211 Nov. 20, 1937
Sec. 22 Avon Village,
Larain County Ohio
Scale 1"=50' June. 22, 1943.*

*Ignatius F. Hortsman Bishop
D-Vol. 82-pg. 478 March 31 1900.*


*John Eppich
D-Vol 208-pg. 6 Oct. 9, 1924*

*Fred & Charlotte Ulmer
D-Vol 320 pg. 25 April 23 1942.*

*Wm & Delphina Linden
D-Vol- 234-pg. 123 Feb. 6, 1928.*

*John Schober
D-Vol. 279 pg. 425 Nov. 14, 1936*

*Gilbert J. Forthofer
D-Vol 288-pg. 591-Jan. 26, 1938.*

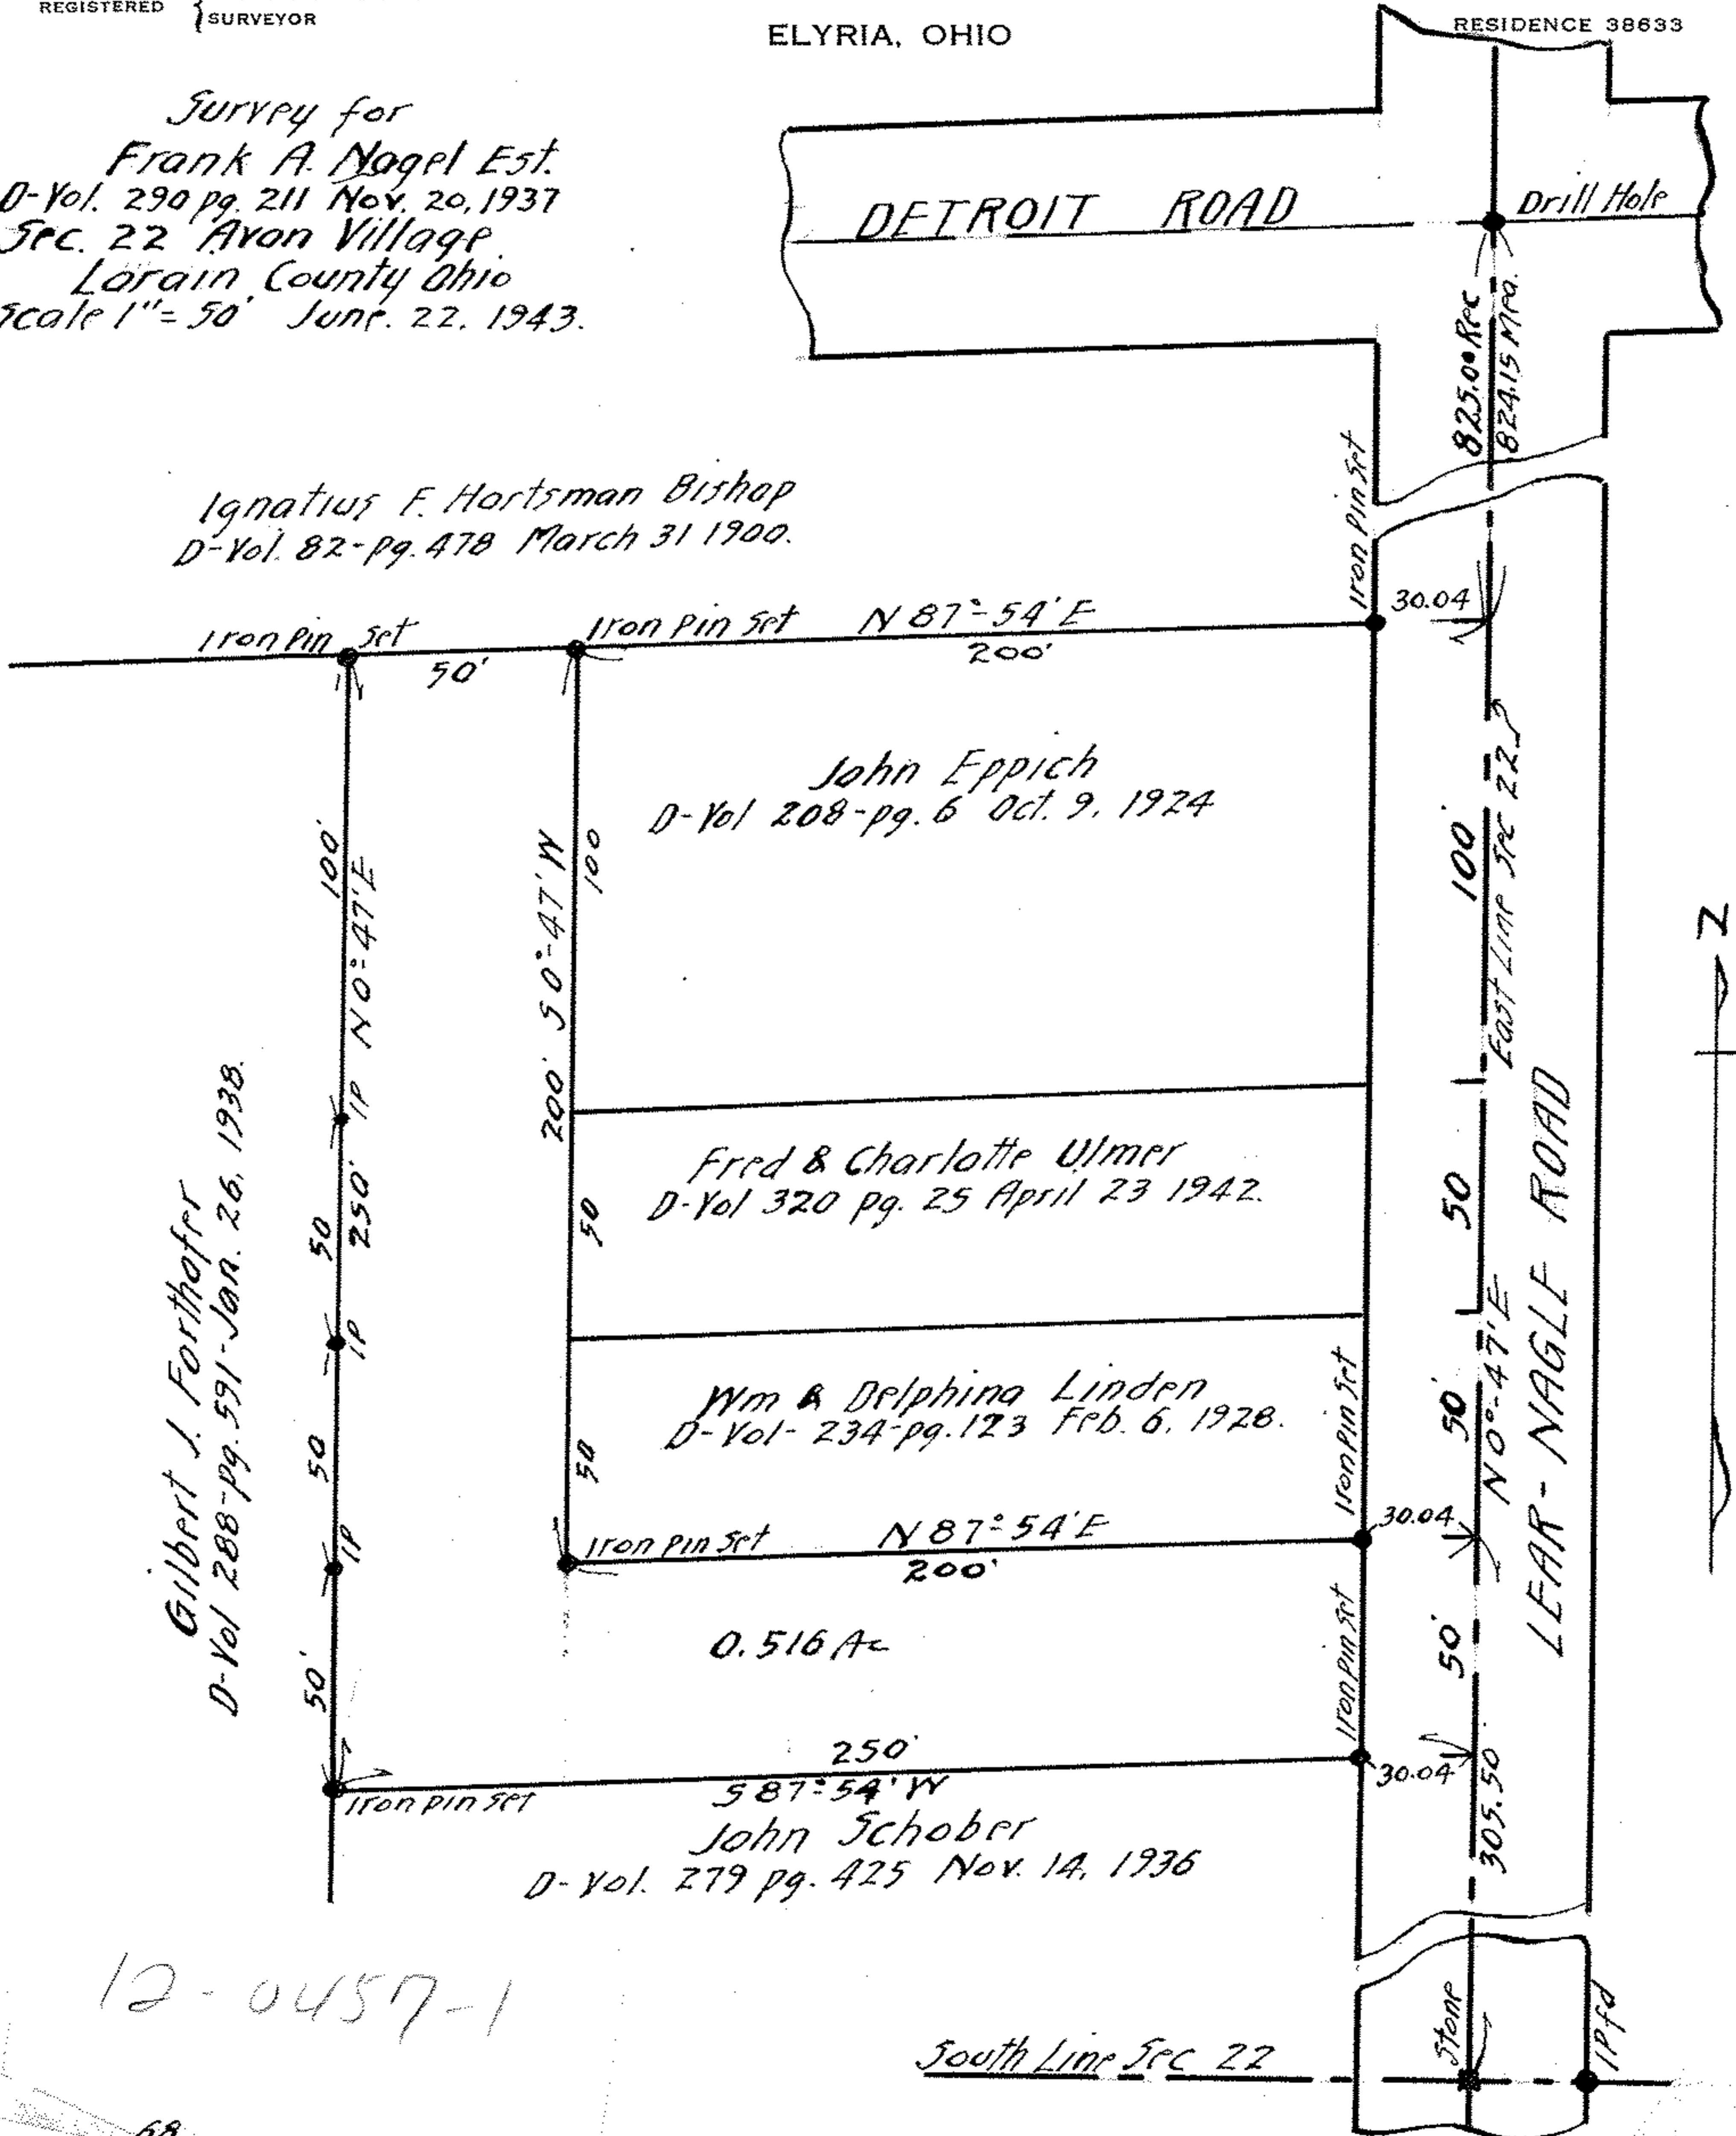

12-0457-1