

J. W. WARDEN & ASSOCIATES

CIVIL ENGINEERS AND SURVEYORS


D. D. ANDRUS, PRESIDENT
405 ELYRIA BLOCK
ELYRIA, OHIO

TELEPHONES 3211
42871

M. W. JACKSON
SECRETARY

STATE OF OHIO
REGISTERED } PROFESSIONAL ENG.
SURVEYOR

Henry Hahn Jr.
D-Vol. 39-Pg. 520 May 11, 1875.

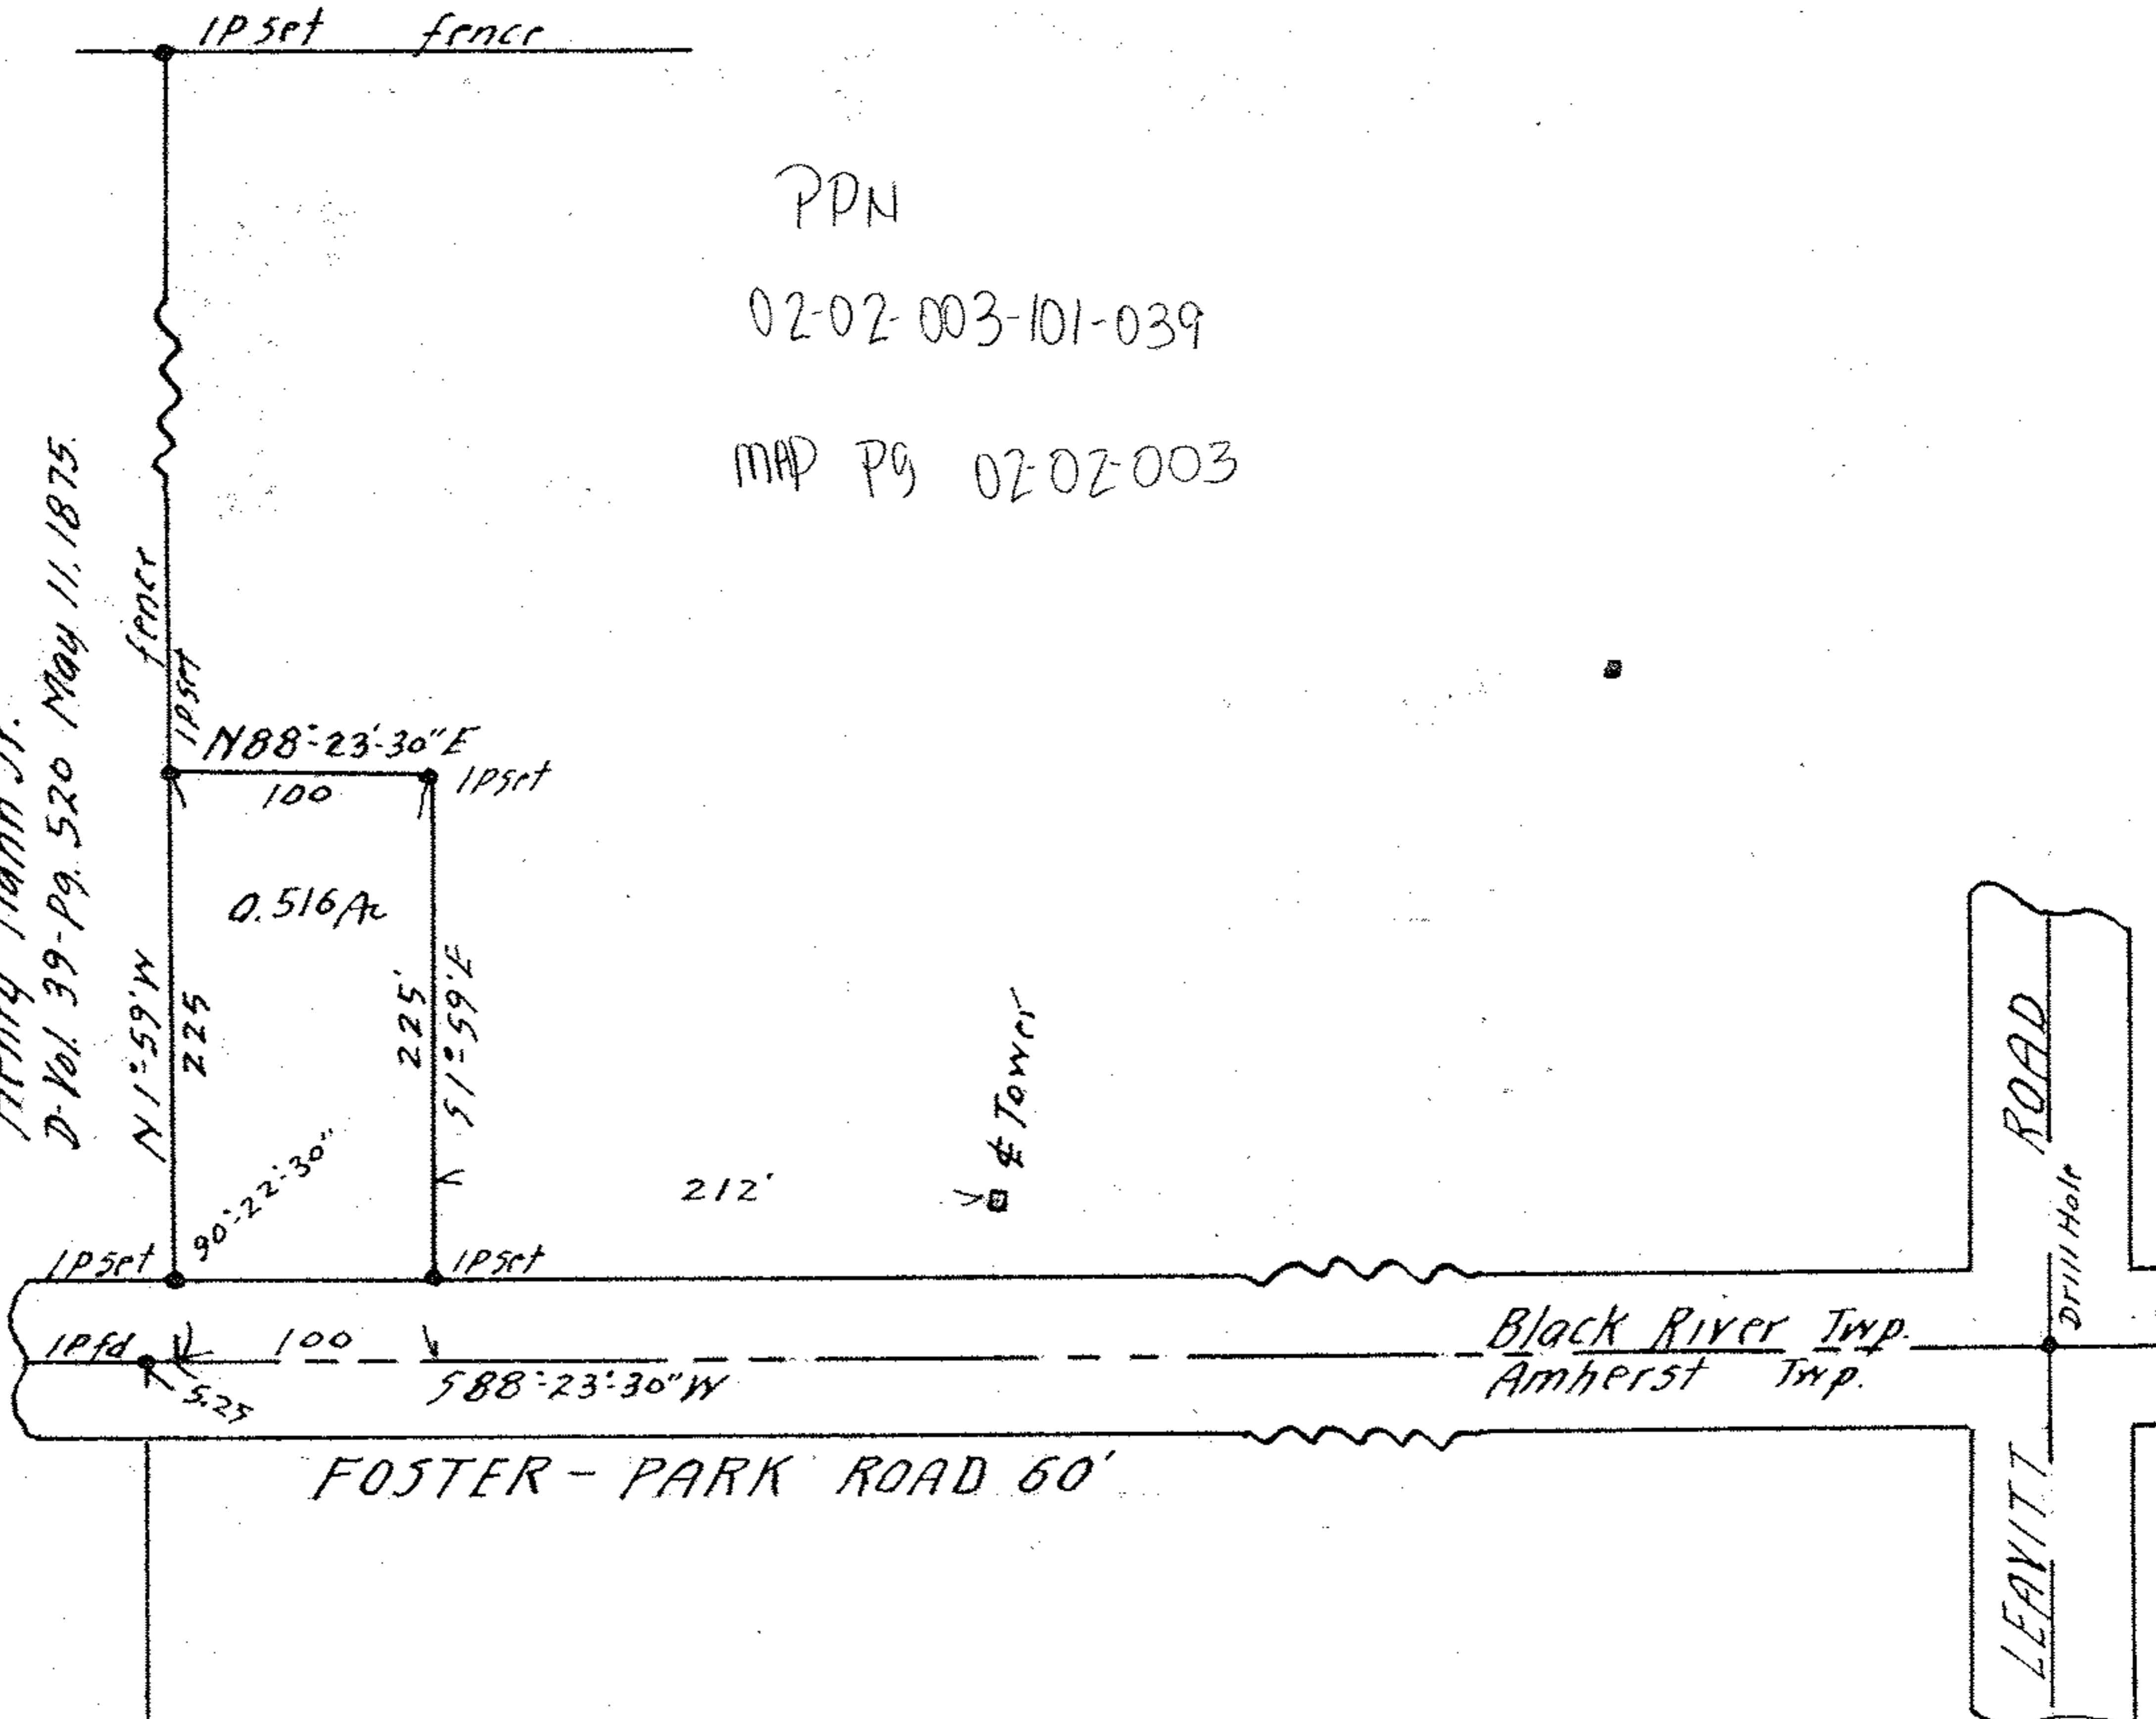

SURVEY FOR CLEM RICE OF PROPERTY OF
RAYMOND A. & ALMA L. BAUMHARDT
D-VOL. 397 PG. 601 AUG. 30, 1946
TRACT 2 LOT 2 BLACK RIVER TOWNSHIP
LORAIN COUNTY, OHIO
SCALE 1" = 100' OCT. 13, 1952