

J. W. WARDEN & ASSOCIATES

CIVIL ENGINEERS AND SURVEYORS

D. D. ANDRUS, PRESIDENT
405 ELYRIA BLOCK
ELYRIA, OHIO

STATE OF OHIO

REGISTERED } PROFESSIONAL ENG
SURVEYOR


TELEPHONE 3211
42871

M. W. JACKSON
SECRETARY

Randall A. Smith
D-Val. 437 Pg. 289 April 5 1948

Clem^{9th} Helen Rice
D-Val 495 Pg. 115 July 29 1950

LEAVITT ROAD 60'

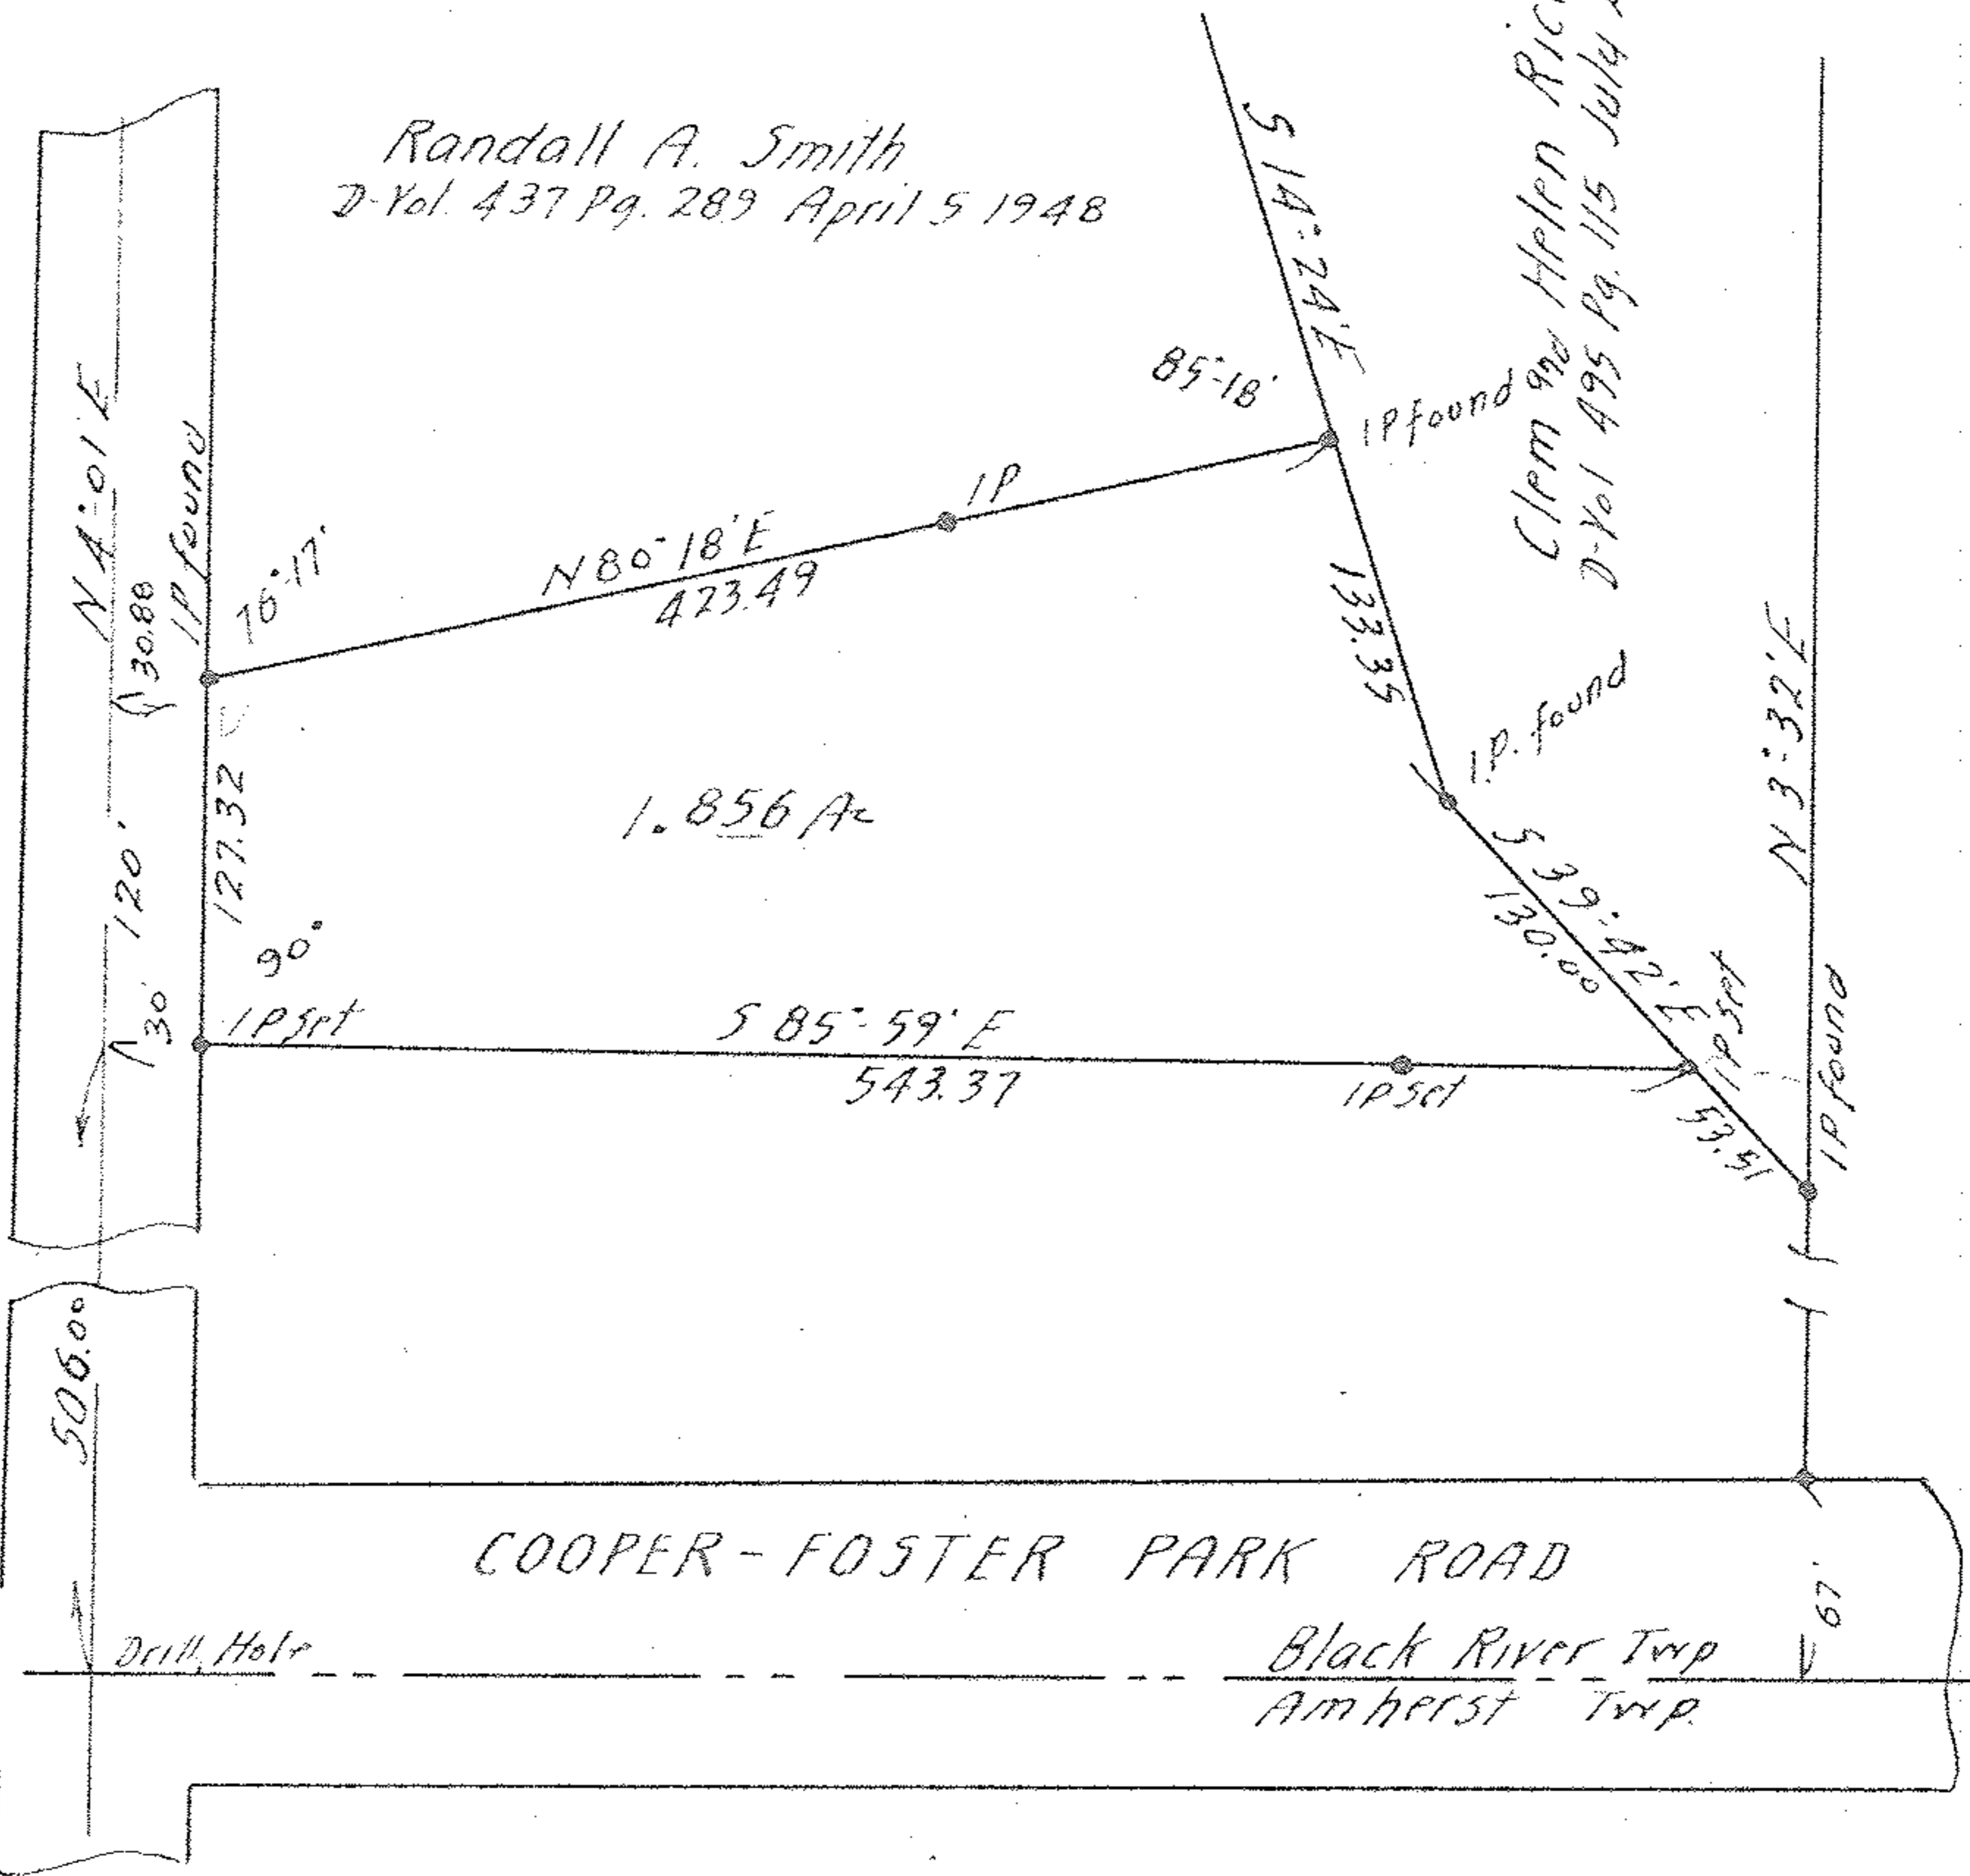

COOPER-FOSTER PARK ROAD

Drill Hole

Black River Twp
Amherst Twp.

Survey for
CHARLES and AMELIA LAPP
LOT 3 TRACT 2 BLACK RIVER TOWNSHIP
LORAIN COUNTY, OHIO
Scale 1" = 100' Oct. 29, 1951
J. W. WARDEN and ASSOCIATES, SURVEYOR'S