

# J. W. WARDEN & ASSOCIATES


CIVIL ENGINEERS AND SURVEYORS

D. D. ANDRUS, PRESIDENT  
405 ELYRIA BLOCK  
ELYRIA, OHIO

STATE OF OHIO  
REGISTERED } PROFESSIONAL ENG.  
SURVEYOR

TELEPHONES 3211  
42871

M. W. JACKSON  
SECRETARY

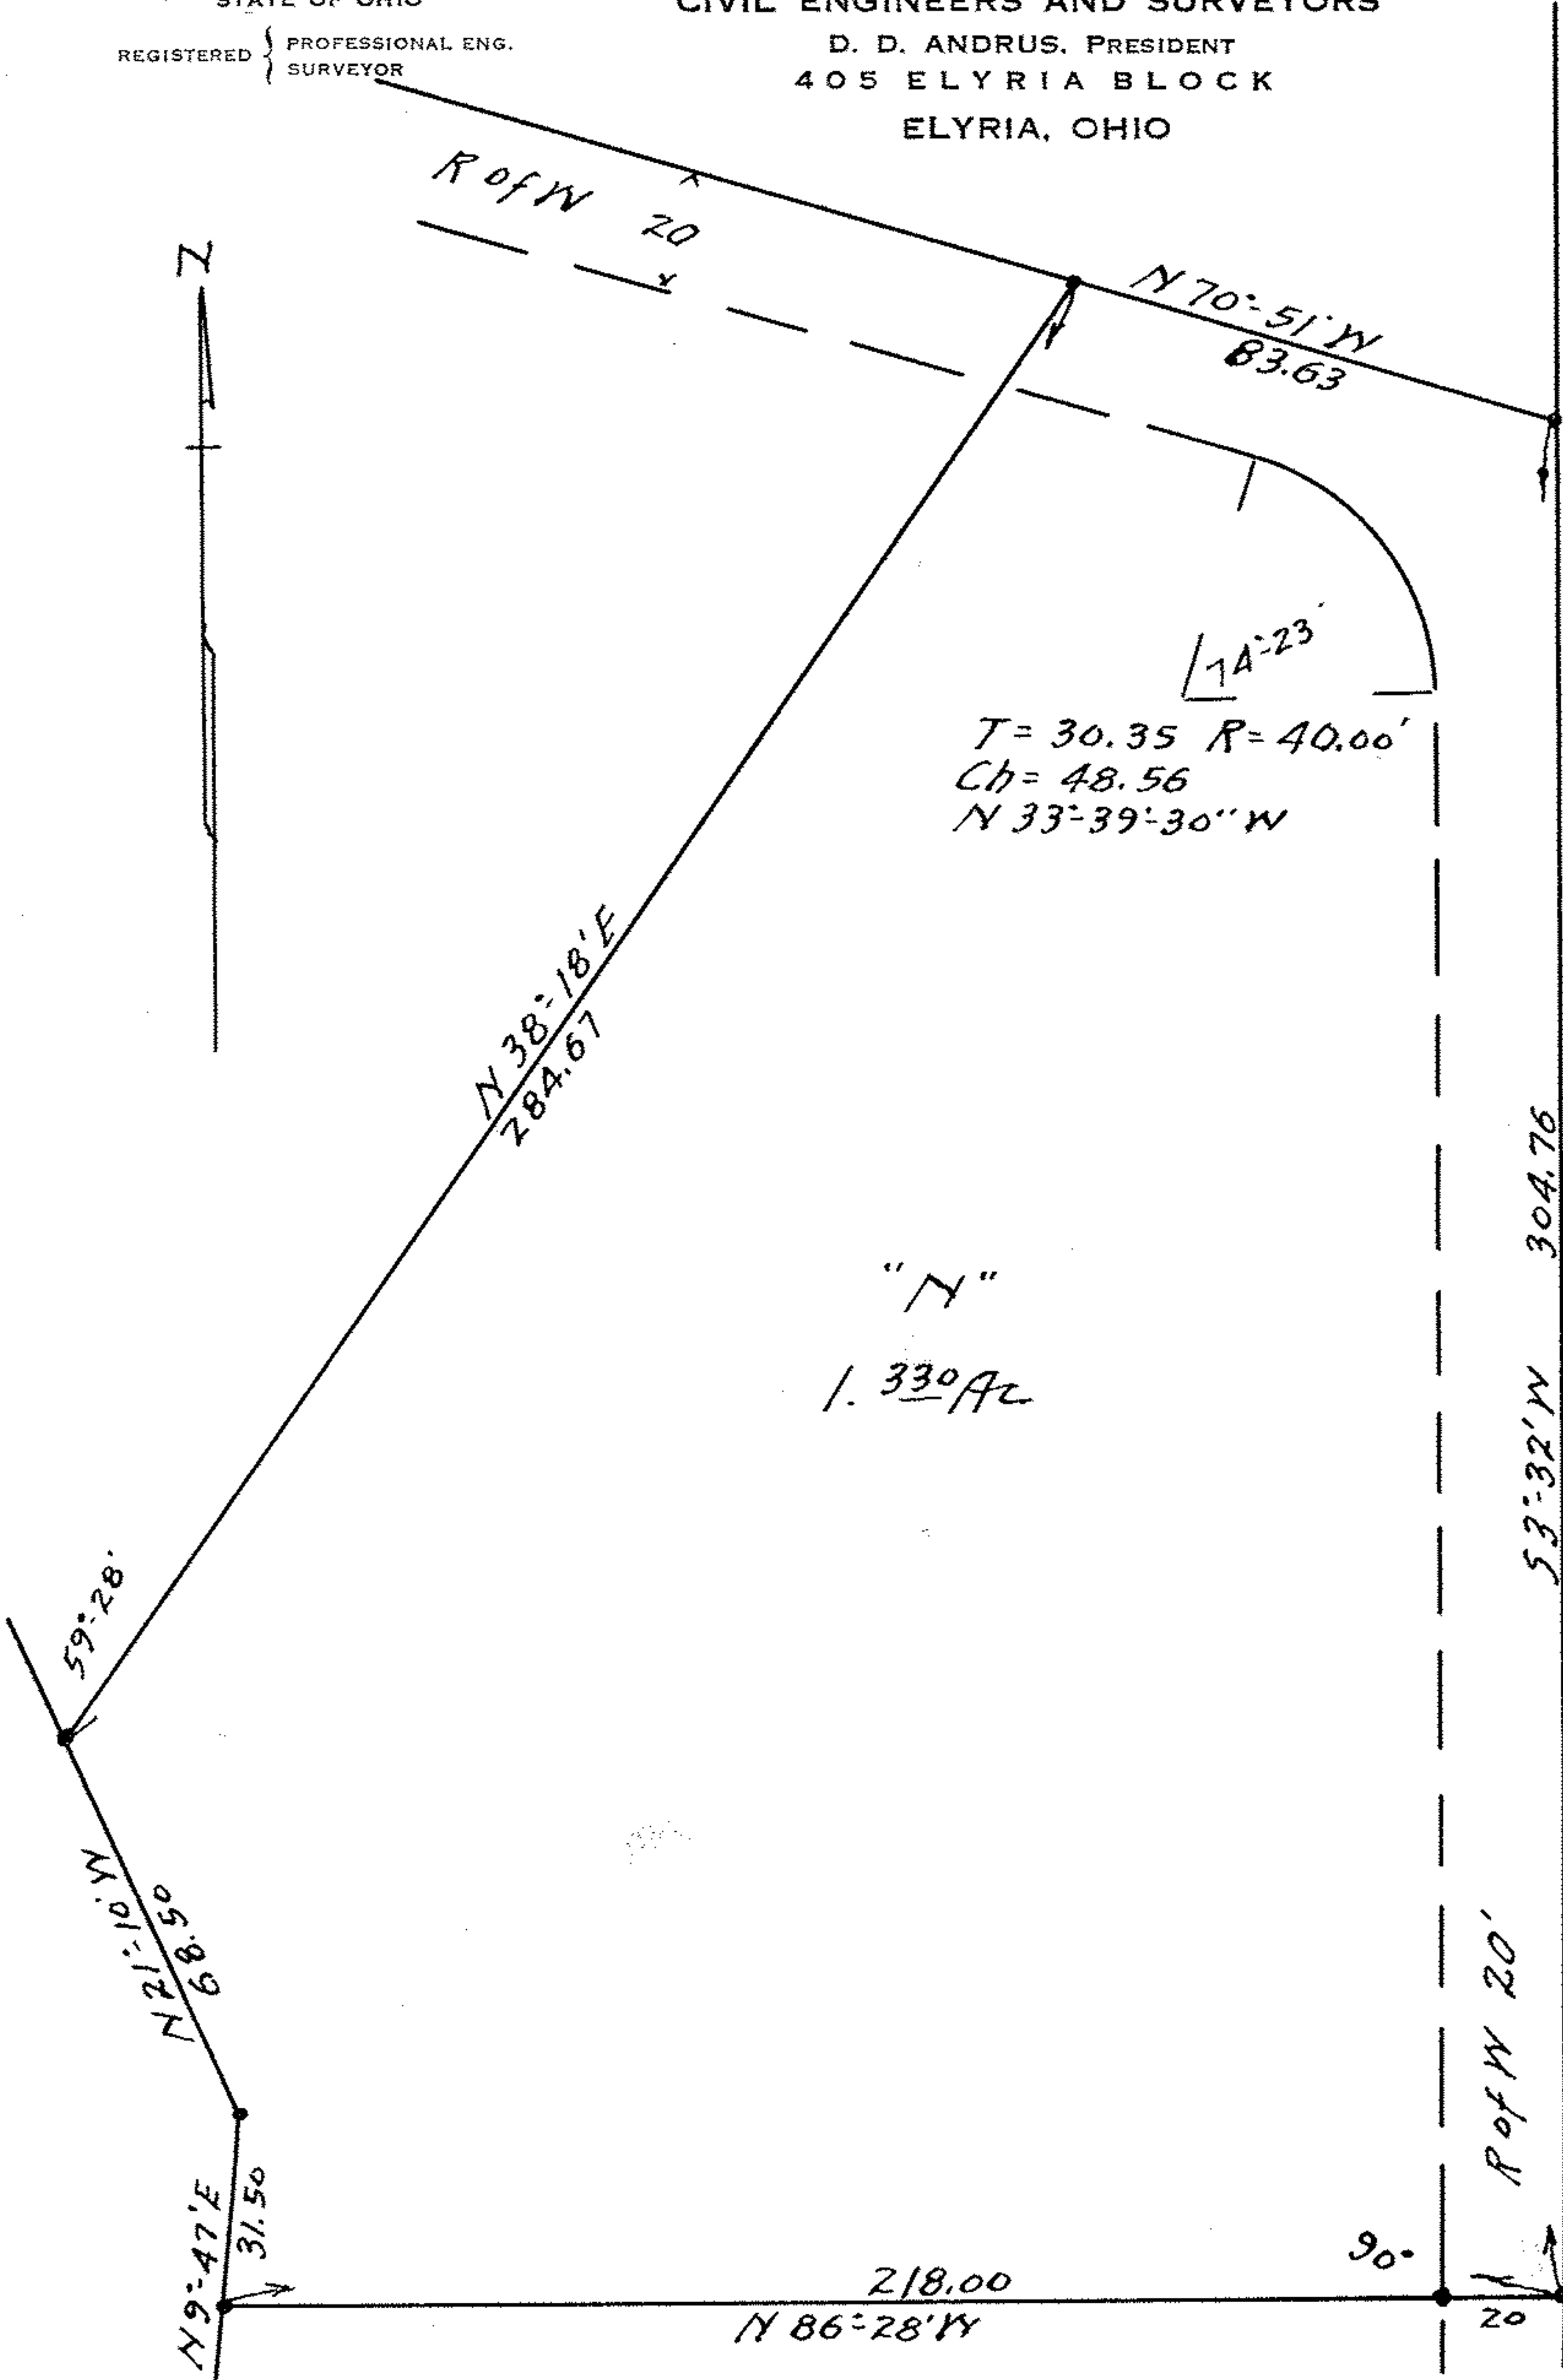

$T = 30.35$   $R = 40.00'$   
 $Ch = 48.56$   
 $N 33^{\circ} 39' 30'' W$

"N"  
1.330 AC

Charles 2nd Amelia Lapp. D-Vol 318 Pg. 416 March 26 1942

Survey for  
HELEN RICE  
Lot 3 Tract 2 Black River Township  
Lorain County Ohio.  
Scale 1" = 40' June 24, 1952.