

Benjamin Michael

Wm. A^{9d} Matilda E. Bauer
D-Vol. 403-Pg 438 Oct. 17, 1946.


12⁶⁶³ Acres

Edward & Janice E. Long
D-Vol 429-Pg 485 Dec. 13, 1947
4.802 A^c

28⁴¹³ Acres
East of $\frac{1}{2}$ Road

Chas. A. Mahr et al

Albert R. Lapp

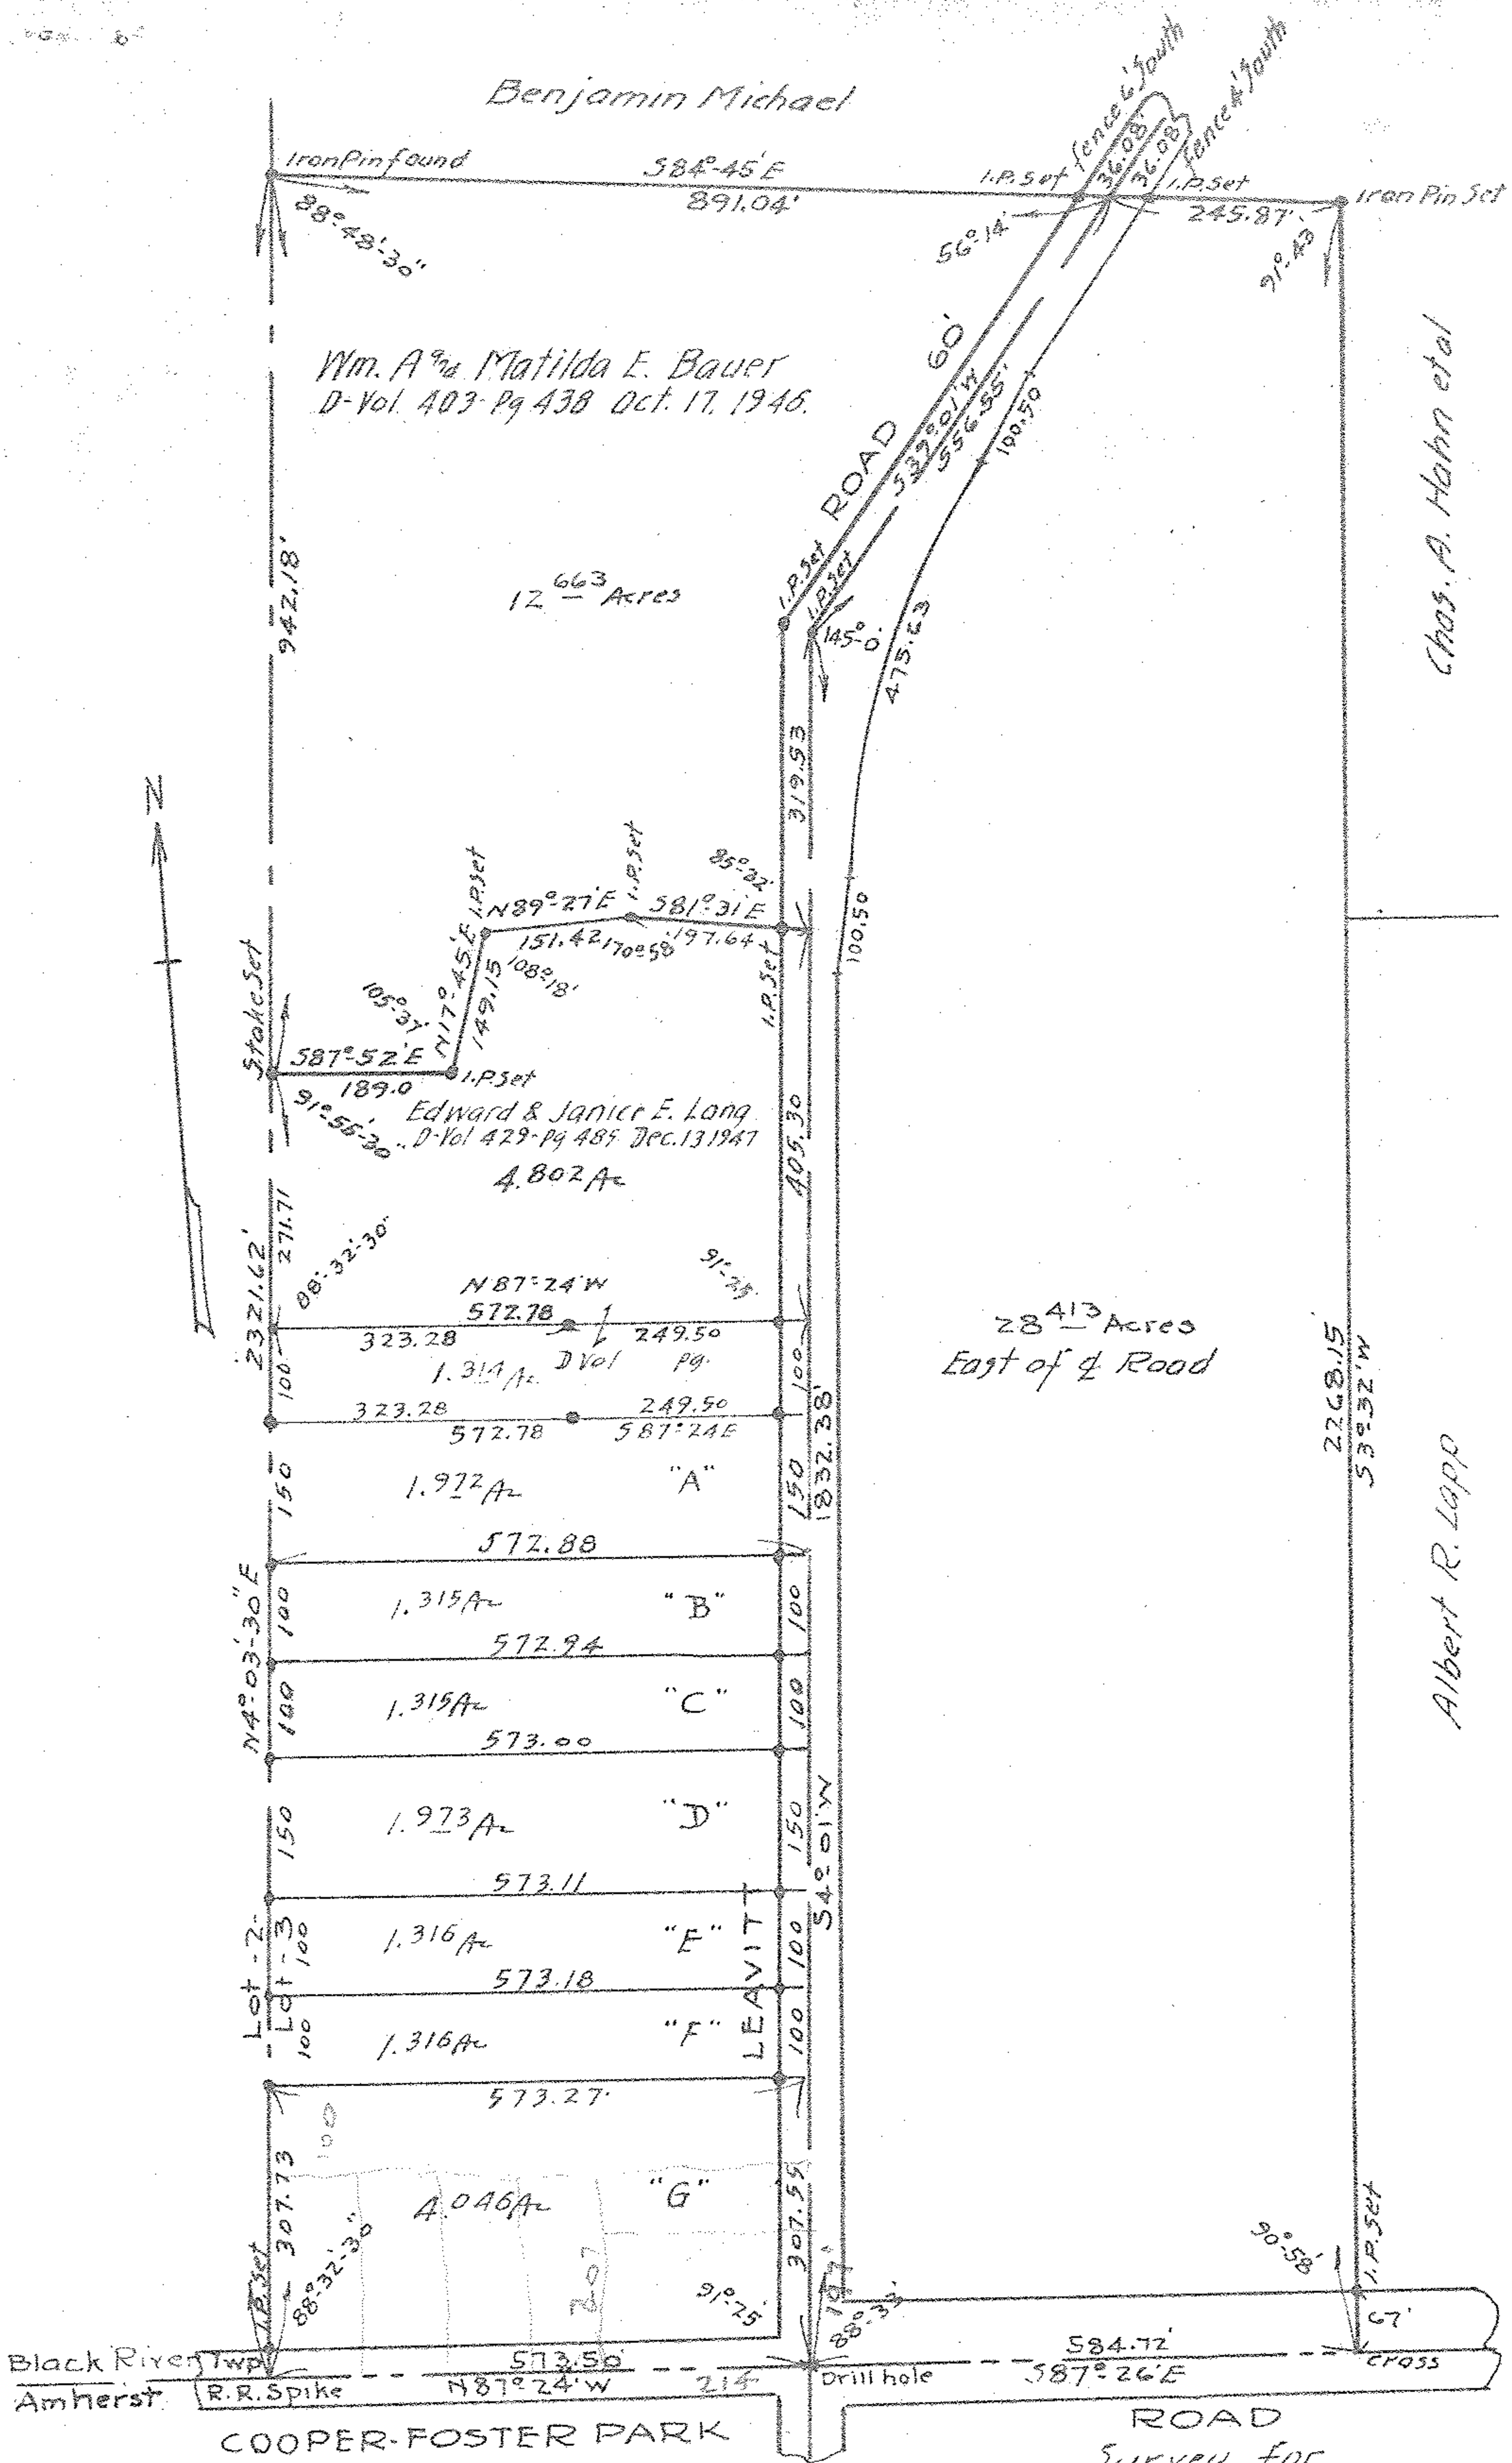

Survey for
Charles & Amelia Lapp.
Lot-3-Tract-2- Black River Twp.,
Lorain Co., Ohio.
Total Survey = 60.445 Acres.
Oct. 9-1942. Scale 1" = 200.
J. W. Warden, Registered Surveyor.
Revised Dec. 2, 1947. March 19, 1948

214
179
41