

JOHN W. WARDEN

CIVIL ENGINEER AND SURVEYOR

405 ELYRIA BLOCK

ELYRIA, OHIO

PHONES

BUSINESS 3211

RESIDENCE 38533

STATE OF OHIO

REGISTERED

PROFESSIONAL ENG.
SURVEYOR

Survey for
 Frank A. Nagel Est.
 D-Vol. 290 pg. 211 Nov. 20, 1937
 Sec. 22 Avon Village
 Laramie County Ohio
 Scale 1" = 50' June 22, 1943.

Ignatius F. Hartsman Bishop
 D-Vol. 82 pg. 478 March 31 1900.


John Eppich
 D-Vol 208 pg. 6 Oct. 9, 1924

Fred & Charlotte Ulmer
 D-Vol 320 pg. 25 April 23 1942.

Wm & Delphina Linden
 D-Vol- 234 pg. 123 Feb 6, 1928.

John Schober
 D-Vol. 279 pg. 425 Nov. 14, 1936

Gilbert J. Forthofer
 D-Vol 288 pg. 591 Jan. 26, 1938.

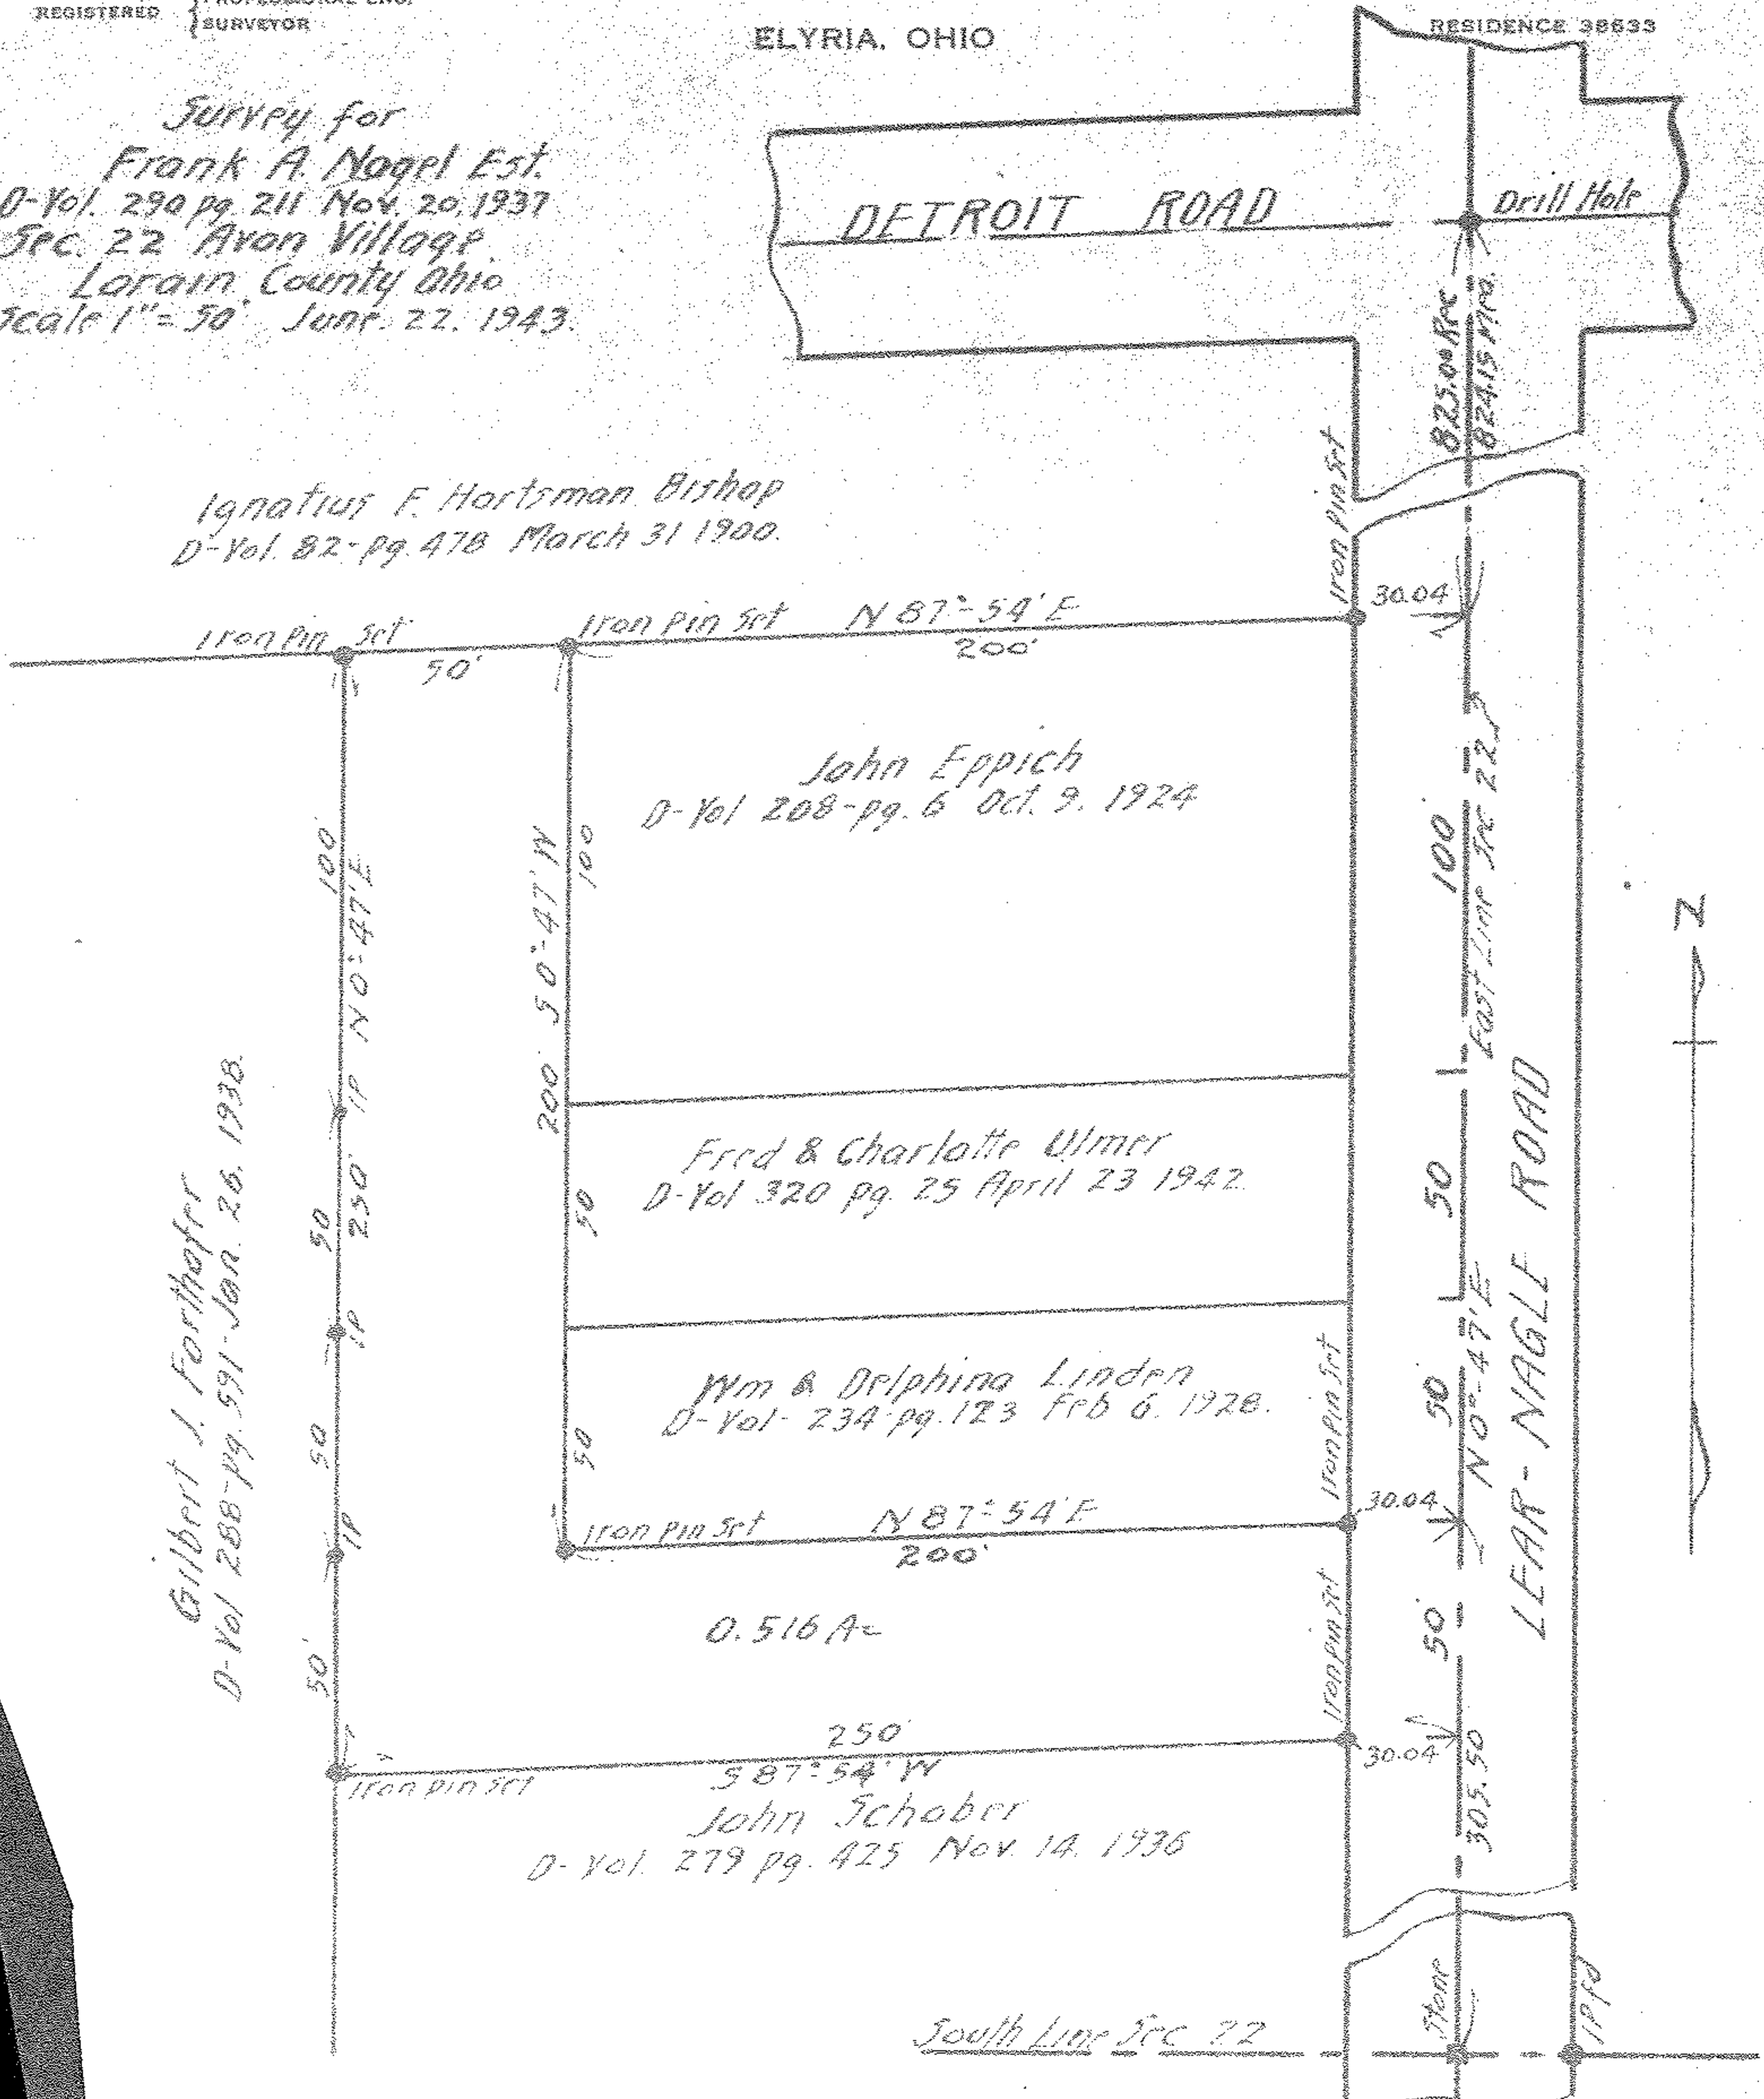

2