


Detail of change in property line
Scale 1" = 30'

PPN
04-00-027-103-???

map PG 04-00-027-E

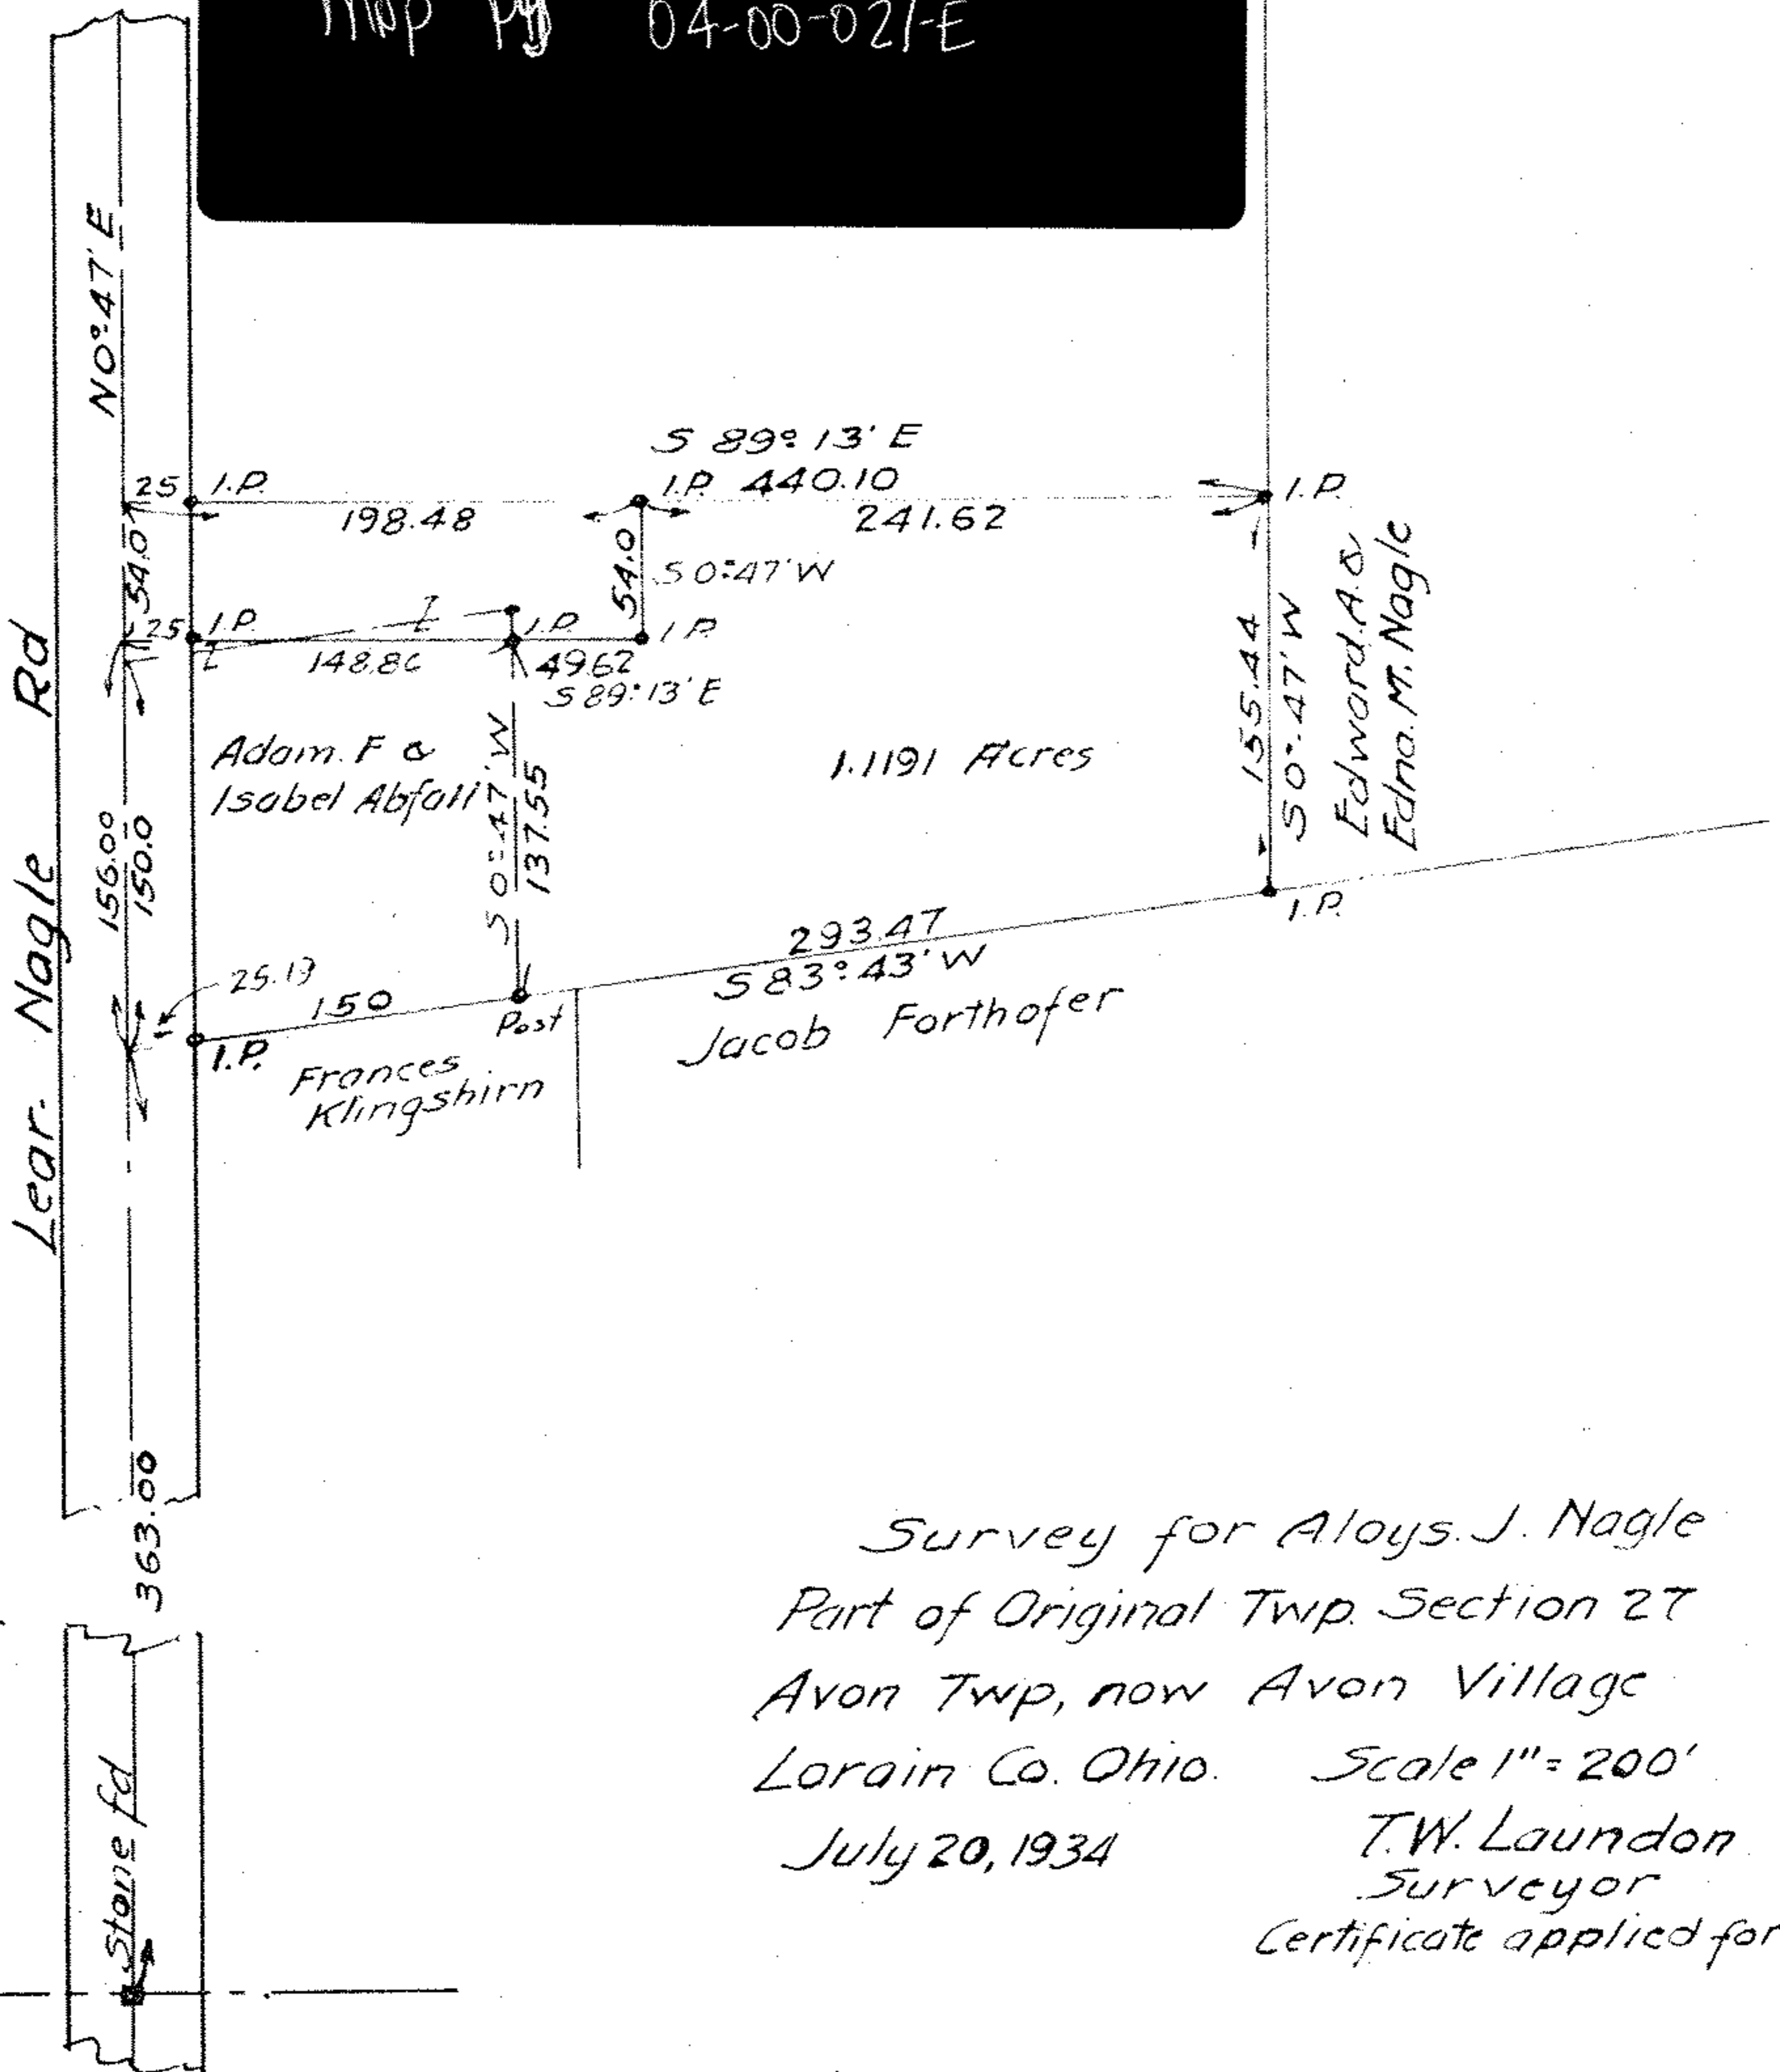

Survey for Aloys J. Nagle
Part of Original Twp. Section 27
Avon Twp, now Avon Village
Lorain Co. Ohio. Scale 1" = 200'
July 20, 1934
T.W. Laundon
Surveyor
Certificate applied for 1-1-34