


# JOHN W. WARDEN & ASSOCIATES

STATE OF OHIO  
REGISTERED } PROFESSIONAL ENG.  
SURVEYOR

CIVIL ENGINEERS AND SURVEYORS  
405 ELYRIA BLOCK

ELYRIA, OHIO

TELEPHONE 3211

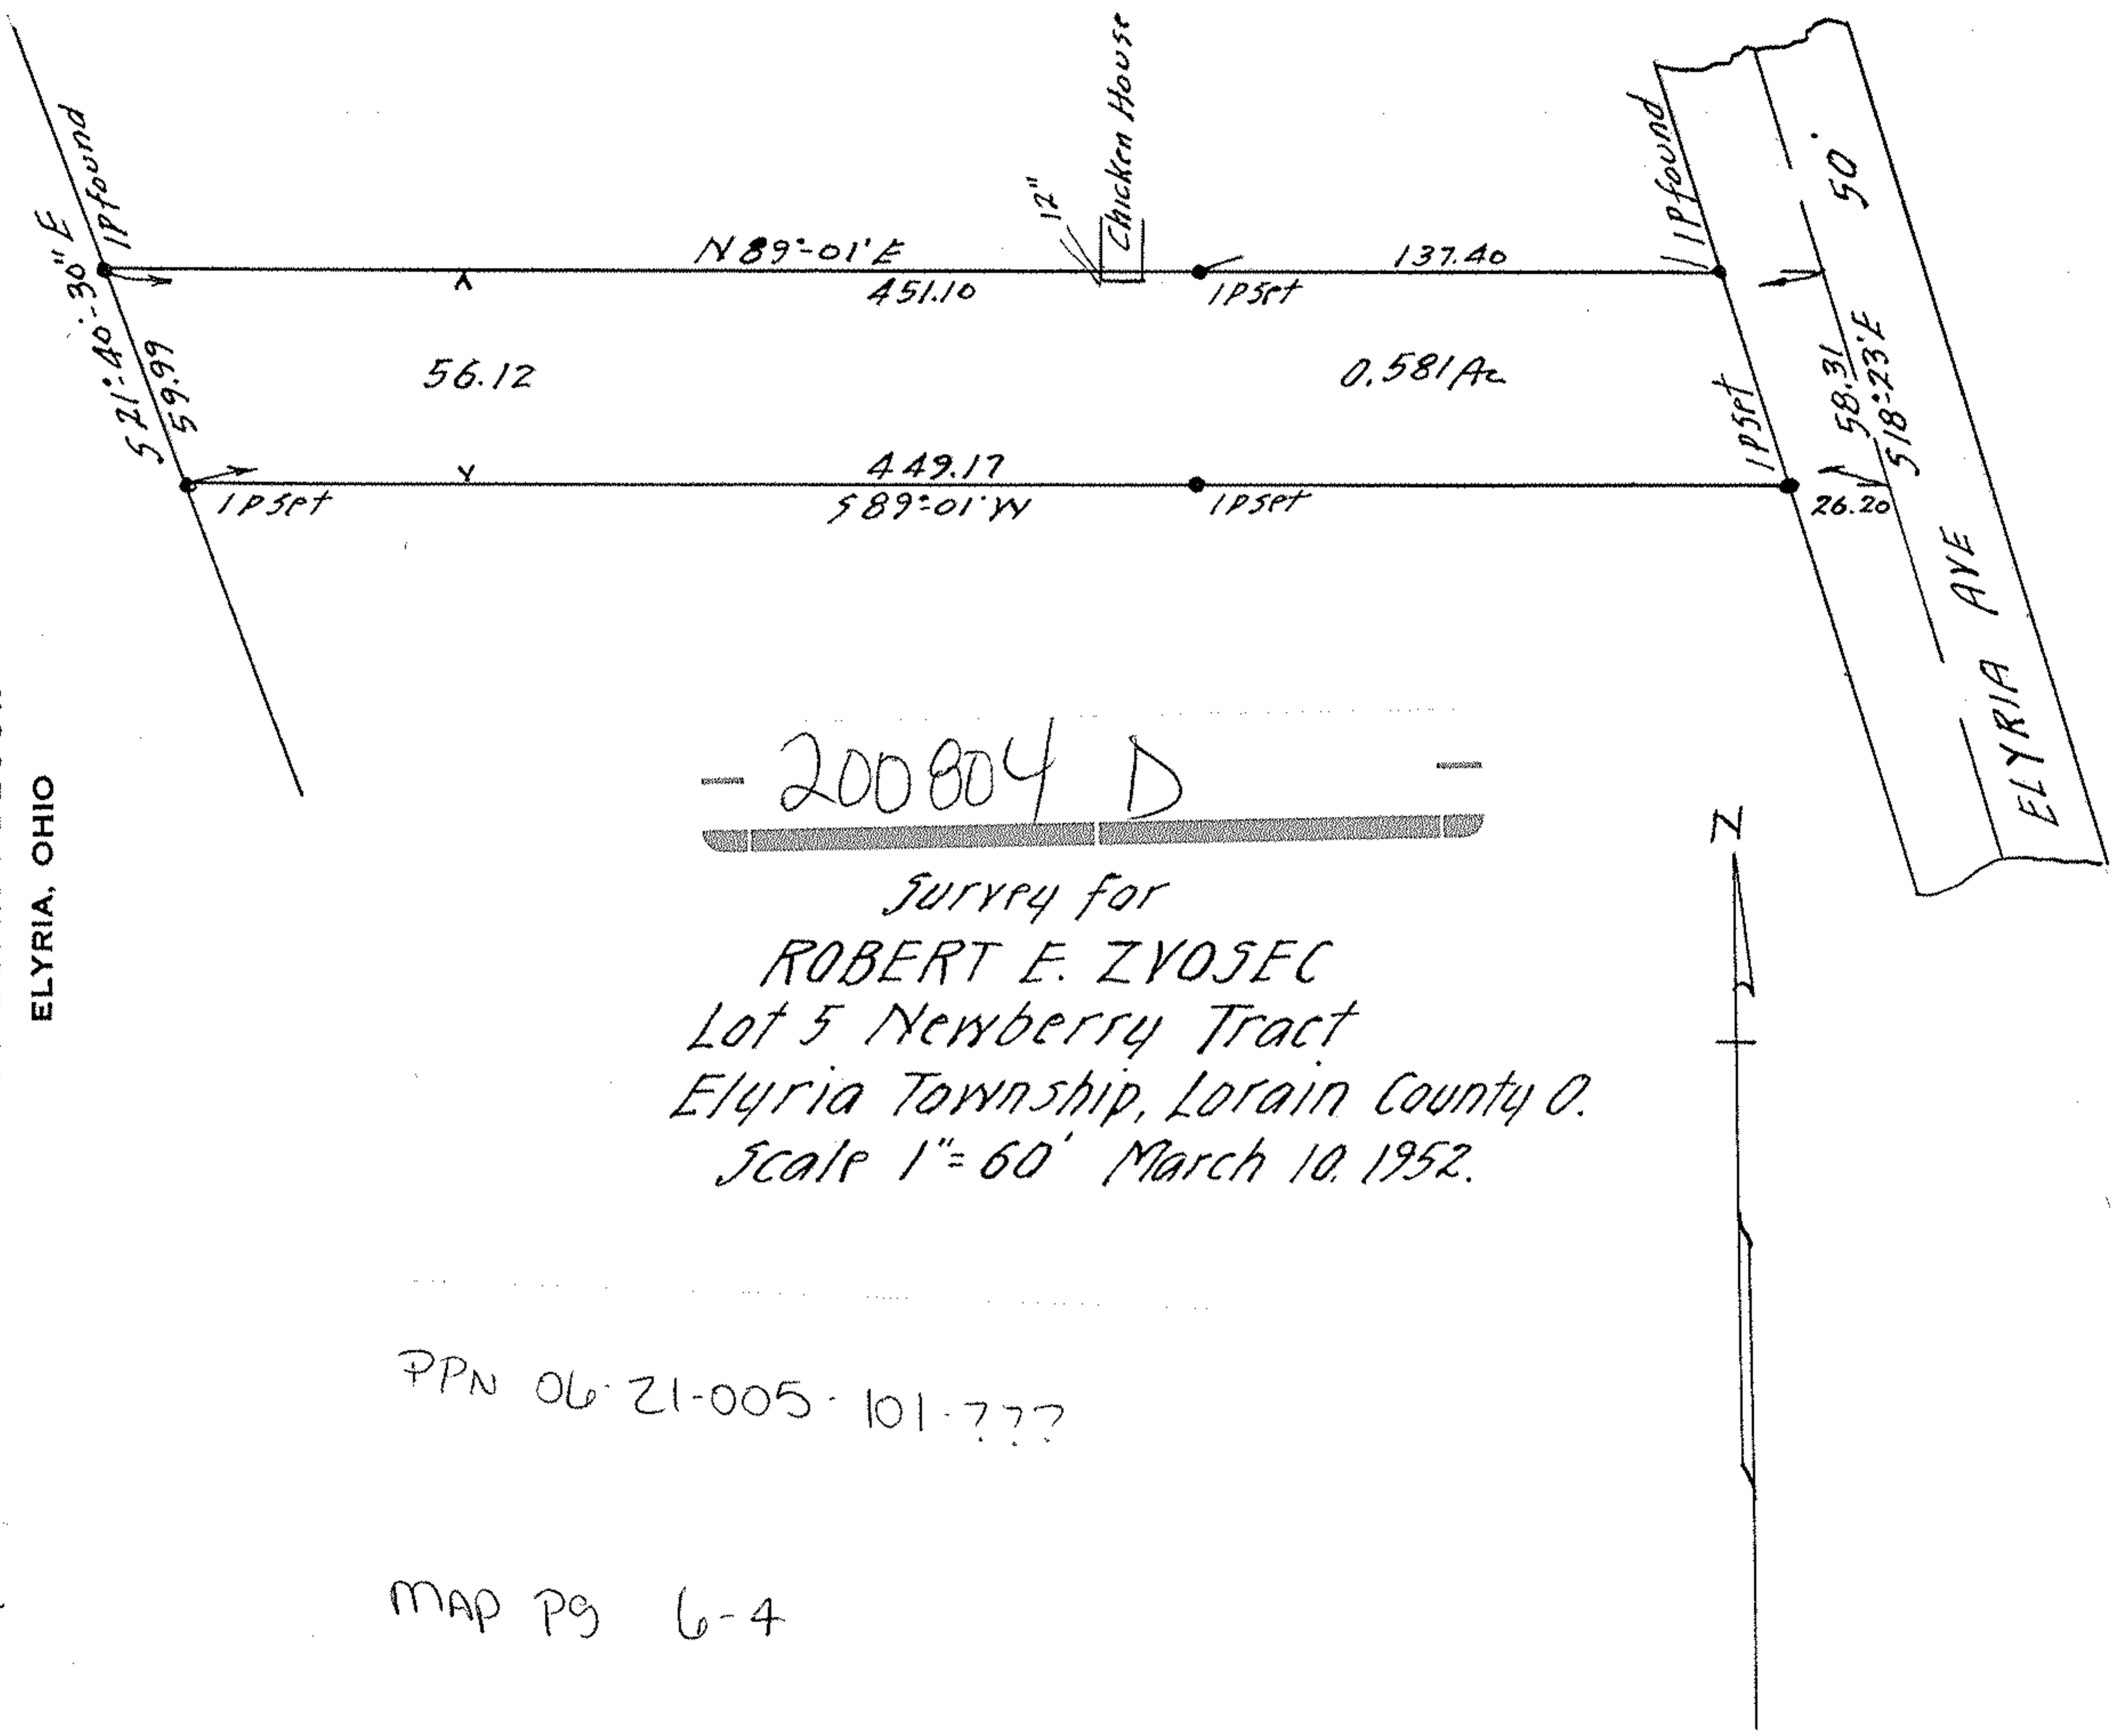

200804 D

SURVEY for  
ROBERT E. ZVOSEC  
Lot 5 Newberry Tract  
Elyria Township, Lorain County O.  
Scale 1" = 60' March 10, 1952.

PPN 06-21-005-101-777

MAP PG 6-4