

# J. W. WARDEN & ASSOCIATES

CIVIL ENGINEERS AND SURVEYORS

D. D. ANDRUS, PRESIDENT

405 ELYRIA BLOCK

ELYRIA, OHIO

STATE OF OHIO

REGISTERED { PROFESSIONAL ENG.  
SURVEYOR

TELEPHONES FA 2-9828

FA 2-1466


M. W. JACKSON  
SECRETARY

SURVEY FOR  
MARGARET M. PRICE  
D-VOL 417 PG 41 JAN 23, 1947  
SECTION 25 AVON VILLAGE  
LORAIN COUNTY, OHIO  
SCALE 1" = 60' AUG 28, 1961

Iron pins found or set at all  
points indicated thus ●

PPN 04-00-025 000-???

MAP PG 04-00-025-E

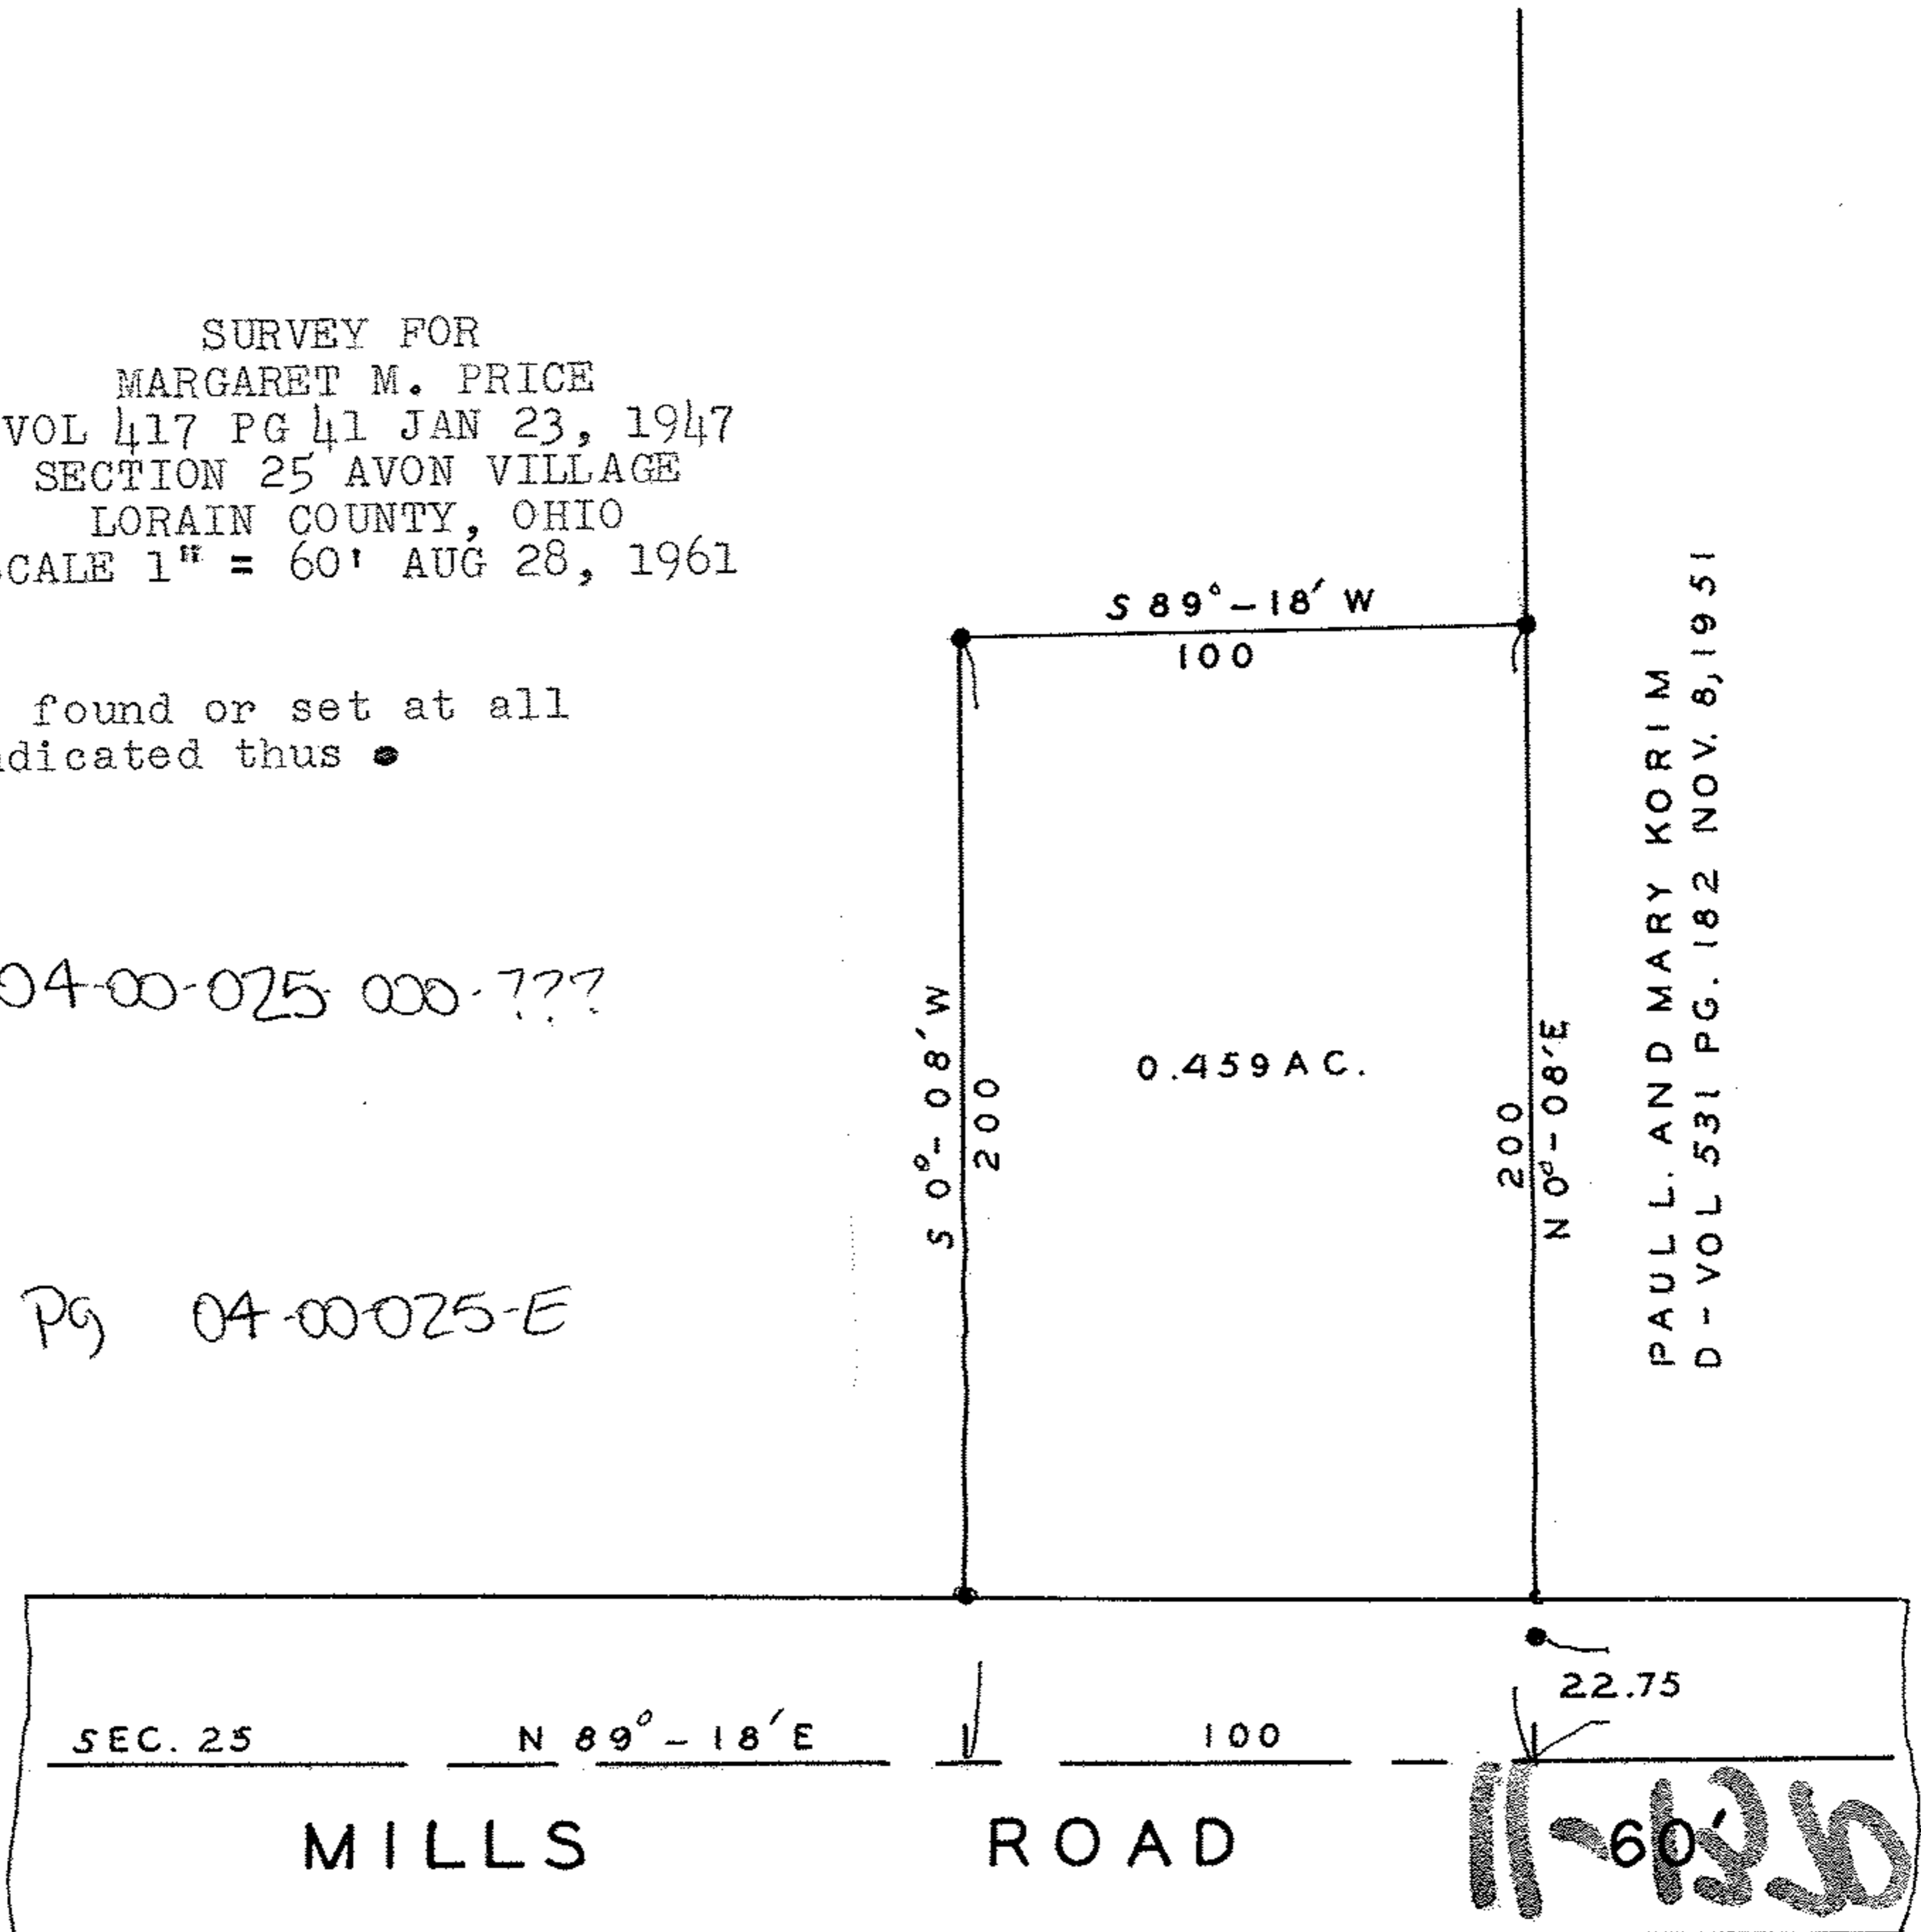

PAUL L. AND MARY KORIM  
D - VOL 531 PG. 182 NOV. 8, 1951

11-1370