

J. W. WARDEN & ASSOCIATES


CIVIL ENGINEERS AND SURVEYORS

D. D. ANDRUS, PRESIDENT
405 ELYRIA BLOCK
ELYRIA, OHIO

TELEPHONES 3211
42871

M. W. JACKSON
SECRETARY

STATE OF OHIO
REGISTERED } PROFESSIONAL ENG.
SURVEYOR

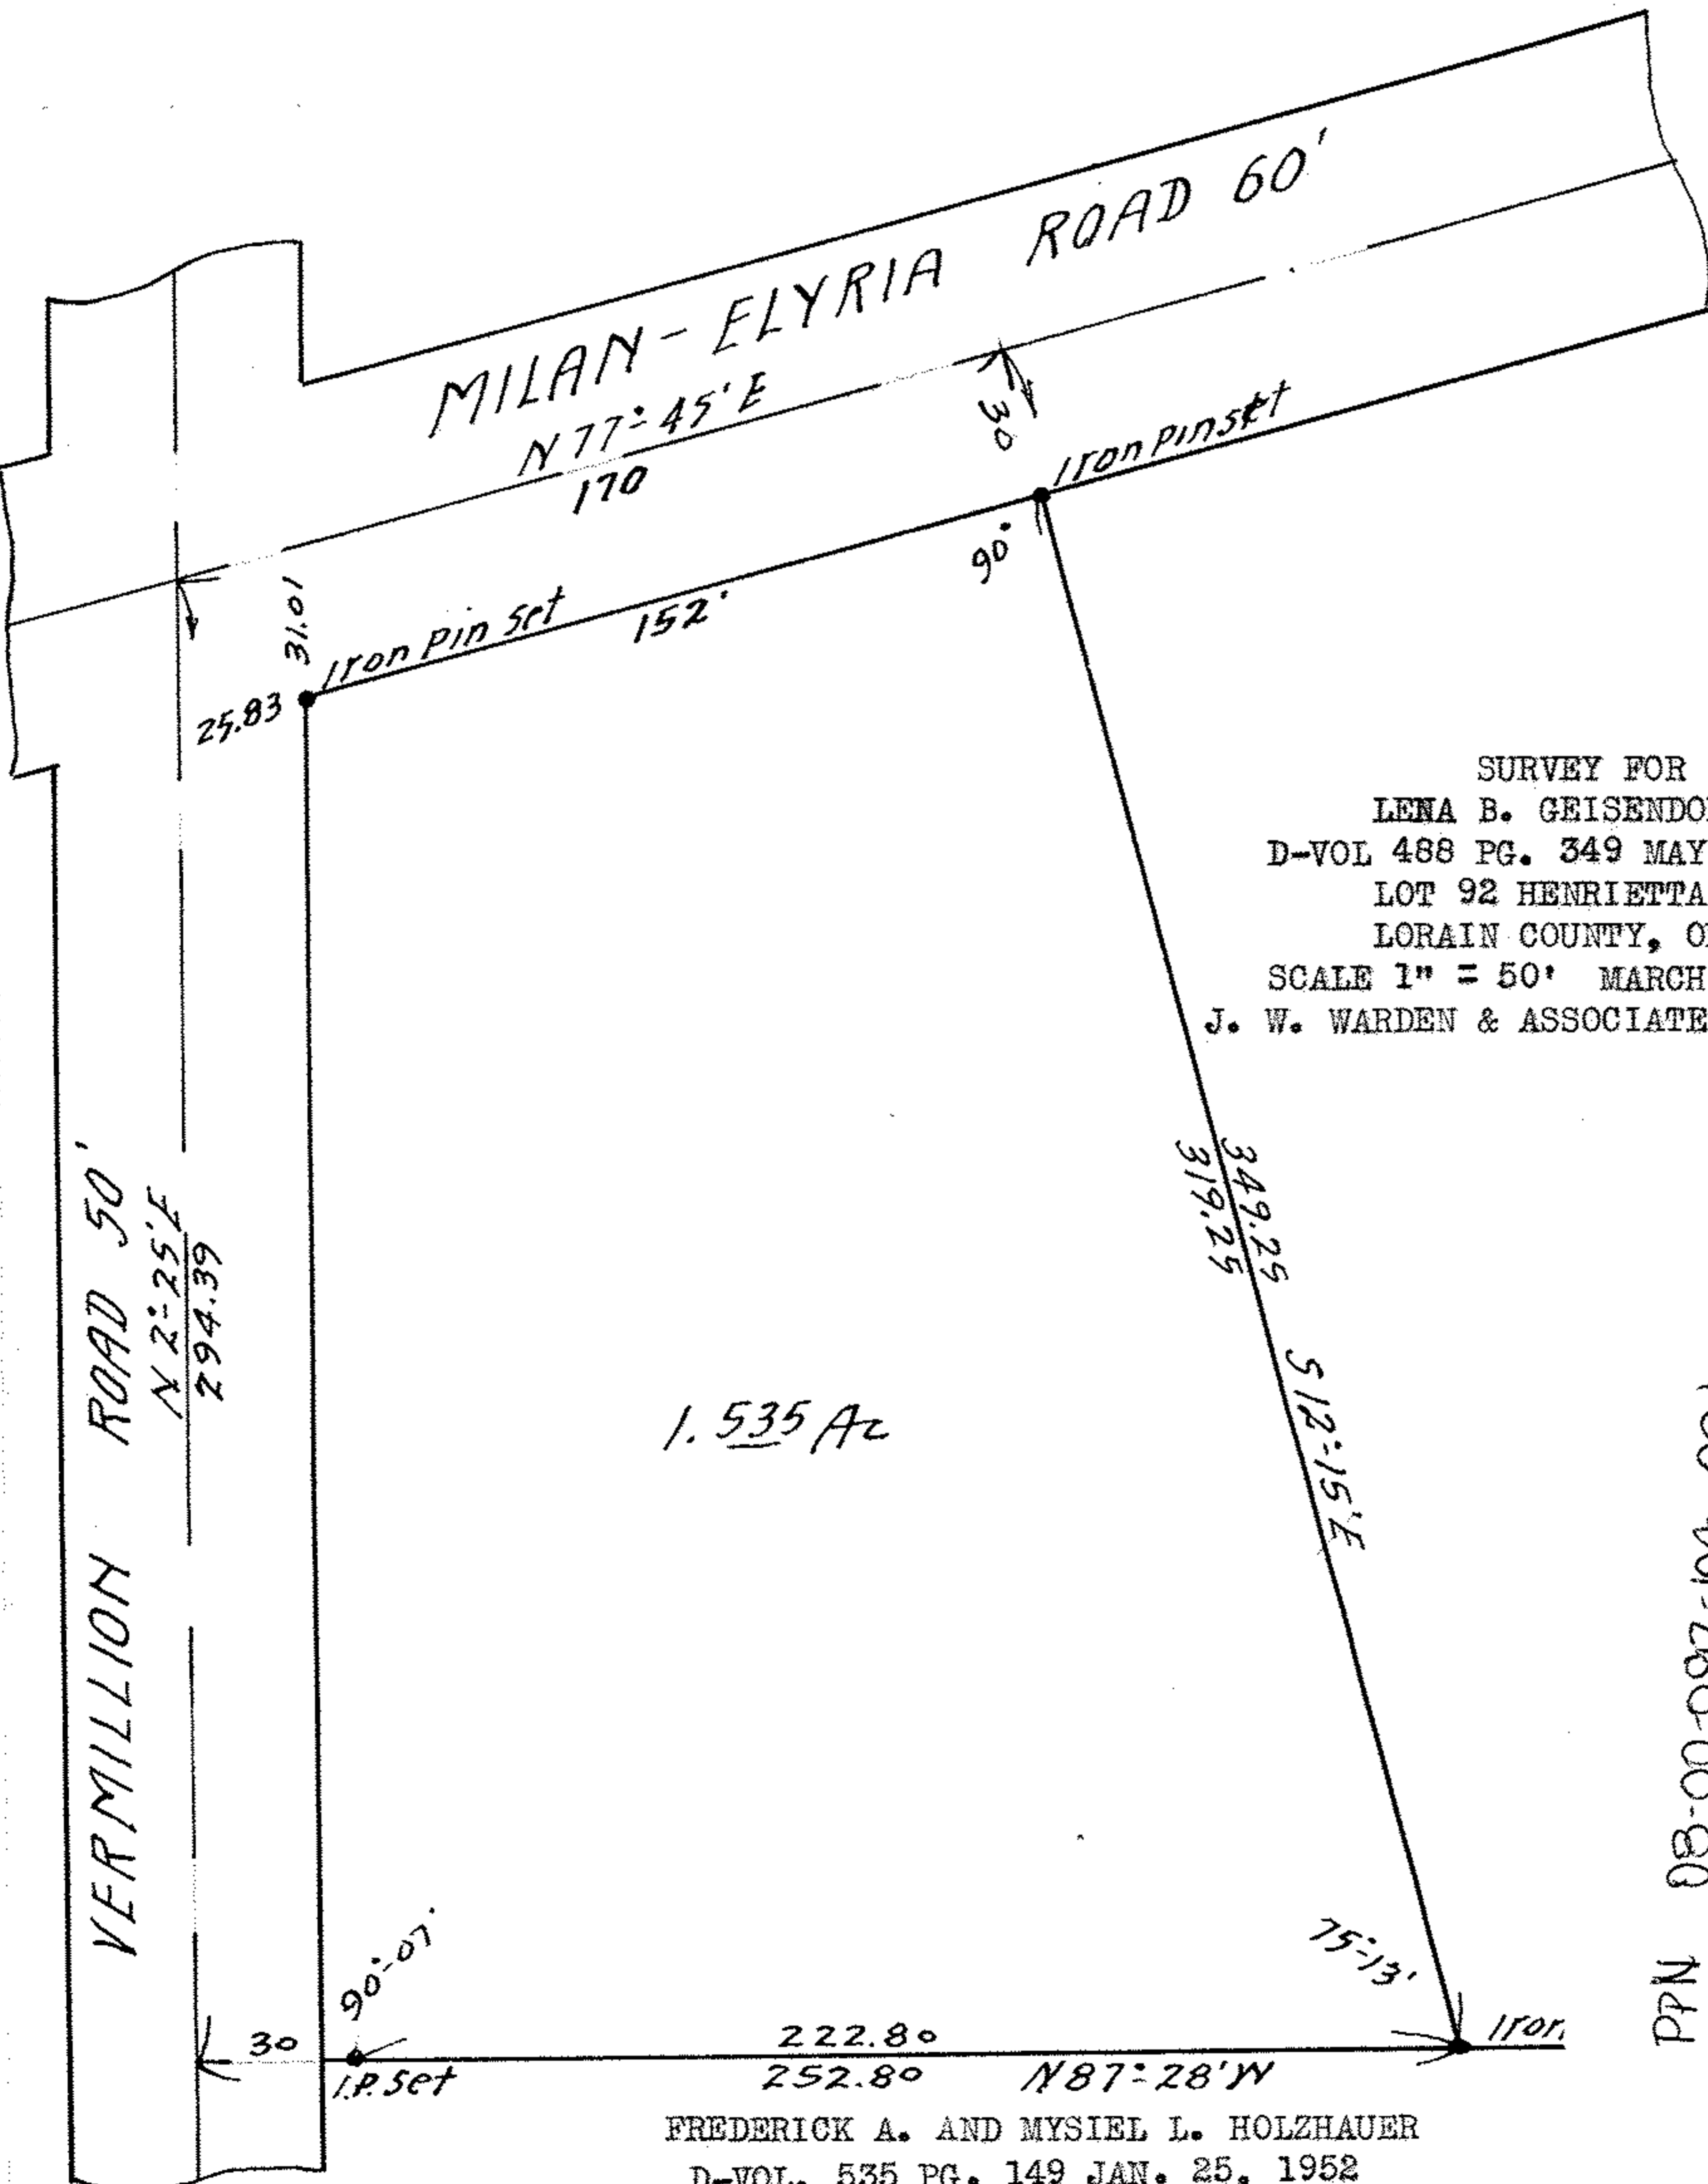

SURVEY FOR
 LENA B. GEISENDORFER
 D-VOL 488 PG. 349 MAY 17, 1950
 LOT 92 HENRIETTA TWP.
 LORAIN COUNTY, OHIO
 SCALE 1" = 50' MARCH 11, 1953
 J. W. WARDEN & ASSOCIATES REG. SURVEYOR'S

1.535 Ac

PPN 08-00-092-104-001

MAP P3 08-00-092-B

FREDERICK A. AND MYSIEL L. HOLZHAUER
D-VOL. 535 PG. 149 JAN. 25, 1952