

J. W. WARDEN & ASSOCIATES

CIVIL ENGINEERS AND SURVEYORS

D. D. ANDRUS, PRESIDENT
405 ELYRIA BLOCK

ELYRIA, OHIO


TELEPHONES 3211
42871

M. W. JACKSON
SECRETARY


STATE OF OHIO

REGISTERED } PROFESSIONAL ENG.
SURVEYOR

*Lena B. Geisendorfer D-Vol. 488 Pg. 349
May 17, 1950.*

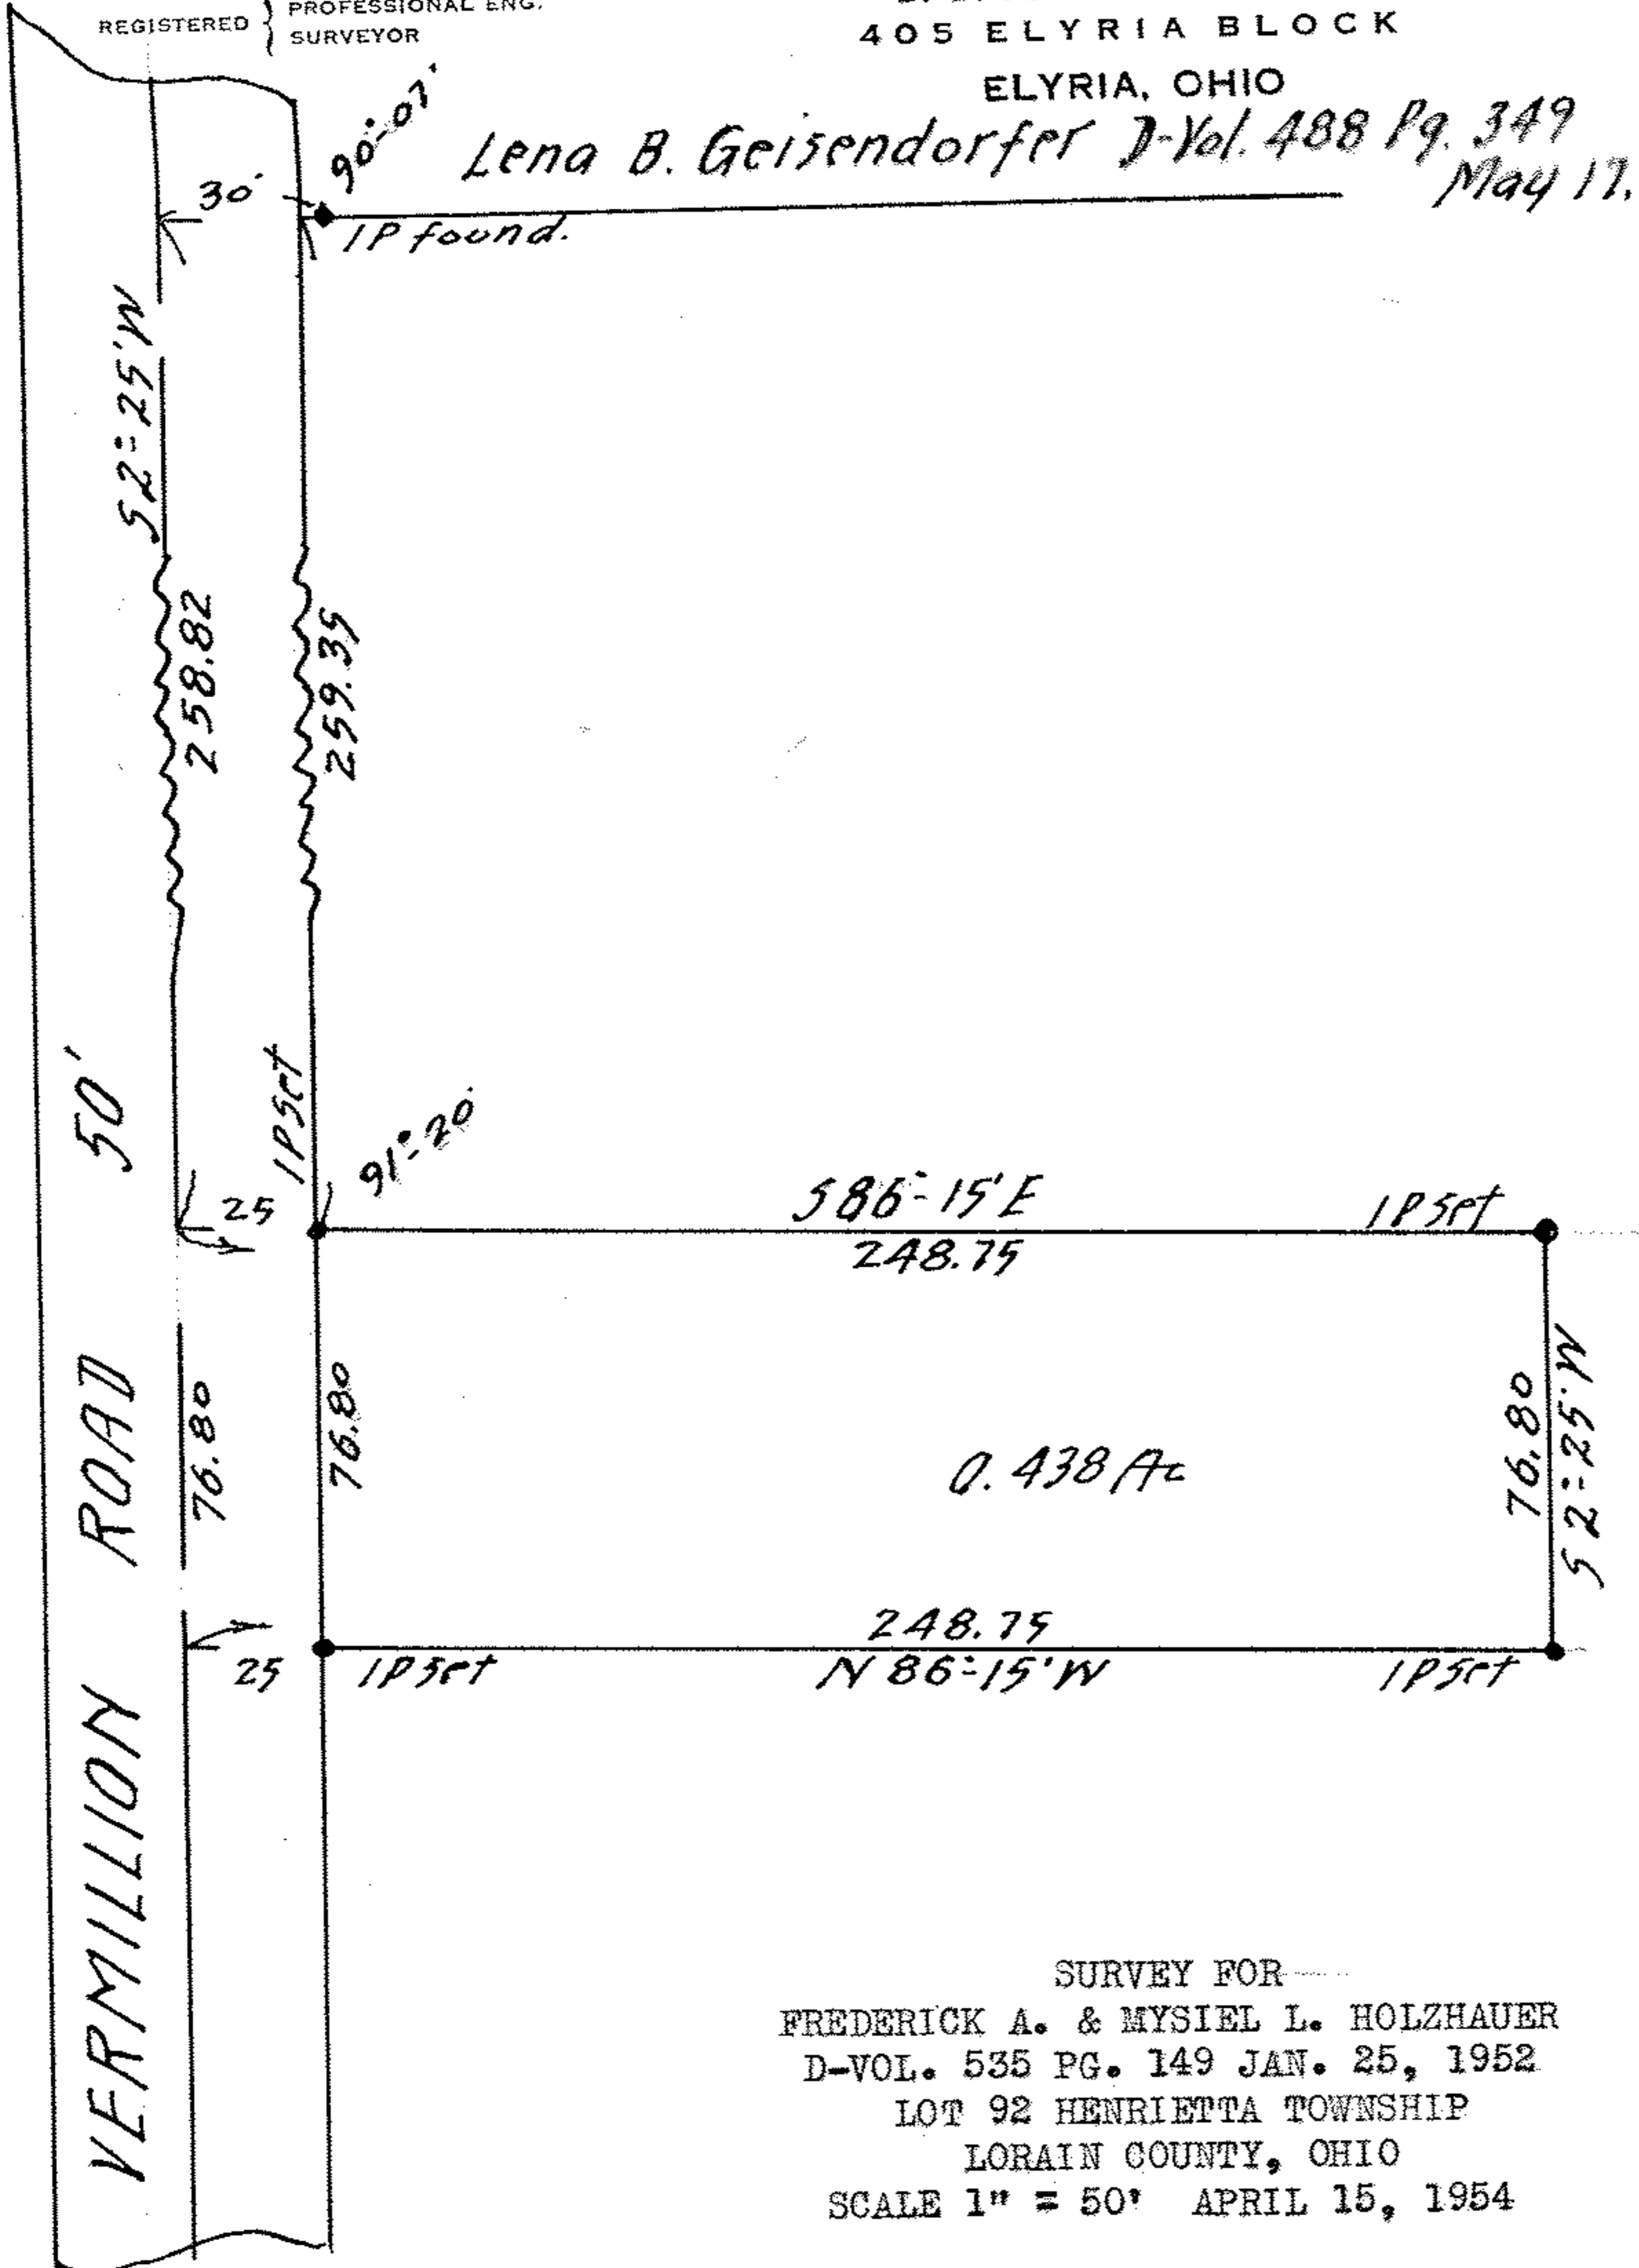

21-157-3

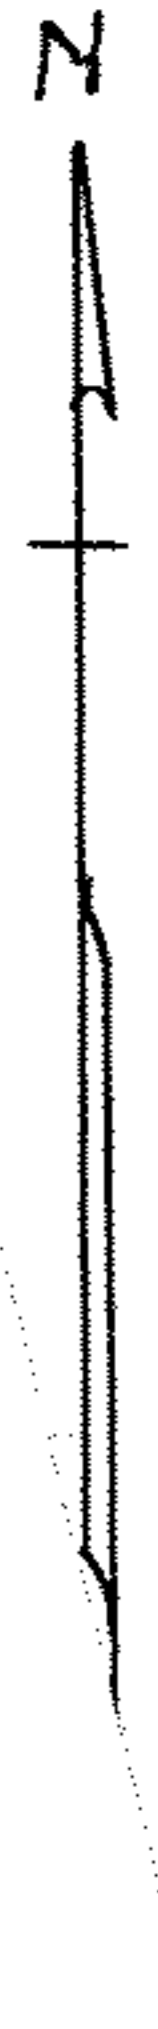

SURVEY FOR
FREDERICK A. & MYSIEL L. HOLZHAUER
D-VOL. 535 PG. 149 JAN. 25, 1952
LOT 92 HENRIETTA TOWNSHIP
LORAIN COUNTY, OHIO
SCALE 1" = 50' APRIL 15, 1954

PPN 08-00-092-104-003

MAP Pg 08-00-092-10