

PPN 07-00-008-???.???  
07-00-017-???.???

MAP PG 07-00-008-C  
017-D

LOT 17  
LOT 8

L.E. AND P. R/W 100'  
D-VOL. 97 PG. 98 JUNE 6, 1905  
S 65°-00'E  
627.0

114-29-30  
175ct  
219.60

EDWIN SNYDER BY WILL  
D-VOL. 537 PG. 327 1952  
N 0°-28'E 1667.00  
1703.02

5.762 LOT 8  
7.318 LOT 17  
13.080 TOTAL AC.


NIELS KJAER  
D-VOL. 339 PG. 570  
FEB. 16, 1945

21-1319-3

fence

fence

814.41  
1028.54

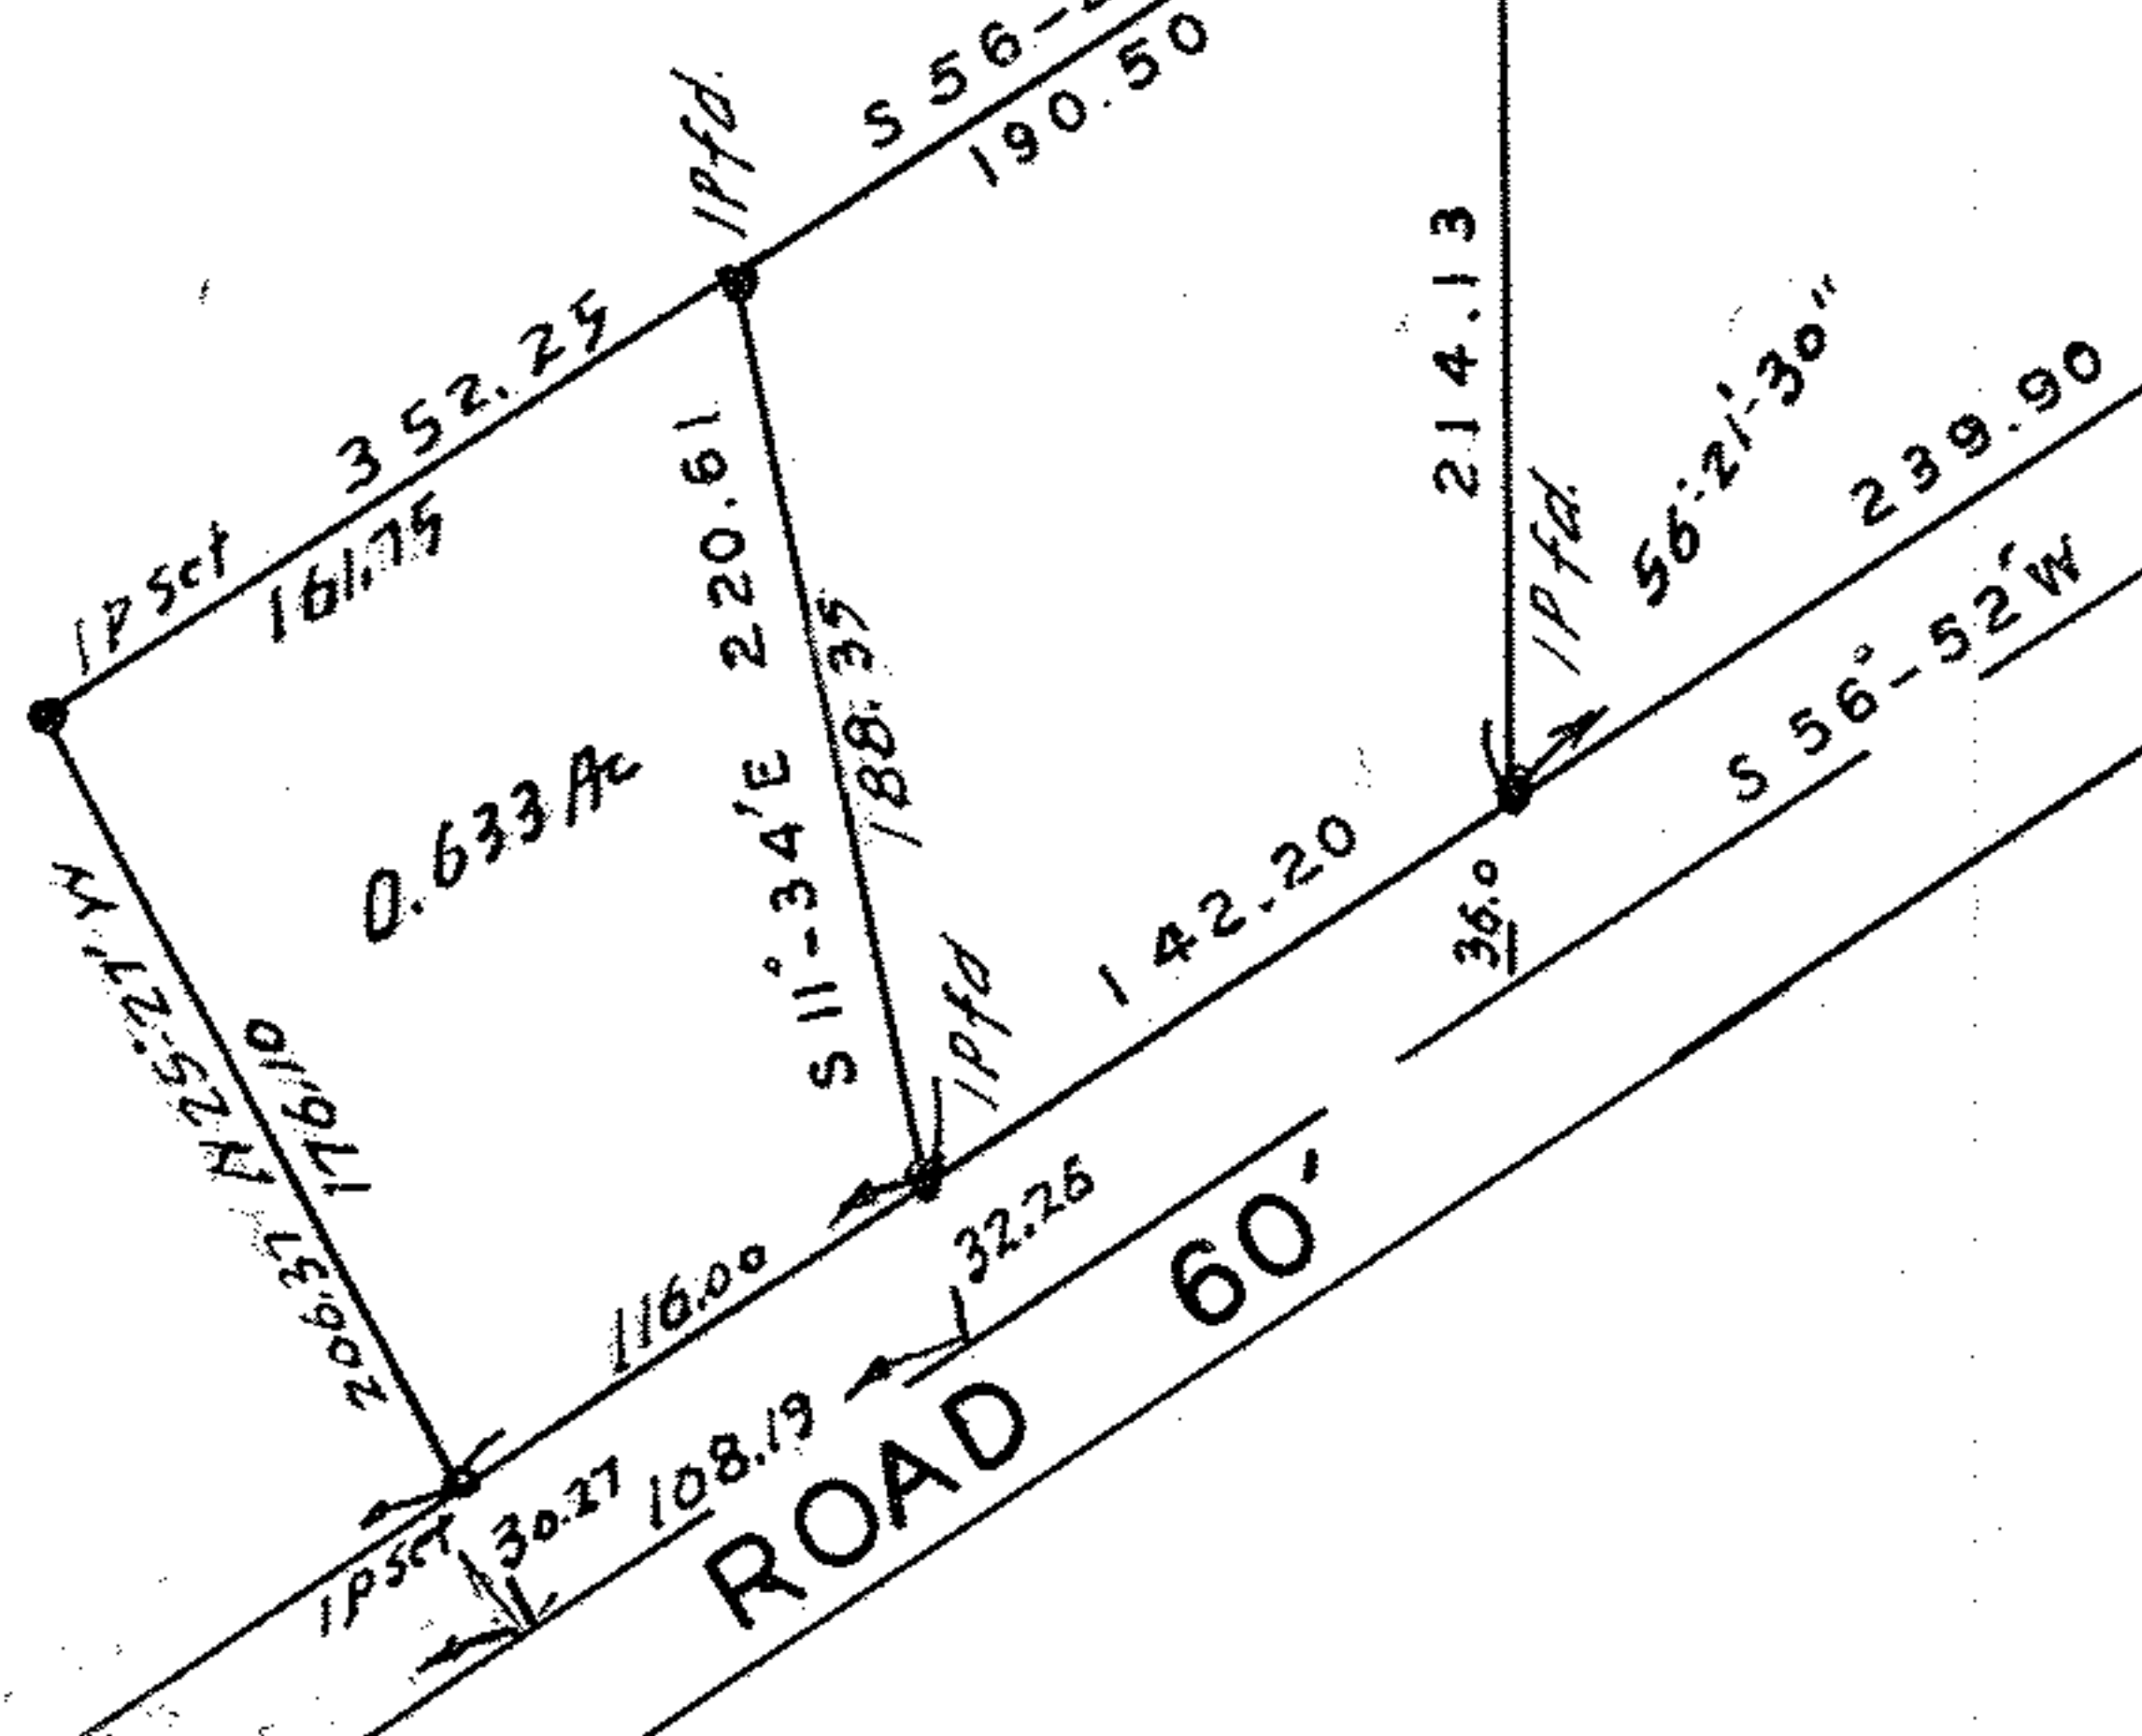

425.00  
440.88  
CLEVELAND ROAD 60'

SURVEY FOR  
**HARVEY RANDON**  
LOTS 8-17 RIDGEVILLE TOWNSHIP  
LORAIN COUNTY OHIO  
SCALE 1" = 100' SEPT. 28, 1959  
J.W. WARREN & ASSOCIATES REG. SURVEYORS

*D. D. Andrus*  
BY D. D. ANDRUS

Plat Revised for Ewald & Eula Dreger.  
D-Y 813 Pg. 79 Nov. 27, 1961 D. D. A. Aug. 26, 1965.