


PPN 05-00-015 000 072

MAP PG 05-00 015-A

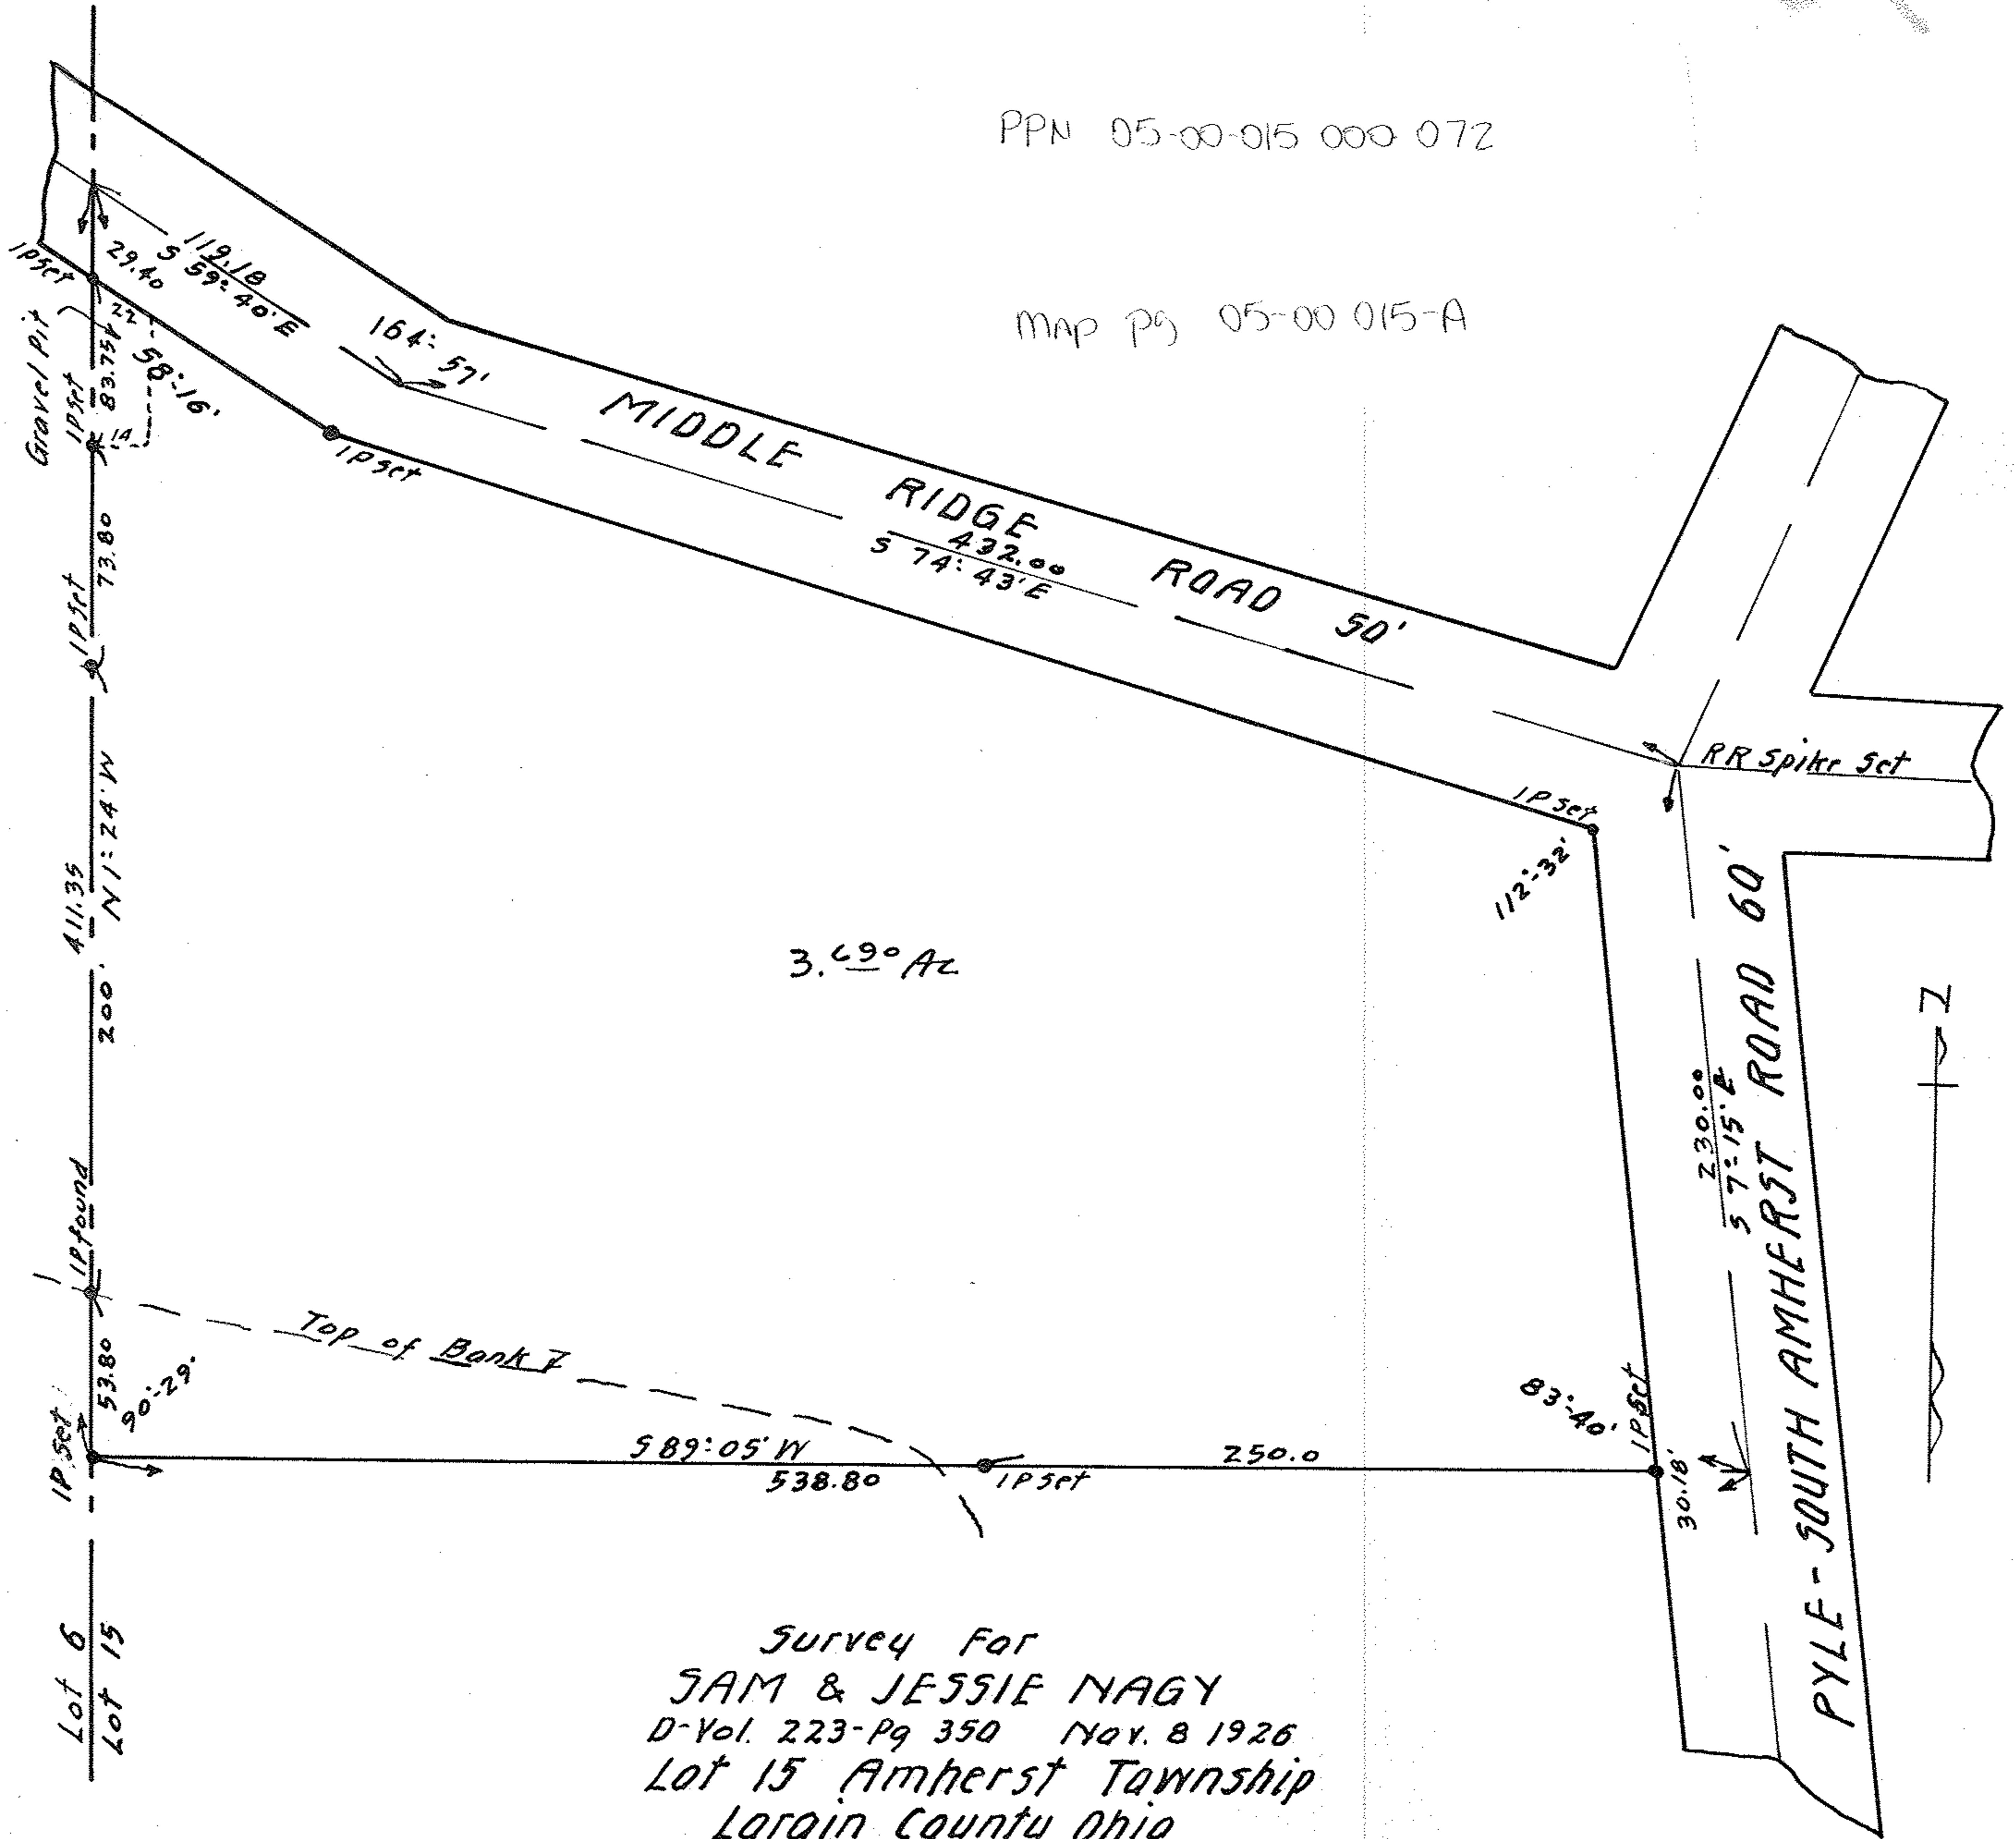

Survey for  
 SAM & JESSIE NAGY  
 D-Vol. 223-Pg 350 Nov. 8 1926  
 Lot 15 Amherst Township  
 Lorain County Ohio  
 Scale 1" = 60' Aug 2 1946  
 J. W. Warden, Registered Surveyor.