


16-1547-1

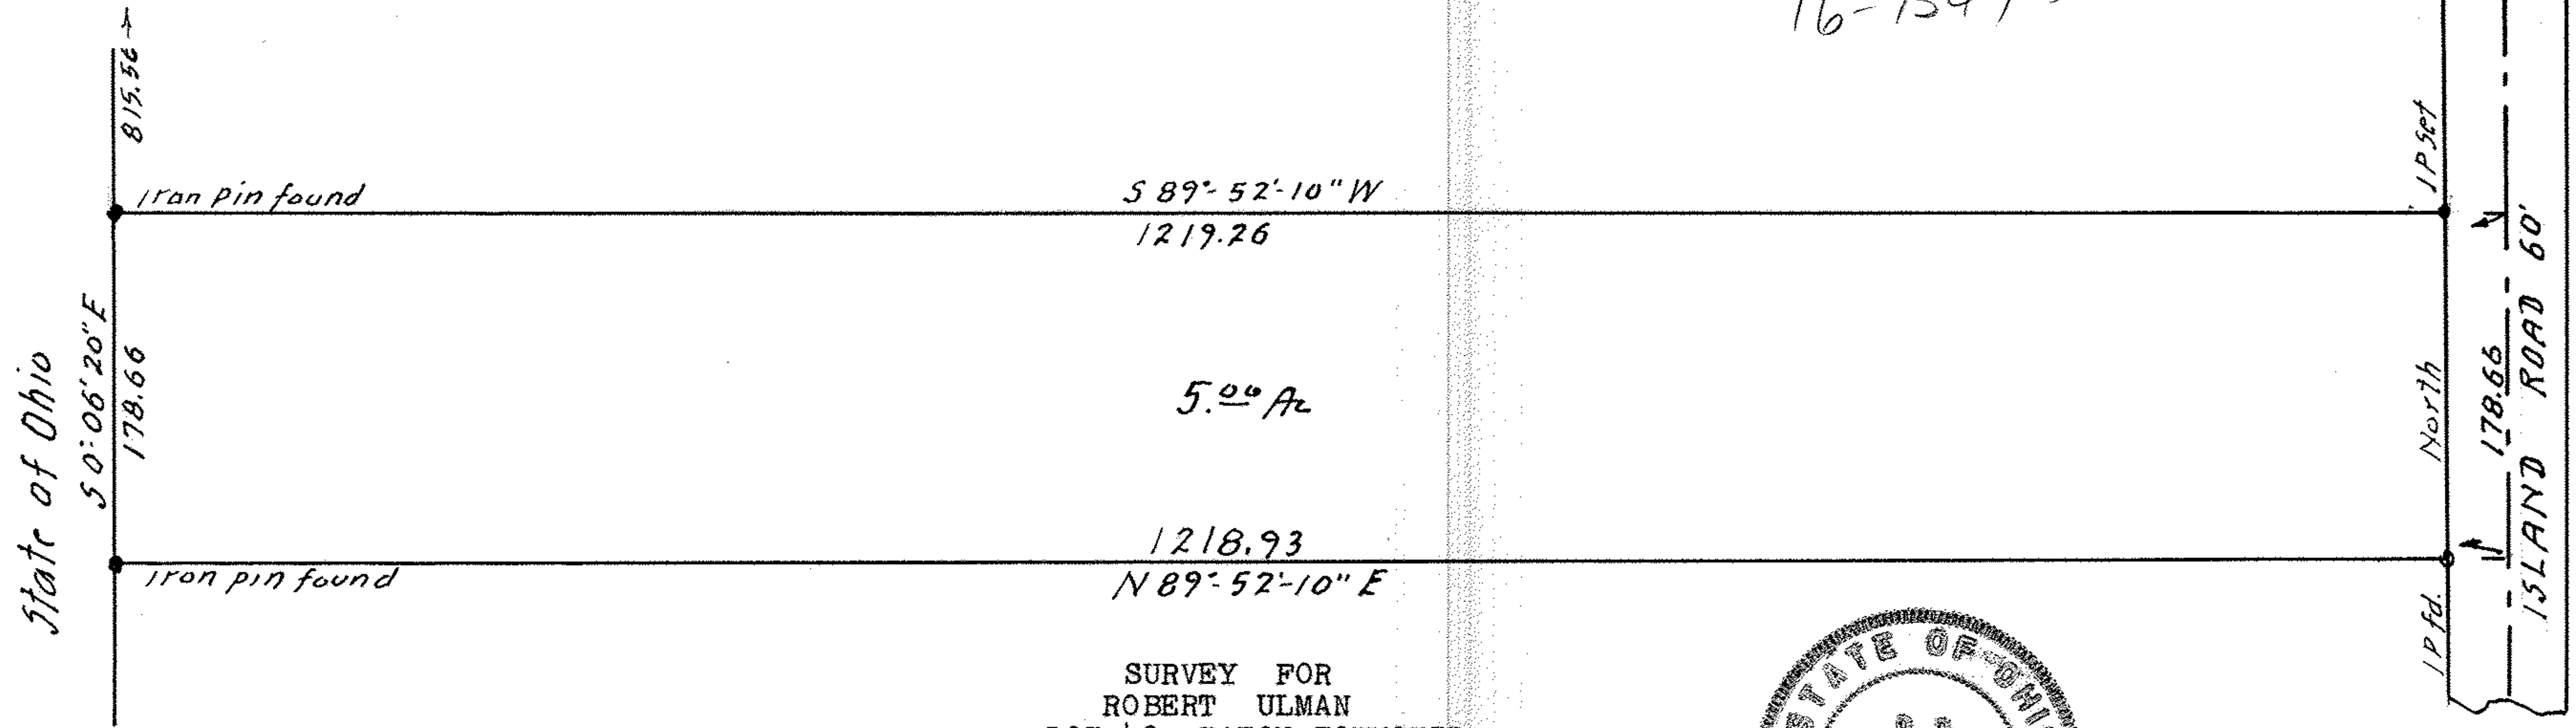

SURVEY FOR
 ROBERT ULMAN
 LOT 40 EATON TOWNSHIP
 LORAIN COUNTY OHIO.
 Scale 1" = 100' Nov. 23, 1968
 D.D. Andrus & Associates Reg. Sur.

