


Survey for
FREDA M. STEELE
 Lot 30 Amherst Township
 Lorain County Ohio.
 Scale 1" = 200' Oct. 23, 1947.
 J. W. Warden, Registered Surveyor.
 Iron stakes found or set at all points marked thus •

16-1037-2

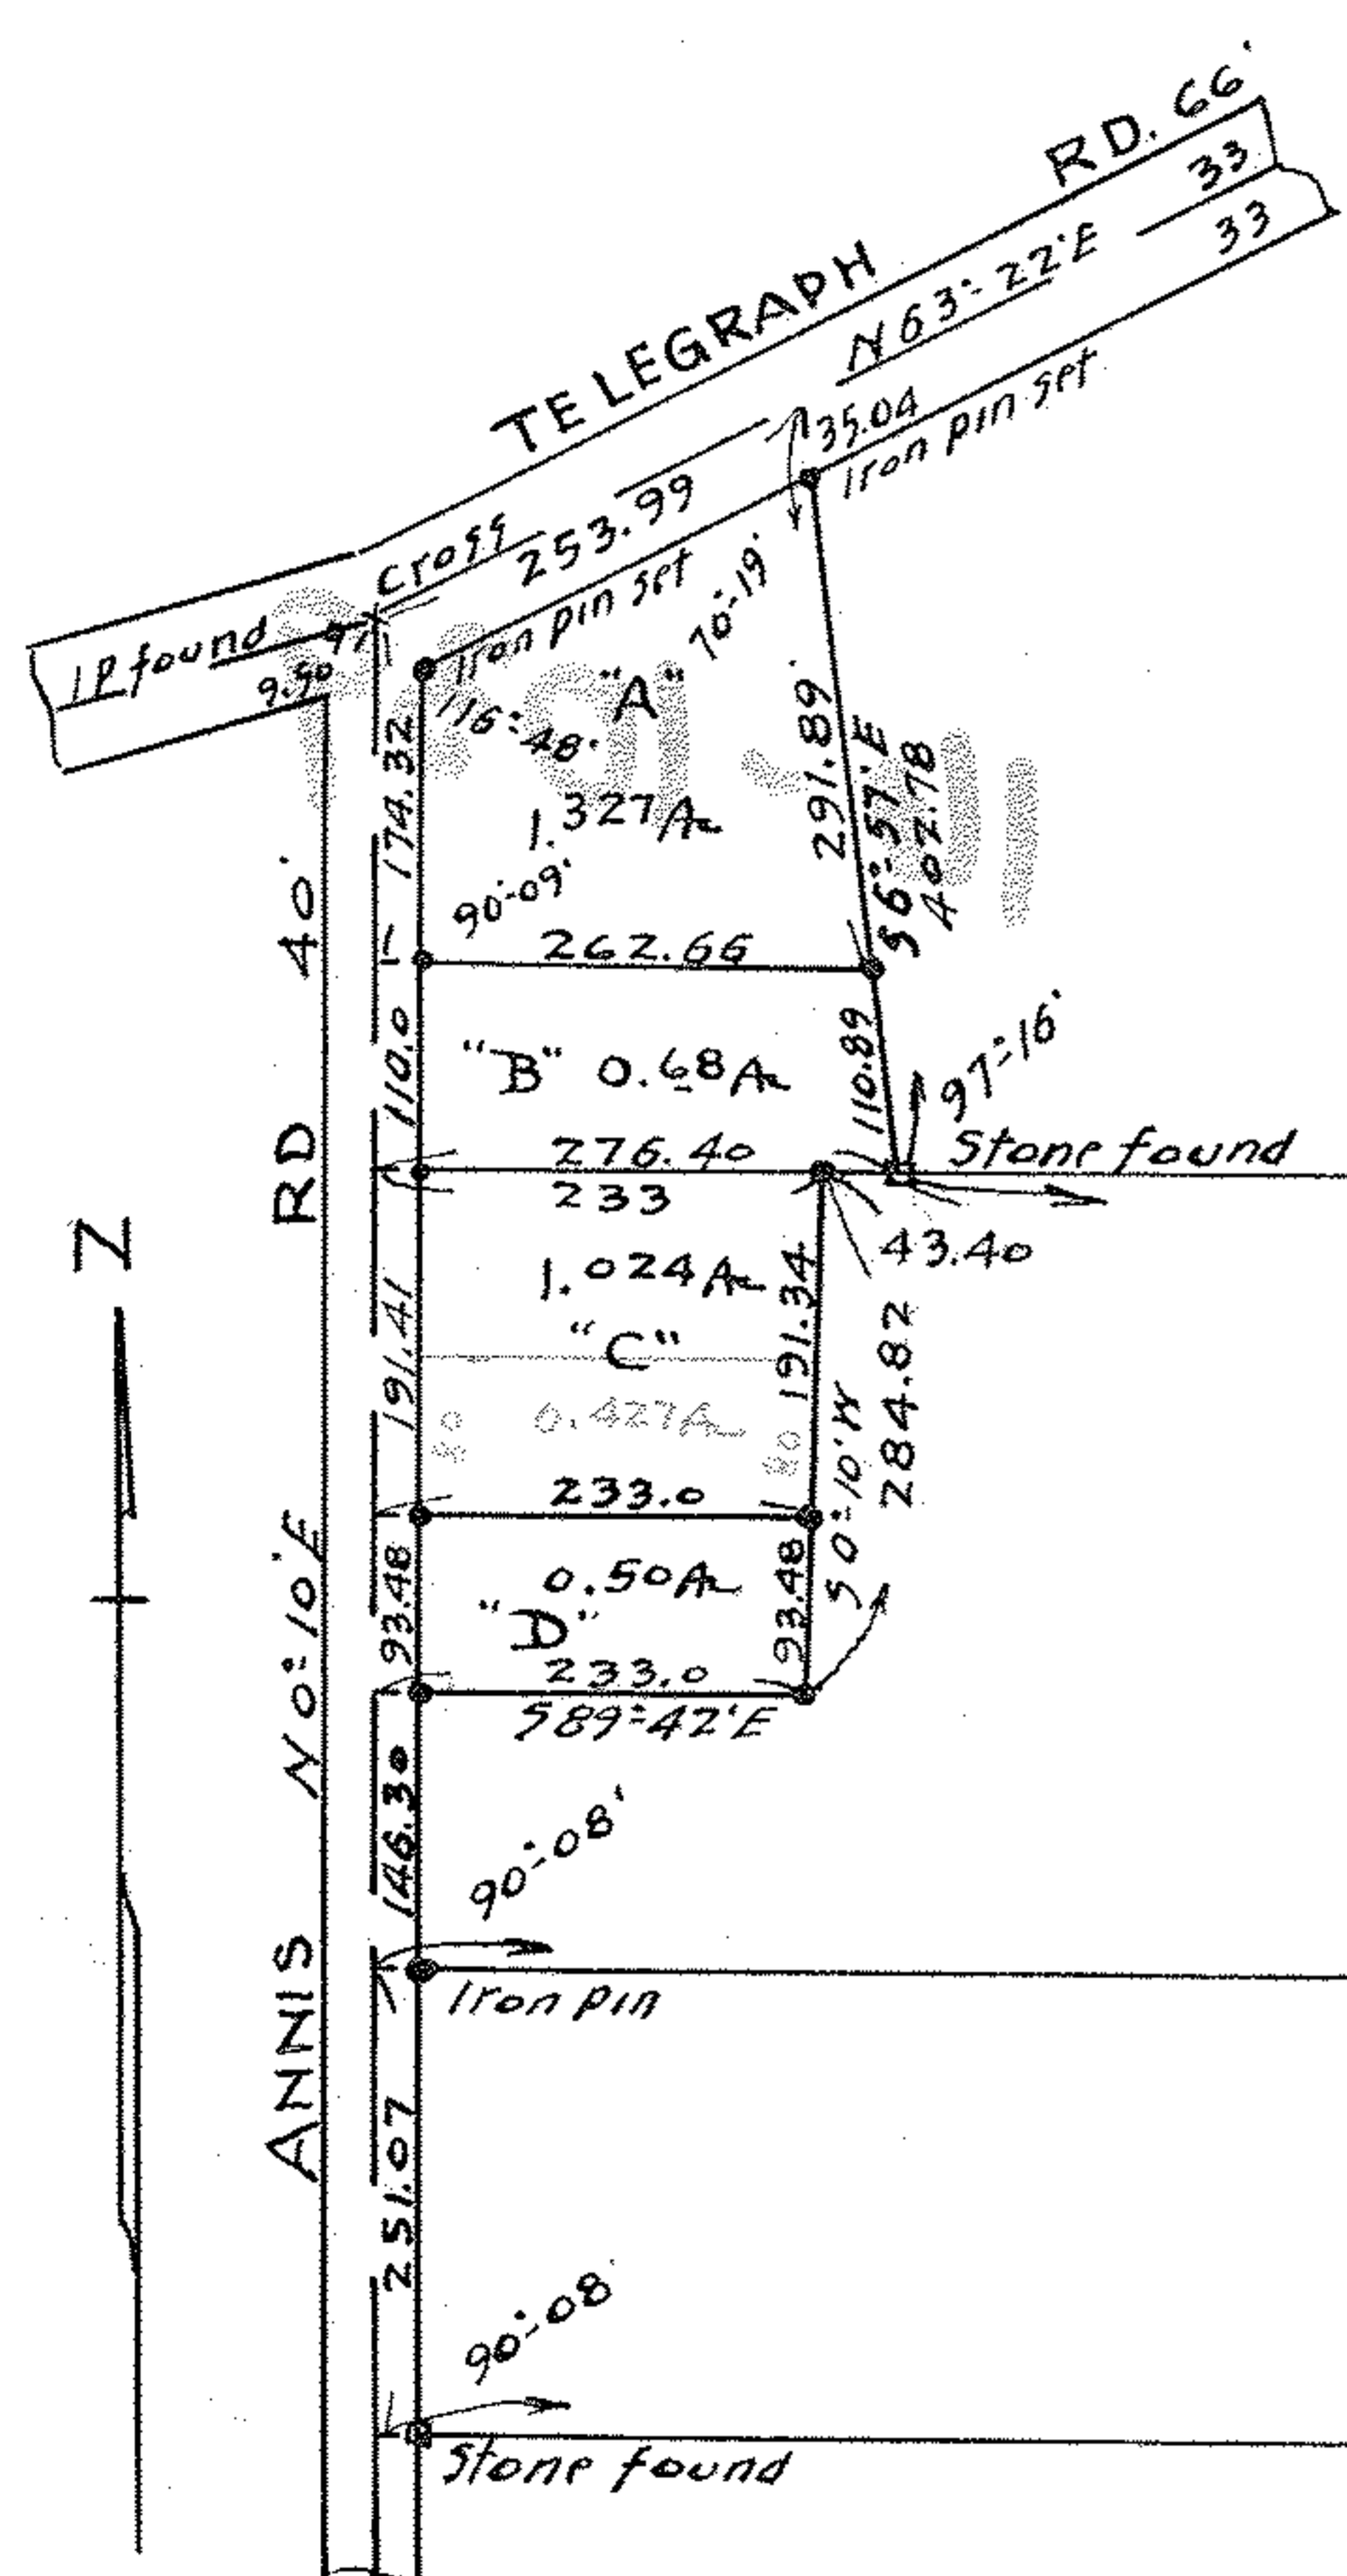

Harvey A. Rogers
 D. Vol 216 607 - Mar. 29, 1926.

Adam Szeftcyk
 D-Vol. 336-Pg. 560 Sept. 1, 1944.
 21.4464Ac exclusive of Ry.

Adam Szeftcyk
 D-Vol. 330-Pg. 243 Aug. 16, 1943.
 13.3904Ac exclusive of Ry.

Harvey L. Bassett
 D. Vol. 266 Pg. 18 - Oct. 18 1932.

Harvey A. Rogers
 D. Vol 216 607 Mar. 29 1926

- "A" = Freda M. Steel D-Vol. 337-Pg 163 Mar. 31, 1944.
- "B" = C. M. Ruth
- "C" = C. M. Ruth D-Vol. 408-Pg. 186 Jan. 4 1947
- "D" = Wm M. Annis