

J. W. WARDEN & ASSOCIATES

CIVIL ENGINEERS AND SURVEYORS


D. D. ANDRUS, PRESIDENT
405 ELYRIA BLOCK
ELYRIA, OHIO

TELEPHONES 3211
42871

M. W. JACKSON
SECRETARY

STATE OF OHIO

REGISTERED } PROFESSIONAL ENG.
SURVEYOR

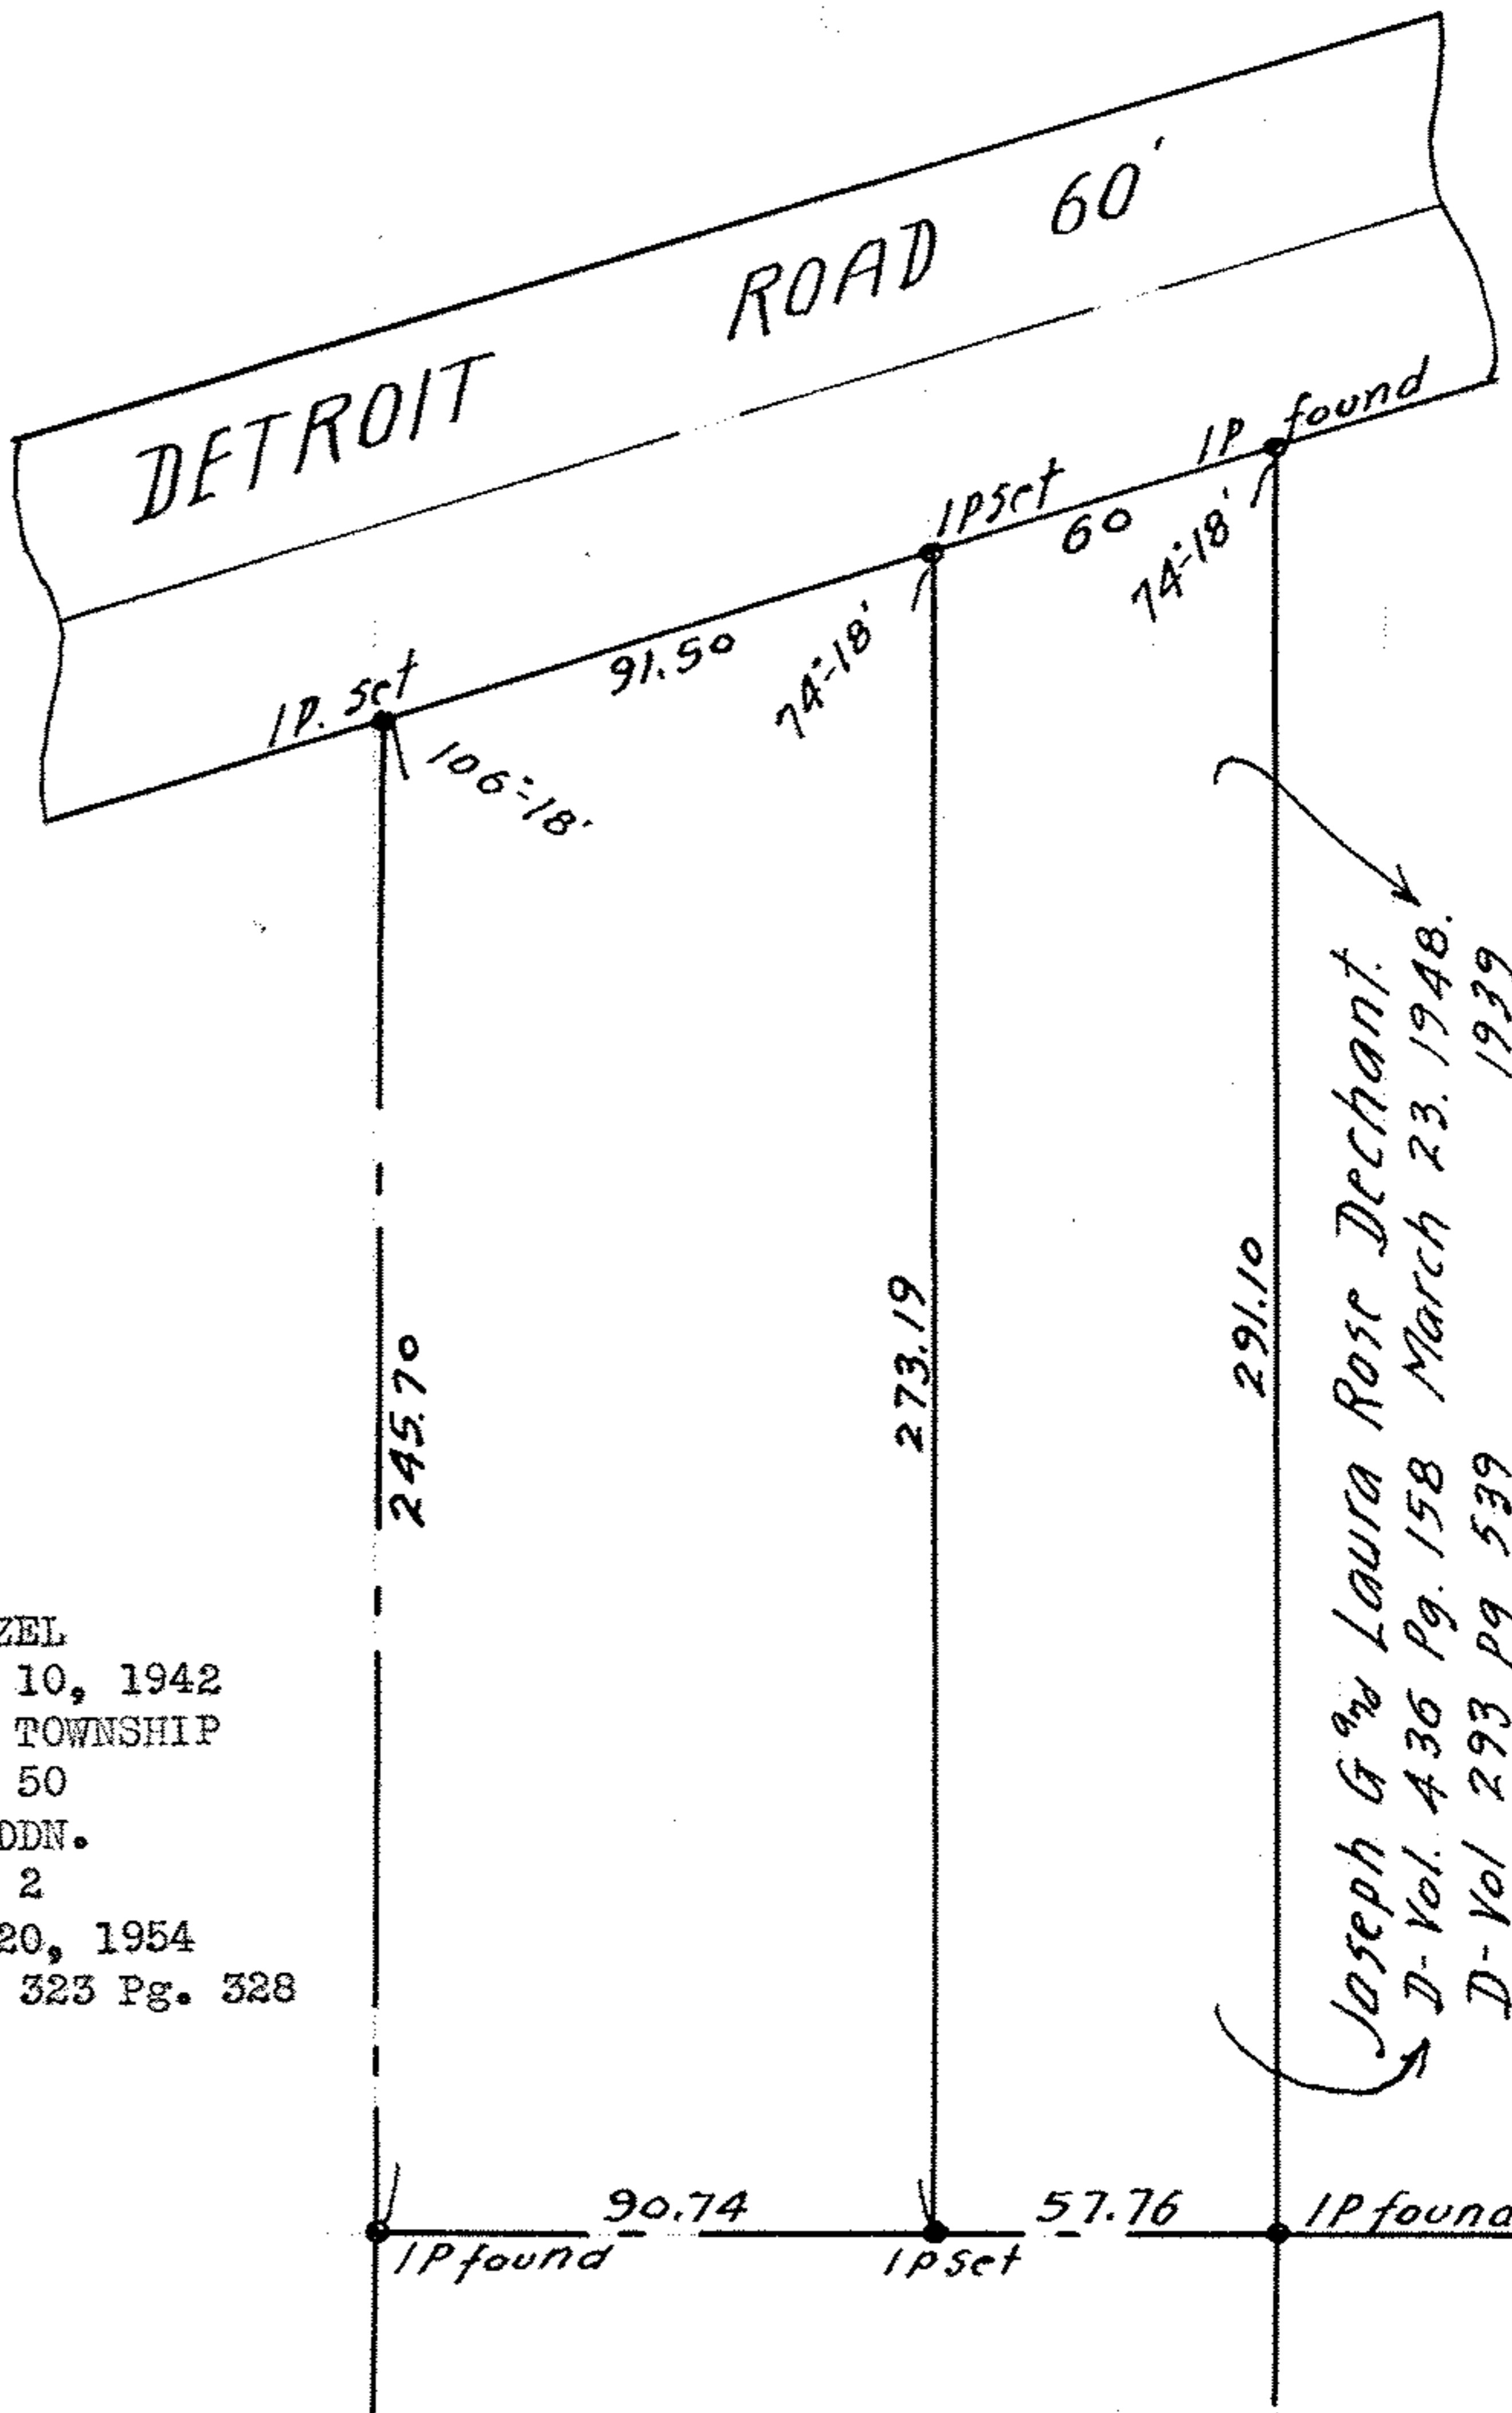

PPN 04-00-027-101-???

Map P3 04-00-027-G

SURVEY FOR
 ALBERTA BUER DETZEL
 D-VOL. 323 PG. 328 SEPT. 10, 1942
 ORIGINAL SECTION 10 AVON TOWNSHIP
 PART OF LOTS 49 & 50
 JONATHAN GIBBS ADDN.
 MAP VOL. 1 PAGE 2
 SCALE 1" = 50' MAY 20, 1954
 Original Survey of D-Vol. 323 Pg. 328
 by C. T. Biggs

Joseph G^{sr} Laura Rose Dechant.
 D-Vol. 436 Pg. 158 March 23, 1948.
 D-Vol 293 Pg 539 1939